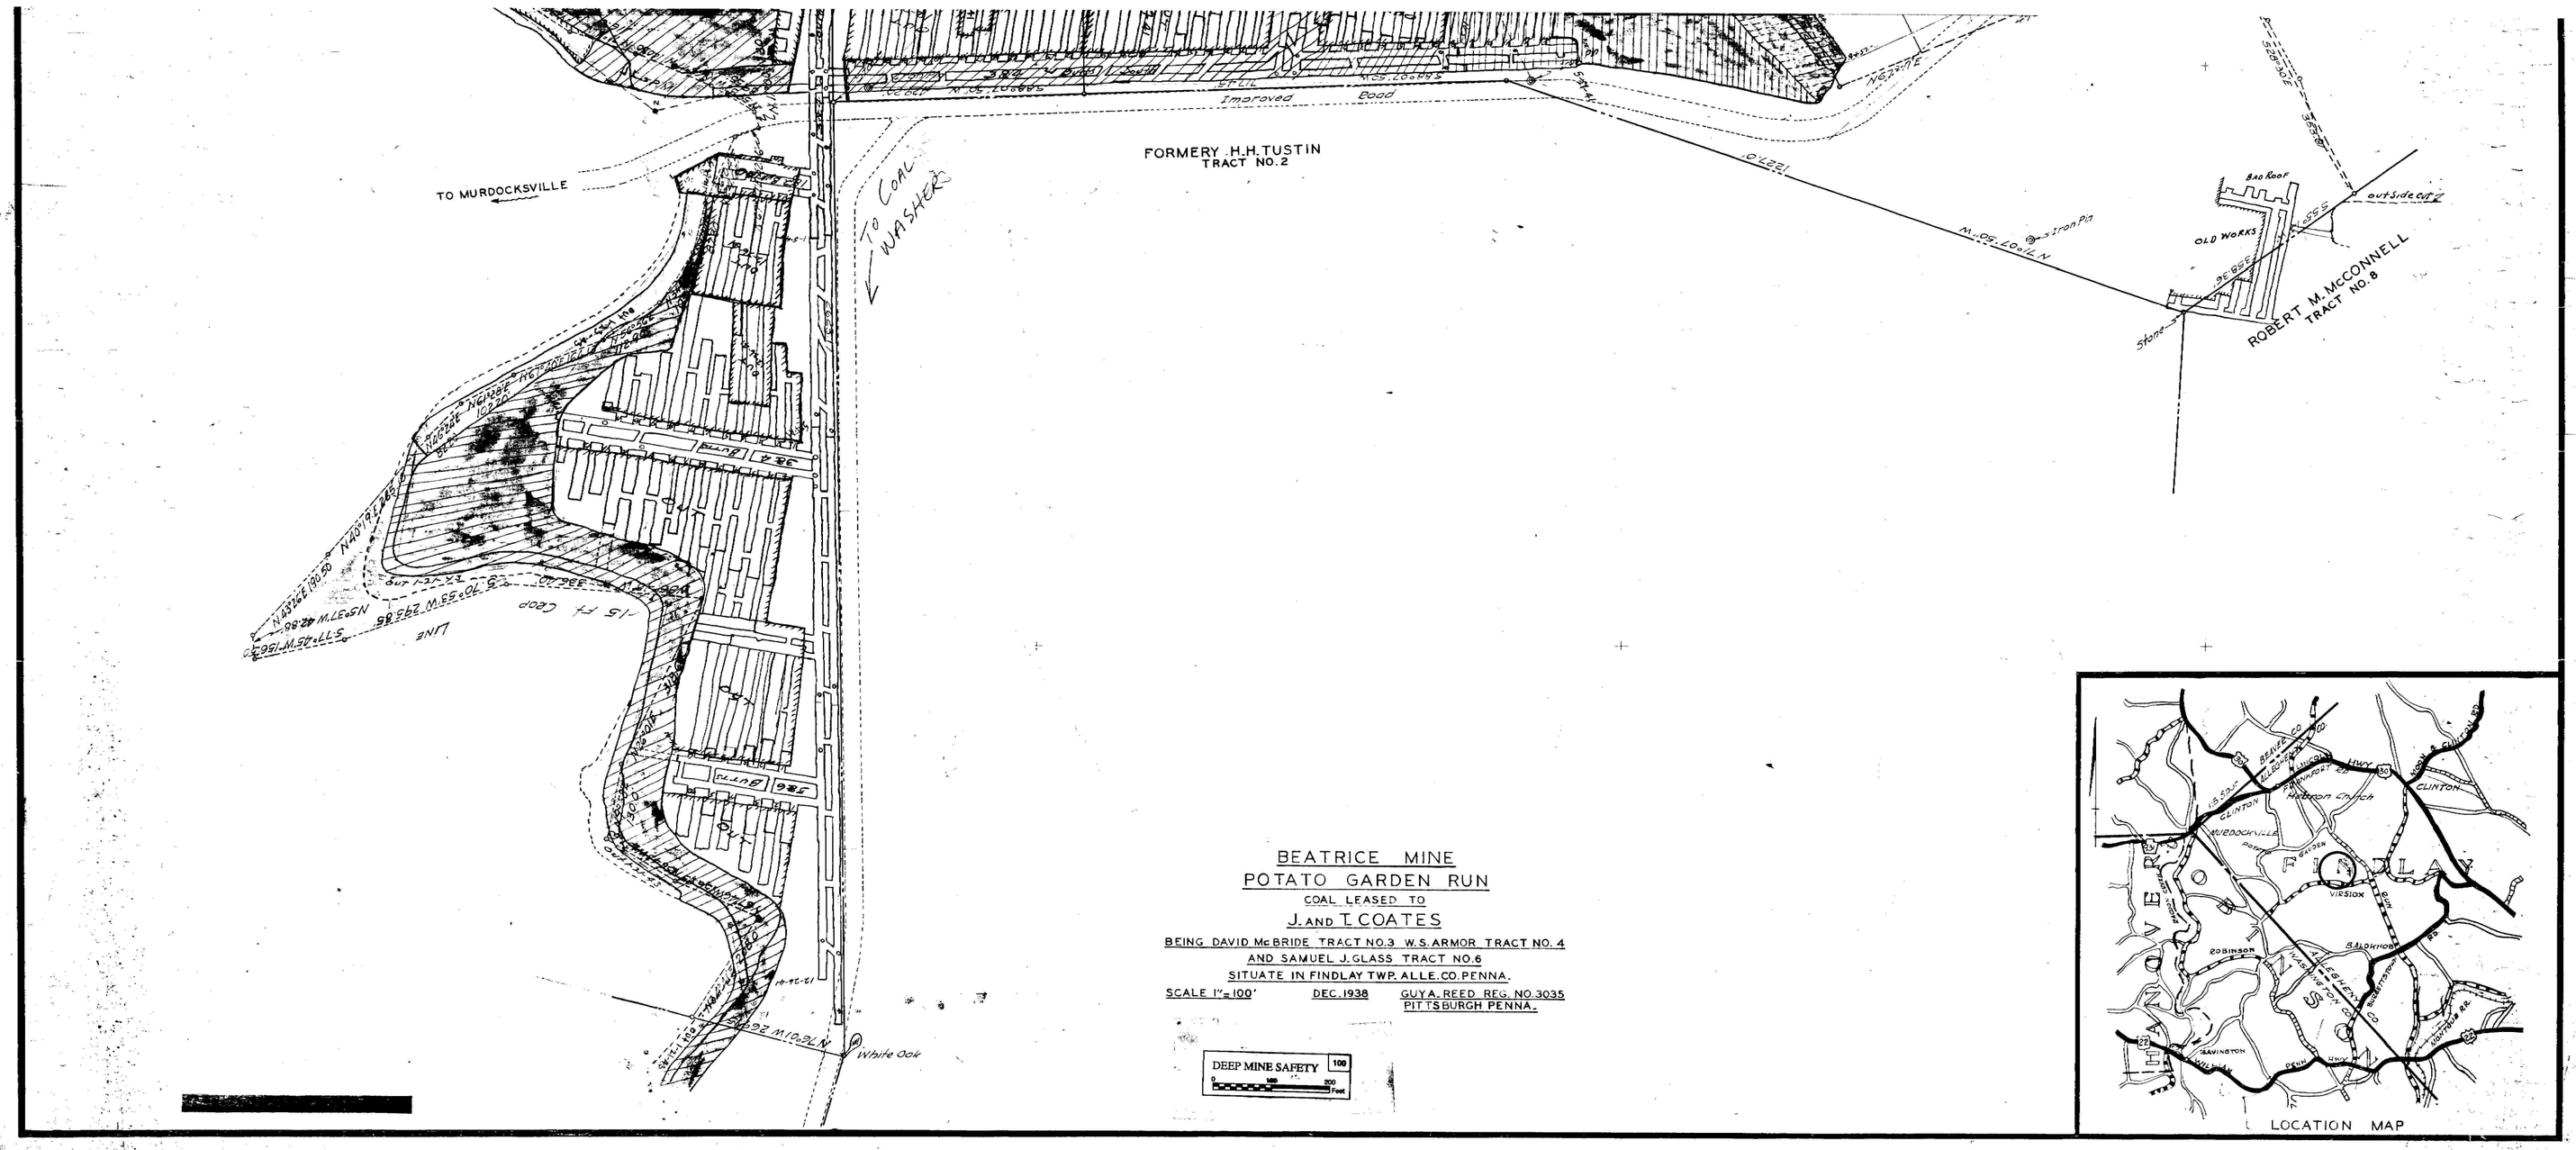
TO MURDOCKSVILLE
TO COAL WASHER
FORMERY H.H. TUSTIN
TRACT NO. 2
Improved Road
Bad Roof
OLD WORKS
outside cut
ROBERT M. McCONNELL
TRACT NO. 8
iron Pin
Stone
White Oak
BEATRICE MINE
POTATO GARDEN RUN
COAL LEASED TO
J. AND T. COATES
BEING DAVID McBRIDE TRACT NO. 3 W.S. ARMOR TRACT NO. 4
AND SAMUEL J. GLASS TRACT NO. 6
SITUATE IN FINDLAY TWP. ALLE. CO. PENNA.
SCALE 1" = 100'
DEC. 1938
GUY A. REED REG. NO. 3035
PITTSBURGH PENNA.
DEEP MINE SAFETY
LOCATION MAP

