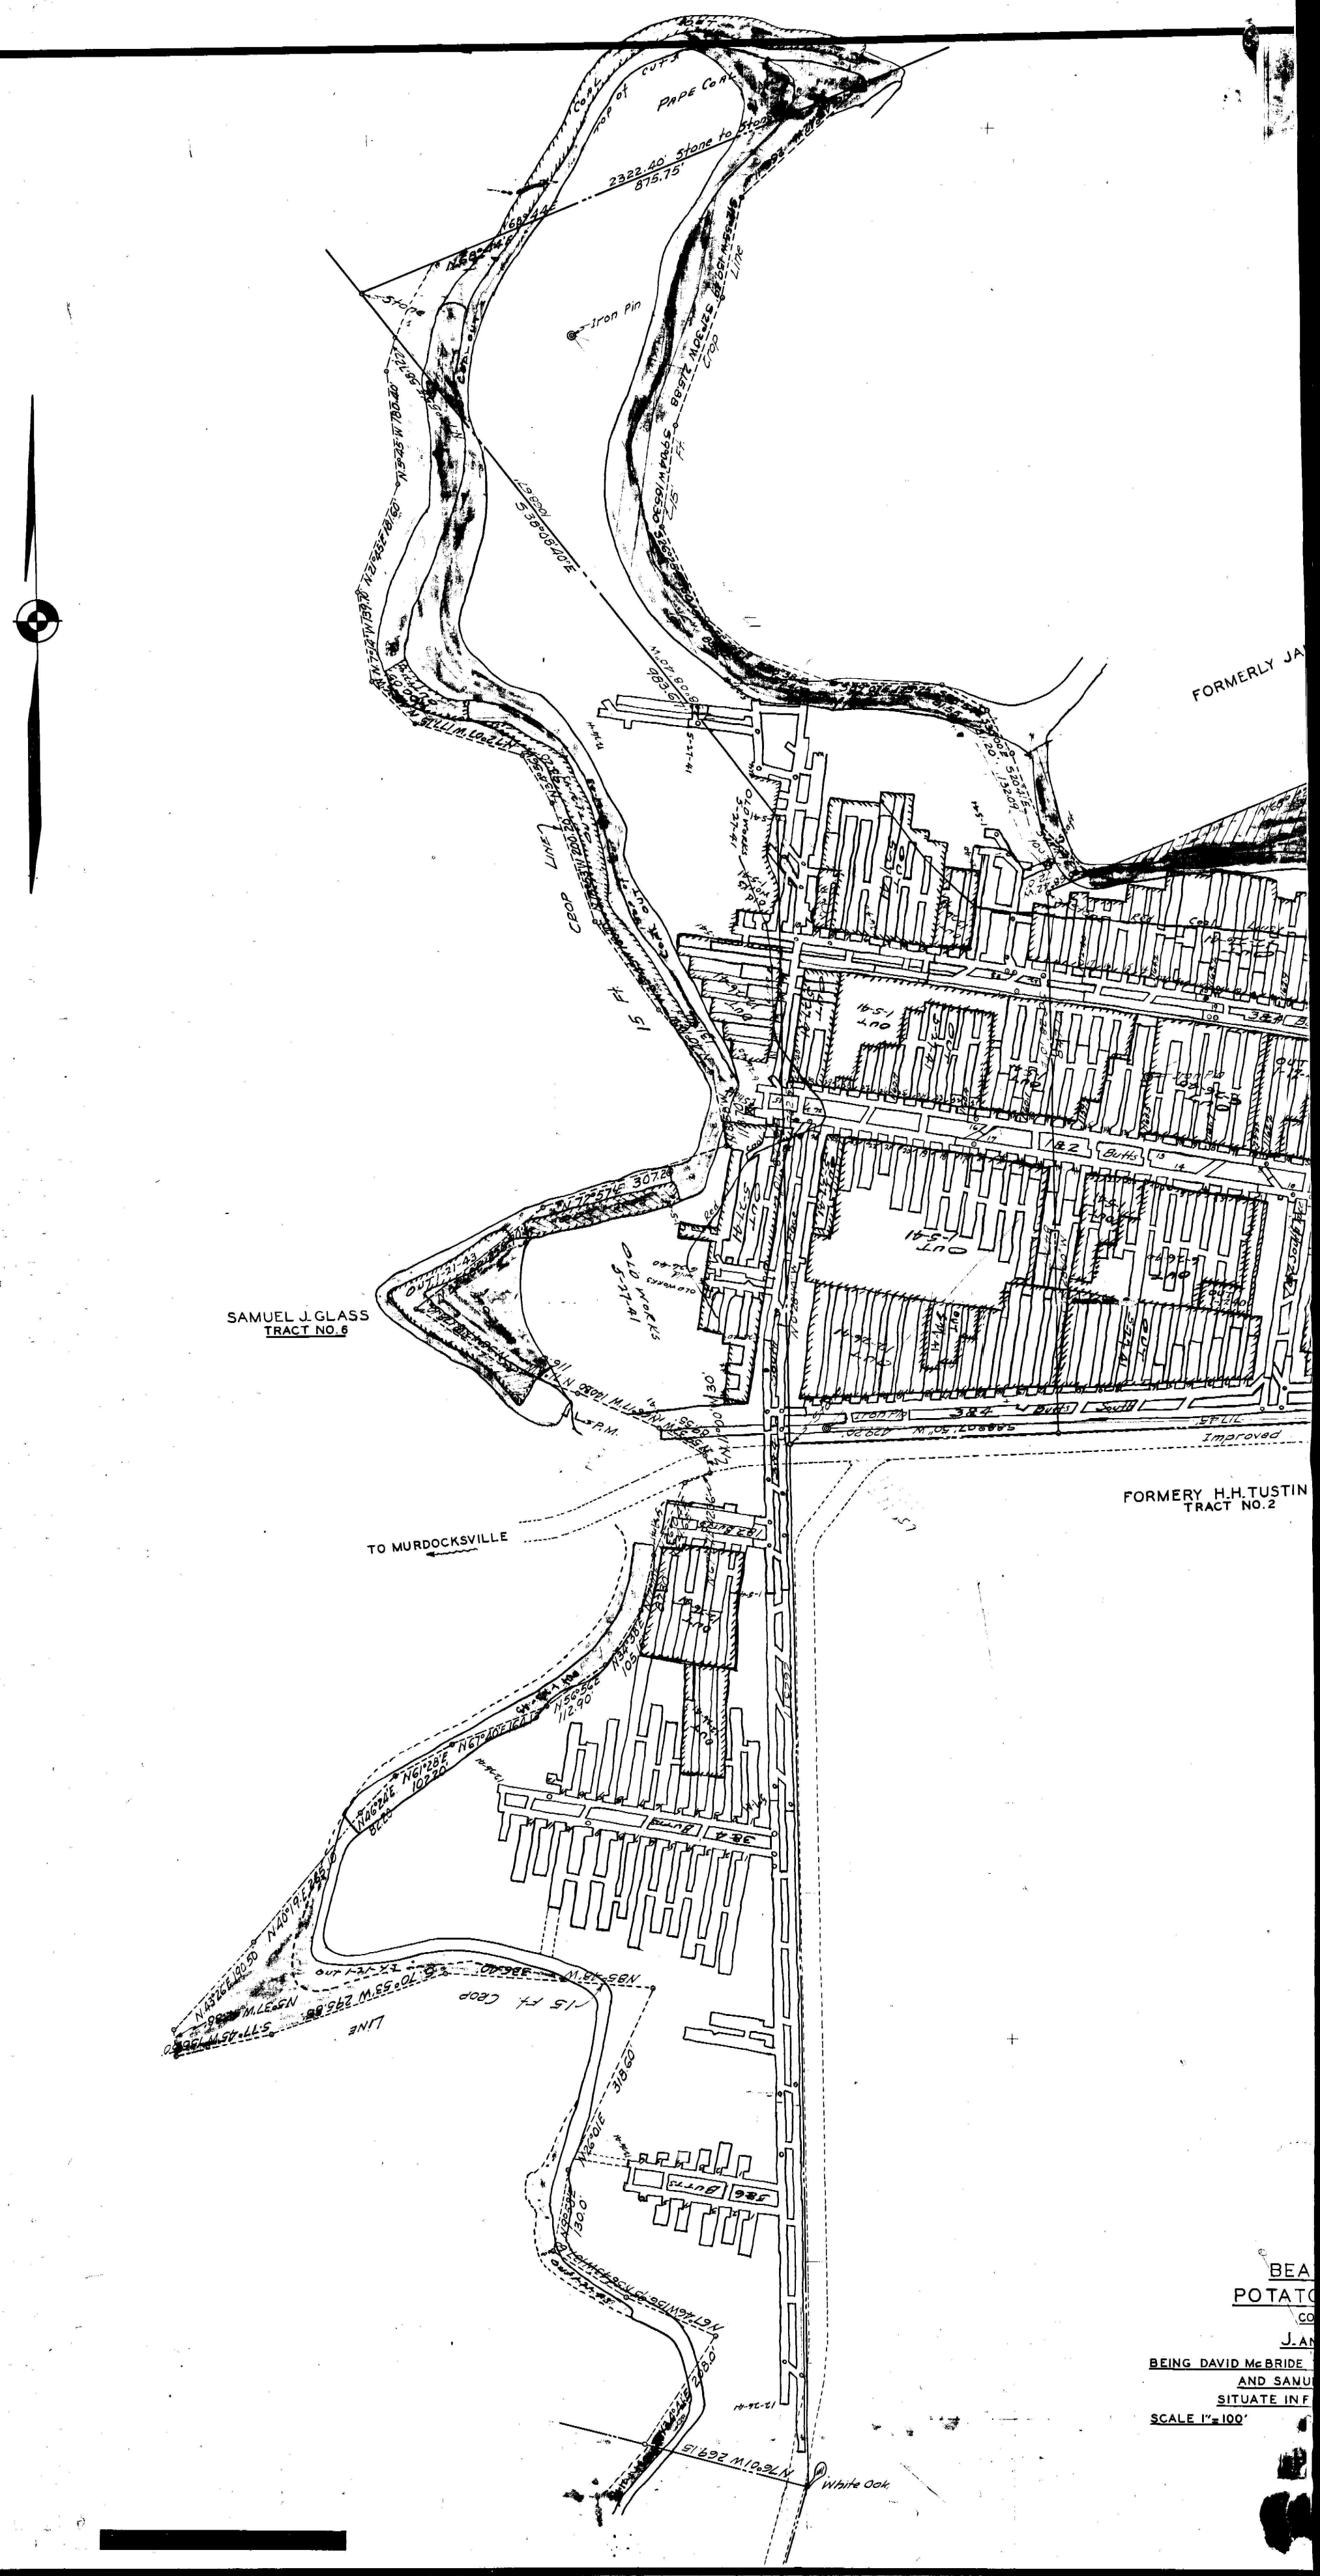
PAPE CO.
Top of cut
2322.40' Stone to Stone
875.75'
Iron Pin
Stone
FORMERLY JA
SAMUEL J. GLASS
TRACT NO. 6
TO MURDOCKSVILLE
FORMERY H.H. TUSTIN
TRACT NO. 2
Improved
Butts
White Oak
BEA
POTATO
J. AN
BEING DAVID McBRIDE
AND SANU
SITUATE IN F
SCALE 1" = 100'