Final Mine Map

RoxCOAL, INC., Long T Permit
Permit #56911302, MSHA ID#36-03248
LONGVIEW MINE/DIAMOND T MINES 1 & 2
LOWER AND MIDDLE KITTANNING SEAMS
Stonycreek Township, Somerset County, PA
Scale: 1"= 200' Date: May 3, 2003

RoxCoal, Inc.
P.O. Box 149
Friedens, PA 15541

Seal

Sheet Index

Sheet 1

Sheet 2

COAL OWNERSHIP
(L.K. & M.K. SEAMS)
(1) F.S.S. COAL HOLDINGS,INC.
(2) BENWIND CORPORATION
(3) ELDORA LAND CORPORATION
(4) TREBEL LANDJMC

PORTAL ELEVATIONS

PORTAL NO.	1	2	3
C SEAM	2288.8	2288.2	2287.9
B SEAM	2246.5	2246.8	2246.5

PROCEEDING EAST TO LOCATE UNDERGROUND MINES ADJACENT TO AND ABOVE THE PERMIT AREA

Lower Kittanning Deep Mine














PROCEEDING EAST TO LOCATE SURFACE MINES ADJACENT TO AND ABOVE THE PERMIT AREA

Lower Kittanning, Middle Kittanning, Upper Kittanning, Upper Freeport, and Bolivinia Surface Mine

PBS Coals, Inc. Diamond T Pit (Lot 3) - Completed.
PBS Coals, Inc. Diamond T Pit (Lot 3) - Completed. Map prepared by PBS Coals, Inc. field engineers.

Lower Kittanning Surface Mine

Fox Coal Co. Inc. Diamond Park Mine - Completed.
Unknown Mine. Map provided by Kaylor Co. The adjacent owner.

Jack E. Kaylor Company Diamond Park - Completed.
Jack E. Kaylor Company Diamond Park. Map provided by Kaylor Co. The adjacent owner.

Anthony Mines, Inc. Mine #1 Area of Lot - Completed.
Anthony Mines, Inc. Mine #1 Area of Lot. Map provided by Kaylor Co.

Construction Coal Co. - Completed.
Unknown Mine. Map provided by Kaylor Co. The adjacent owner.

Middle Kittanning, Upper Kittanning & Lower Freeport Surface Mine

Anthony Mines, Inc. Mine #1 Area of Lot 3 - Completed.
Anthony Mines, Inc. Mine #1 Area of Lot 3. Map provided by Kaylor Co. The adjacent owner.

PROCEEDING EAST TO LOCATE HISTORICAL MINES ADJACENT TO AND ABOVE THE PERMIT AREA

Lower Kittanning, Middle Kittanning, Upper Kittanning, Lower Freeport, Bakerstown, Mercer, Mercer

PBS Coals, Inc. Diamond T Pit - Completed.
PBS Coals, Inc. Diamond T Pit. Map Developed by PBS Coals, Inc. field engineers.

Other than the above mentioned mines, there are no other known mines adjacent to the Longview Mine.
The information on this map is accurate to the best of our knowledge, information, and belief as referenced herein.

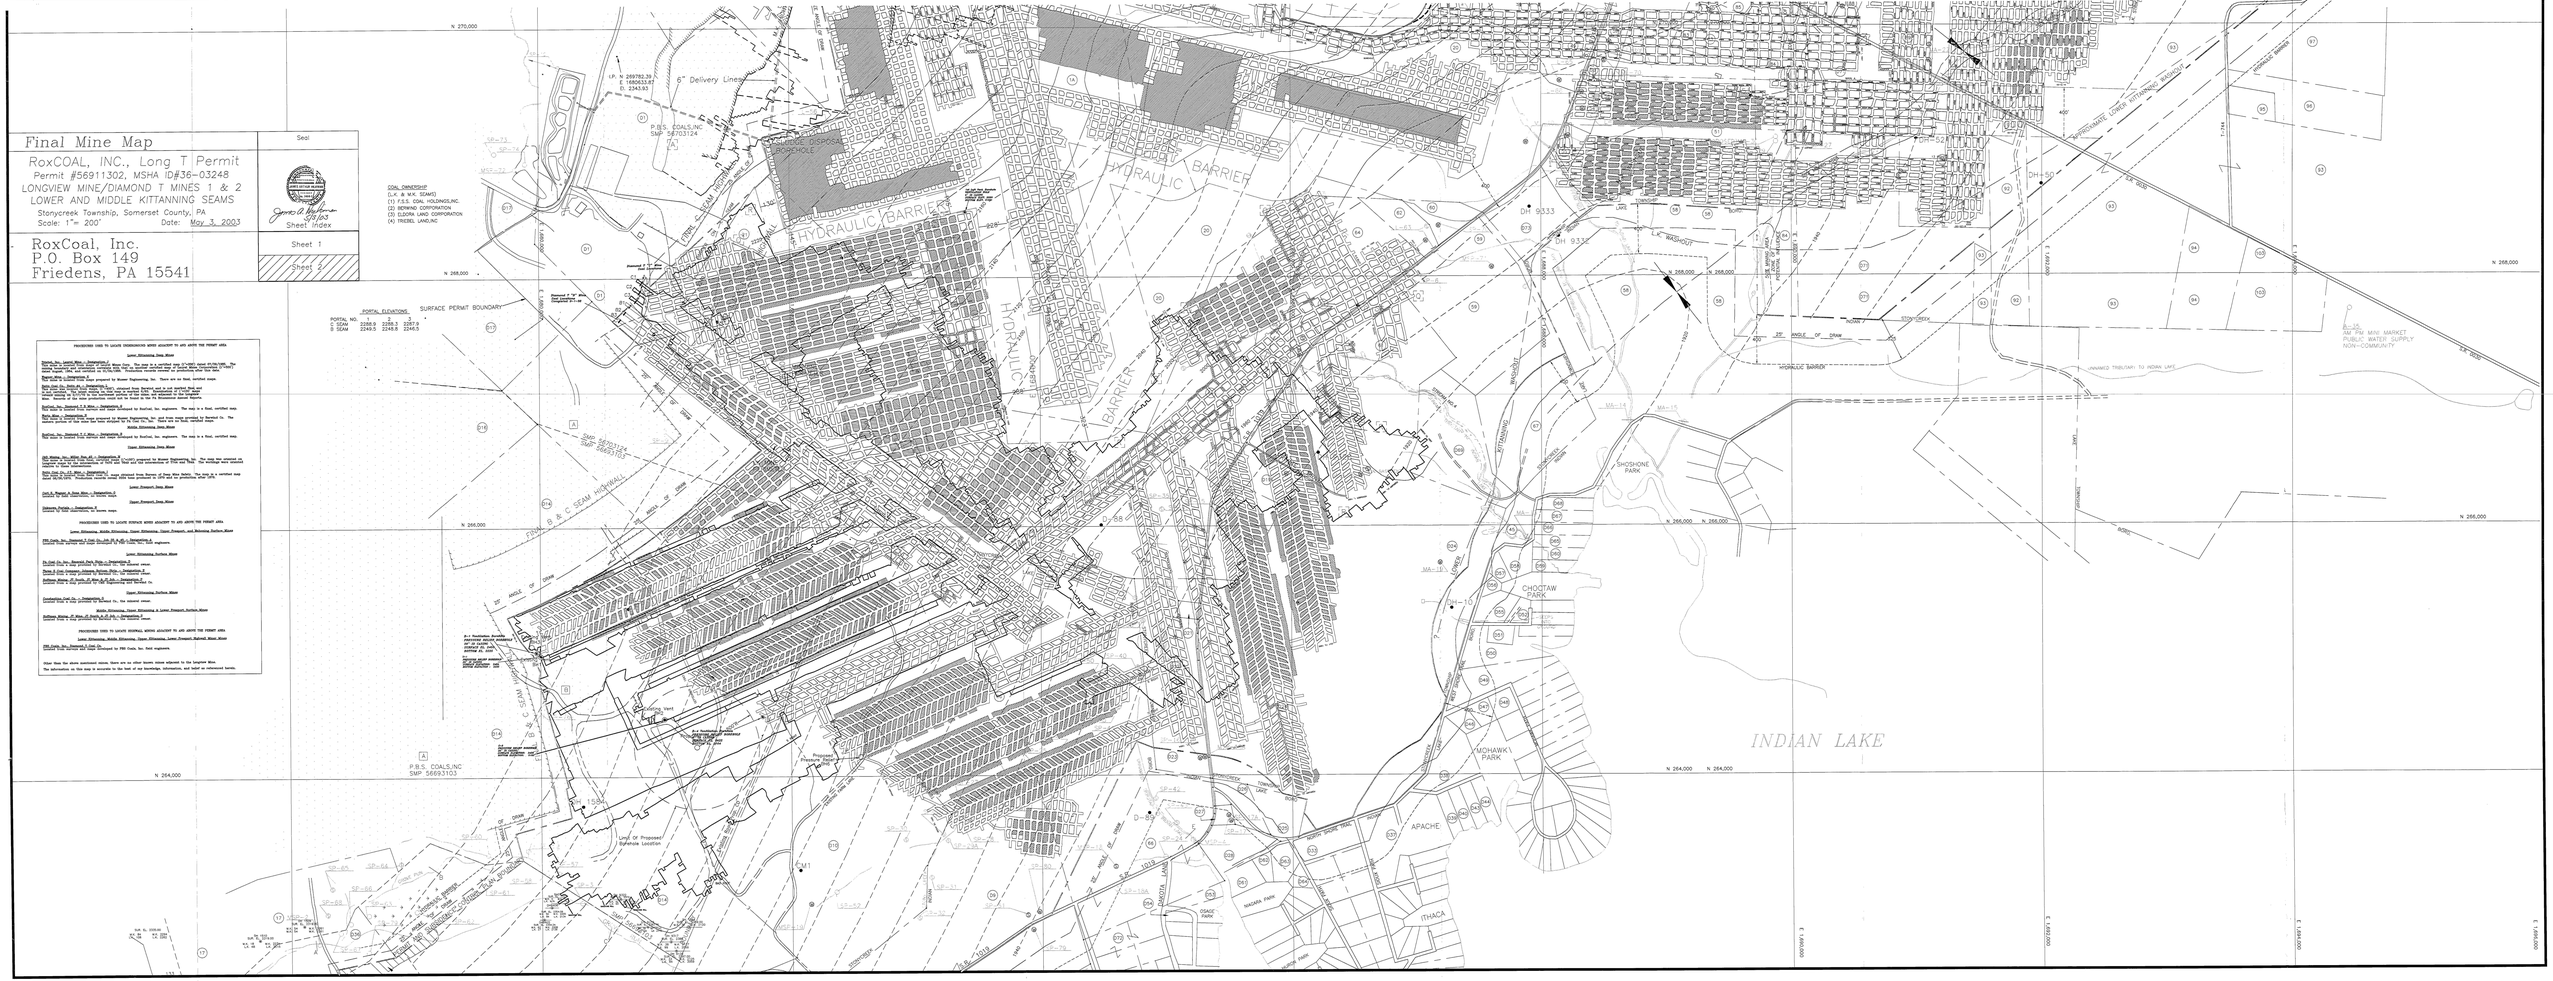
N 270,000
N 268,000
N 266,000
N 264,000
E 1,680,000
E 1,681,000
E 1,682,000
E 1,683,000
6" Delivery Line
P.B.S. COALS,INC
SMP 5870124
HYDRAULIC BARRIER
HYDRAULIC BARRIER
HYDRAULIC BARRIER
HYDRAULIC BARRIER
HYDRAULIC BARRIER
DH 9333
DH 9332
DH-52
DH-51
HYDRAULIC BARRIER
WASHOUT
STONYCREEK
UNNAMED TRIBUTARY TO INDIAN LAKE
MA-14
MA-15
MA-16
MA-10
SHOSHONE PARK
CHOCTAW PARK
"MOHAWK" PARK
APACHE
ITHACA
INDIAN PARK
OSAGE PARK
INDIAN LAKE
FRANK G & C SEAM HIGHWALL
SMP 5693103
P.B.S. COALS,INC
SMP 5669-3103
