


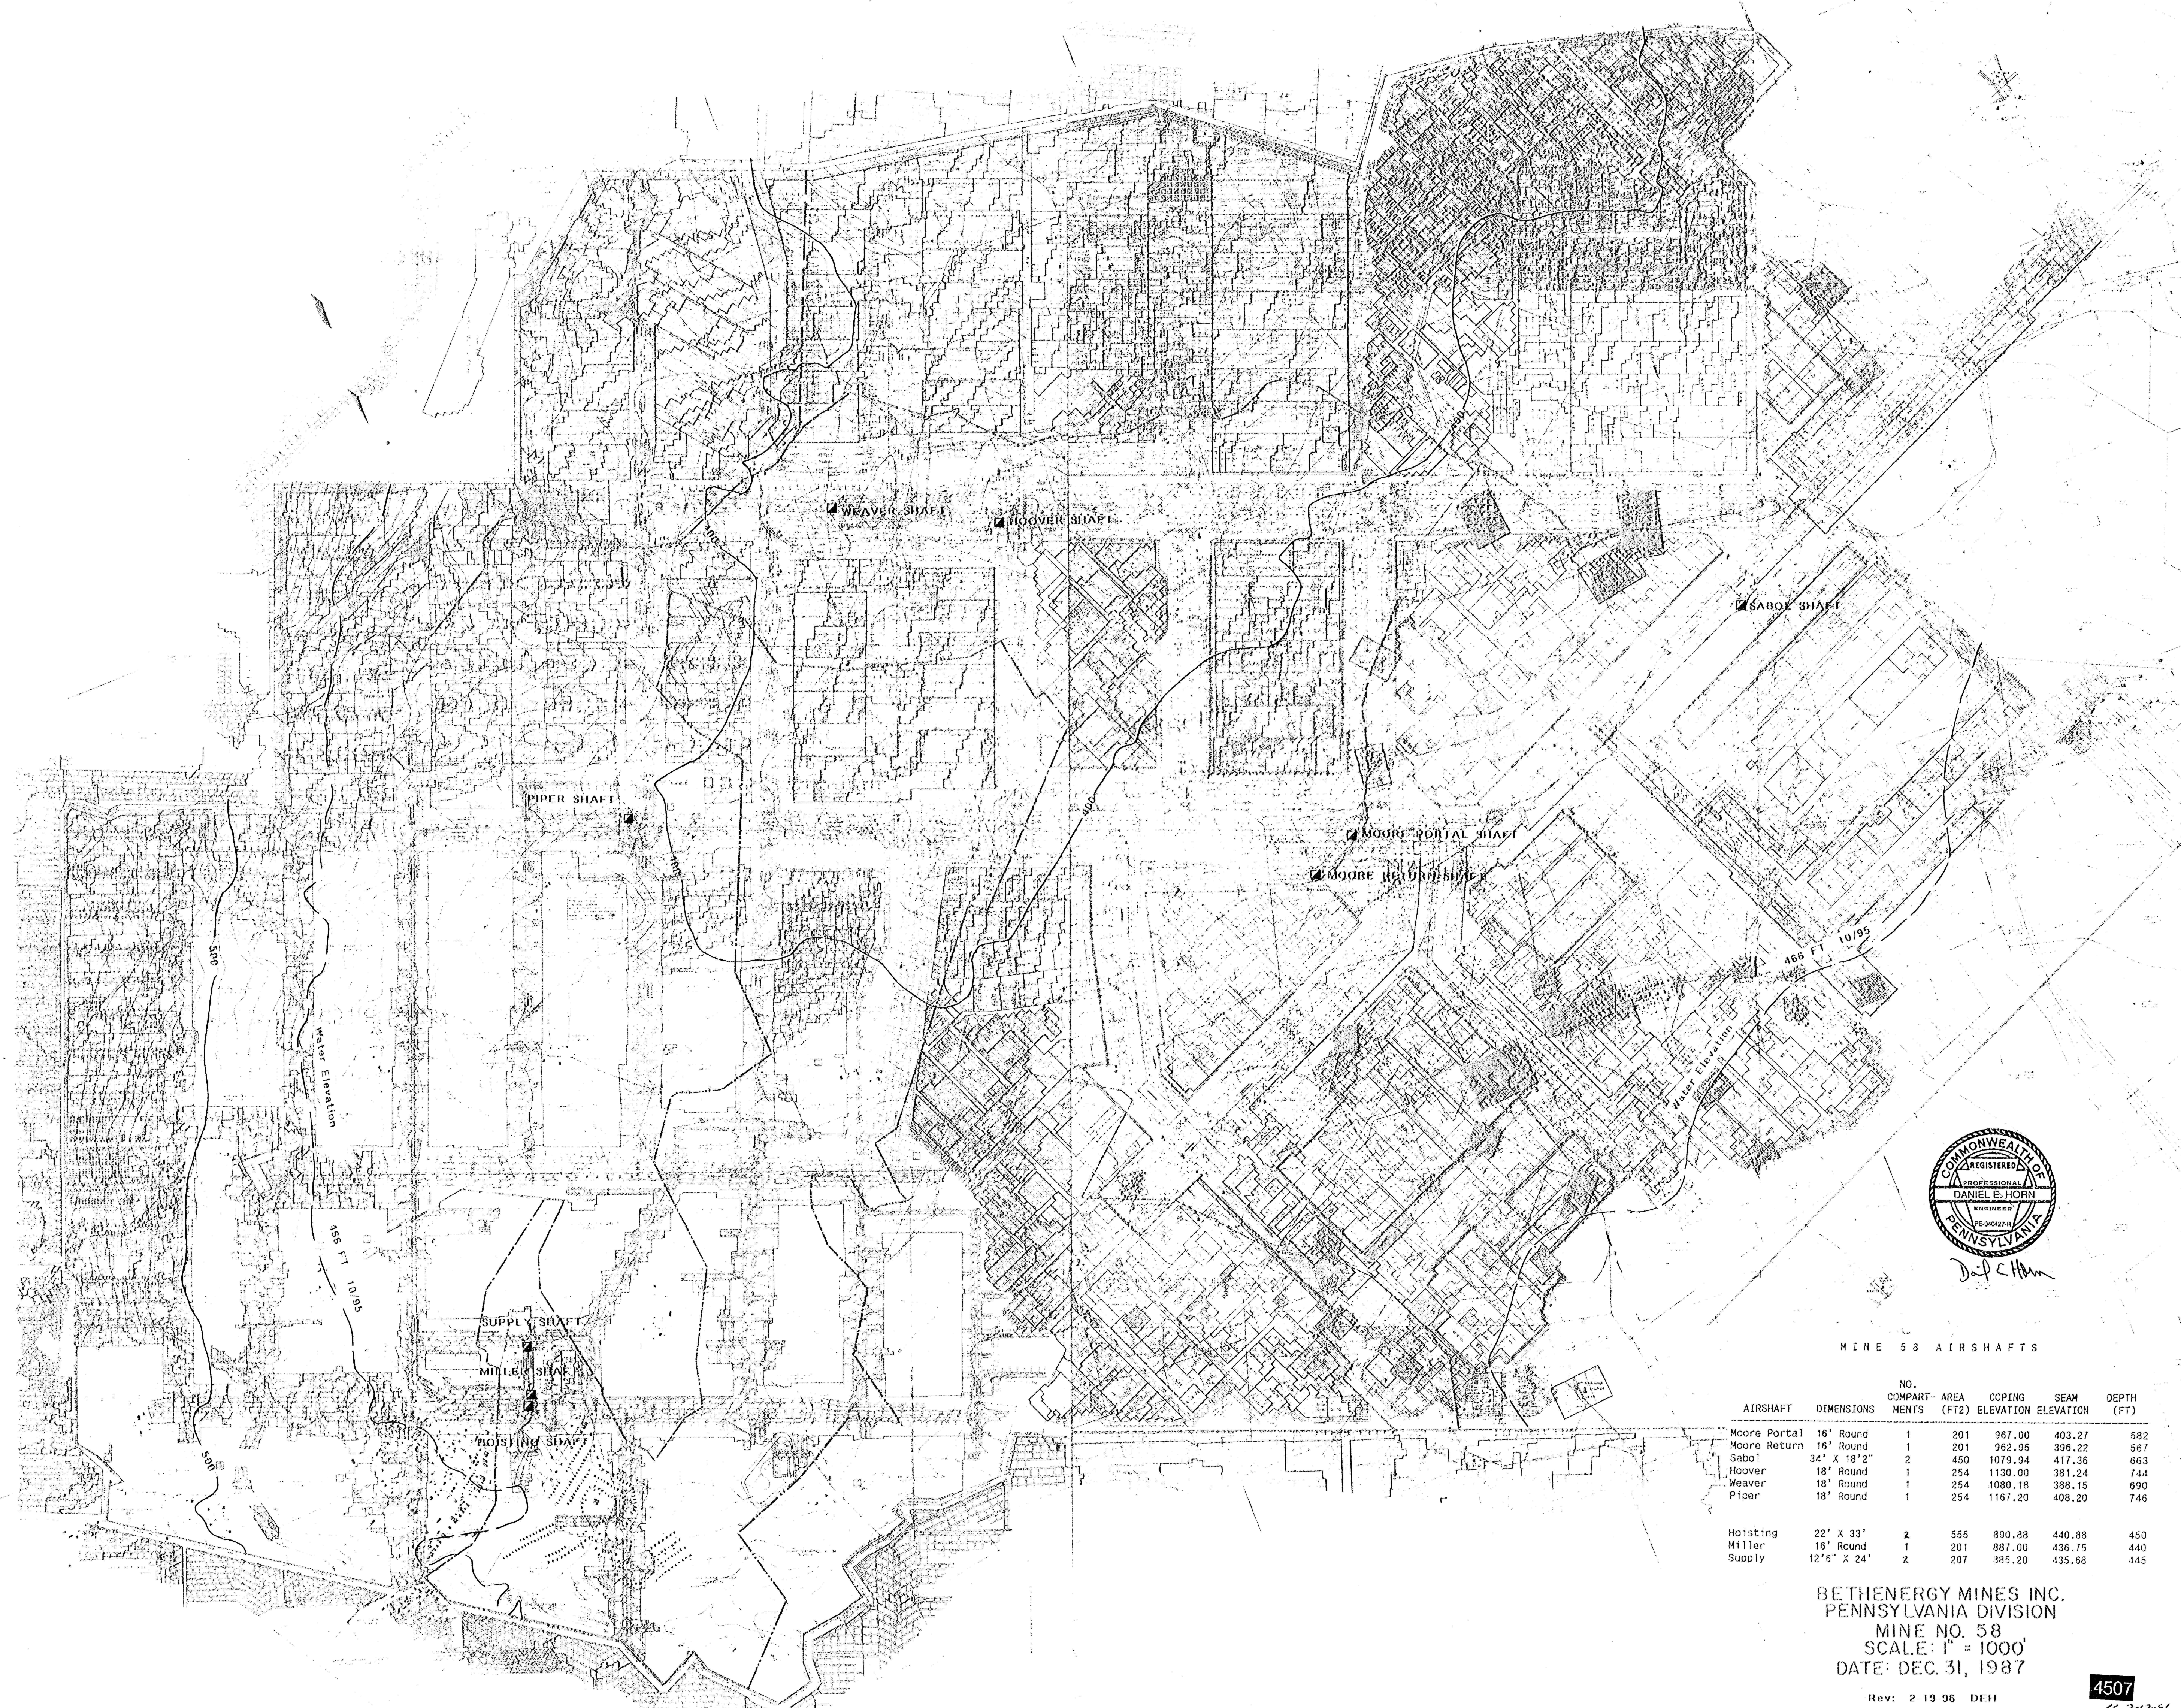

MINE 58 AIRSHAFTS

AIRSHAFT	DIMENSIONS	NO. COMPARTMENTS	AREA (F ²)	COPING ELEVATION	SEAM ELEVATION	DEPTH (FT)
Moore Portal	16" Round	1	201	967.00	403.27	582
Moore Return	16" Round	1	201	962.95	396.22	567
Sabol	32" X 18" 2"	2	450	1079.94	417.36	663
Hoover	18" Round	1	254	1130.00	381.24	744
Weaver	18" Round	1	254	1080.18	388.15	690
Piper	18" Round	1	254	1167.20	408.20	746
Hoisting	22' X 33'	2	555	890.88	440.88	450
Miller	16" Round	1	201	887.00	436.75	440
Supply	12" 6" X 24"	2	207	885.20	435.68	445

BETHENERGY MINES INC.
PENNSYLVANIA DIVISION
MINE NO. 58
SCALE: 1" = 1000'
DATE: DEC. 31, 1987