


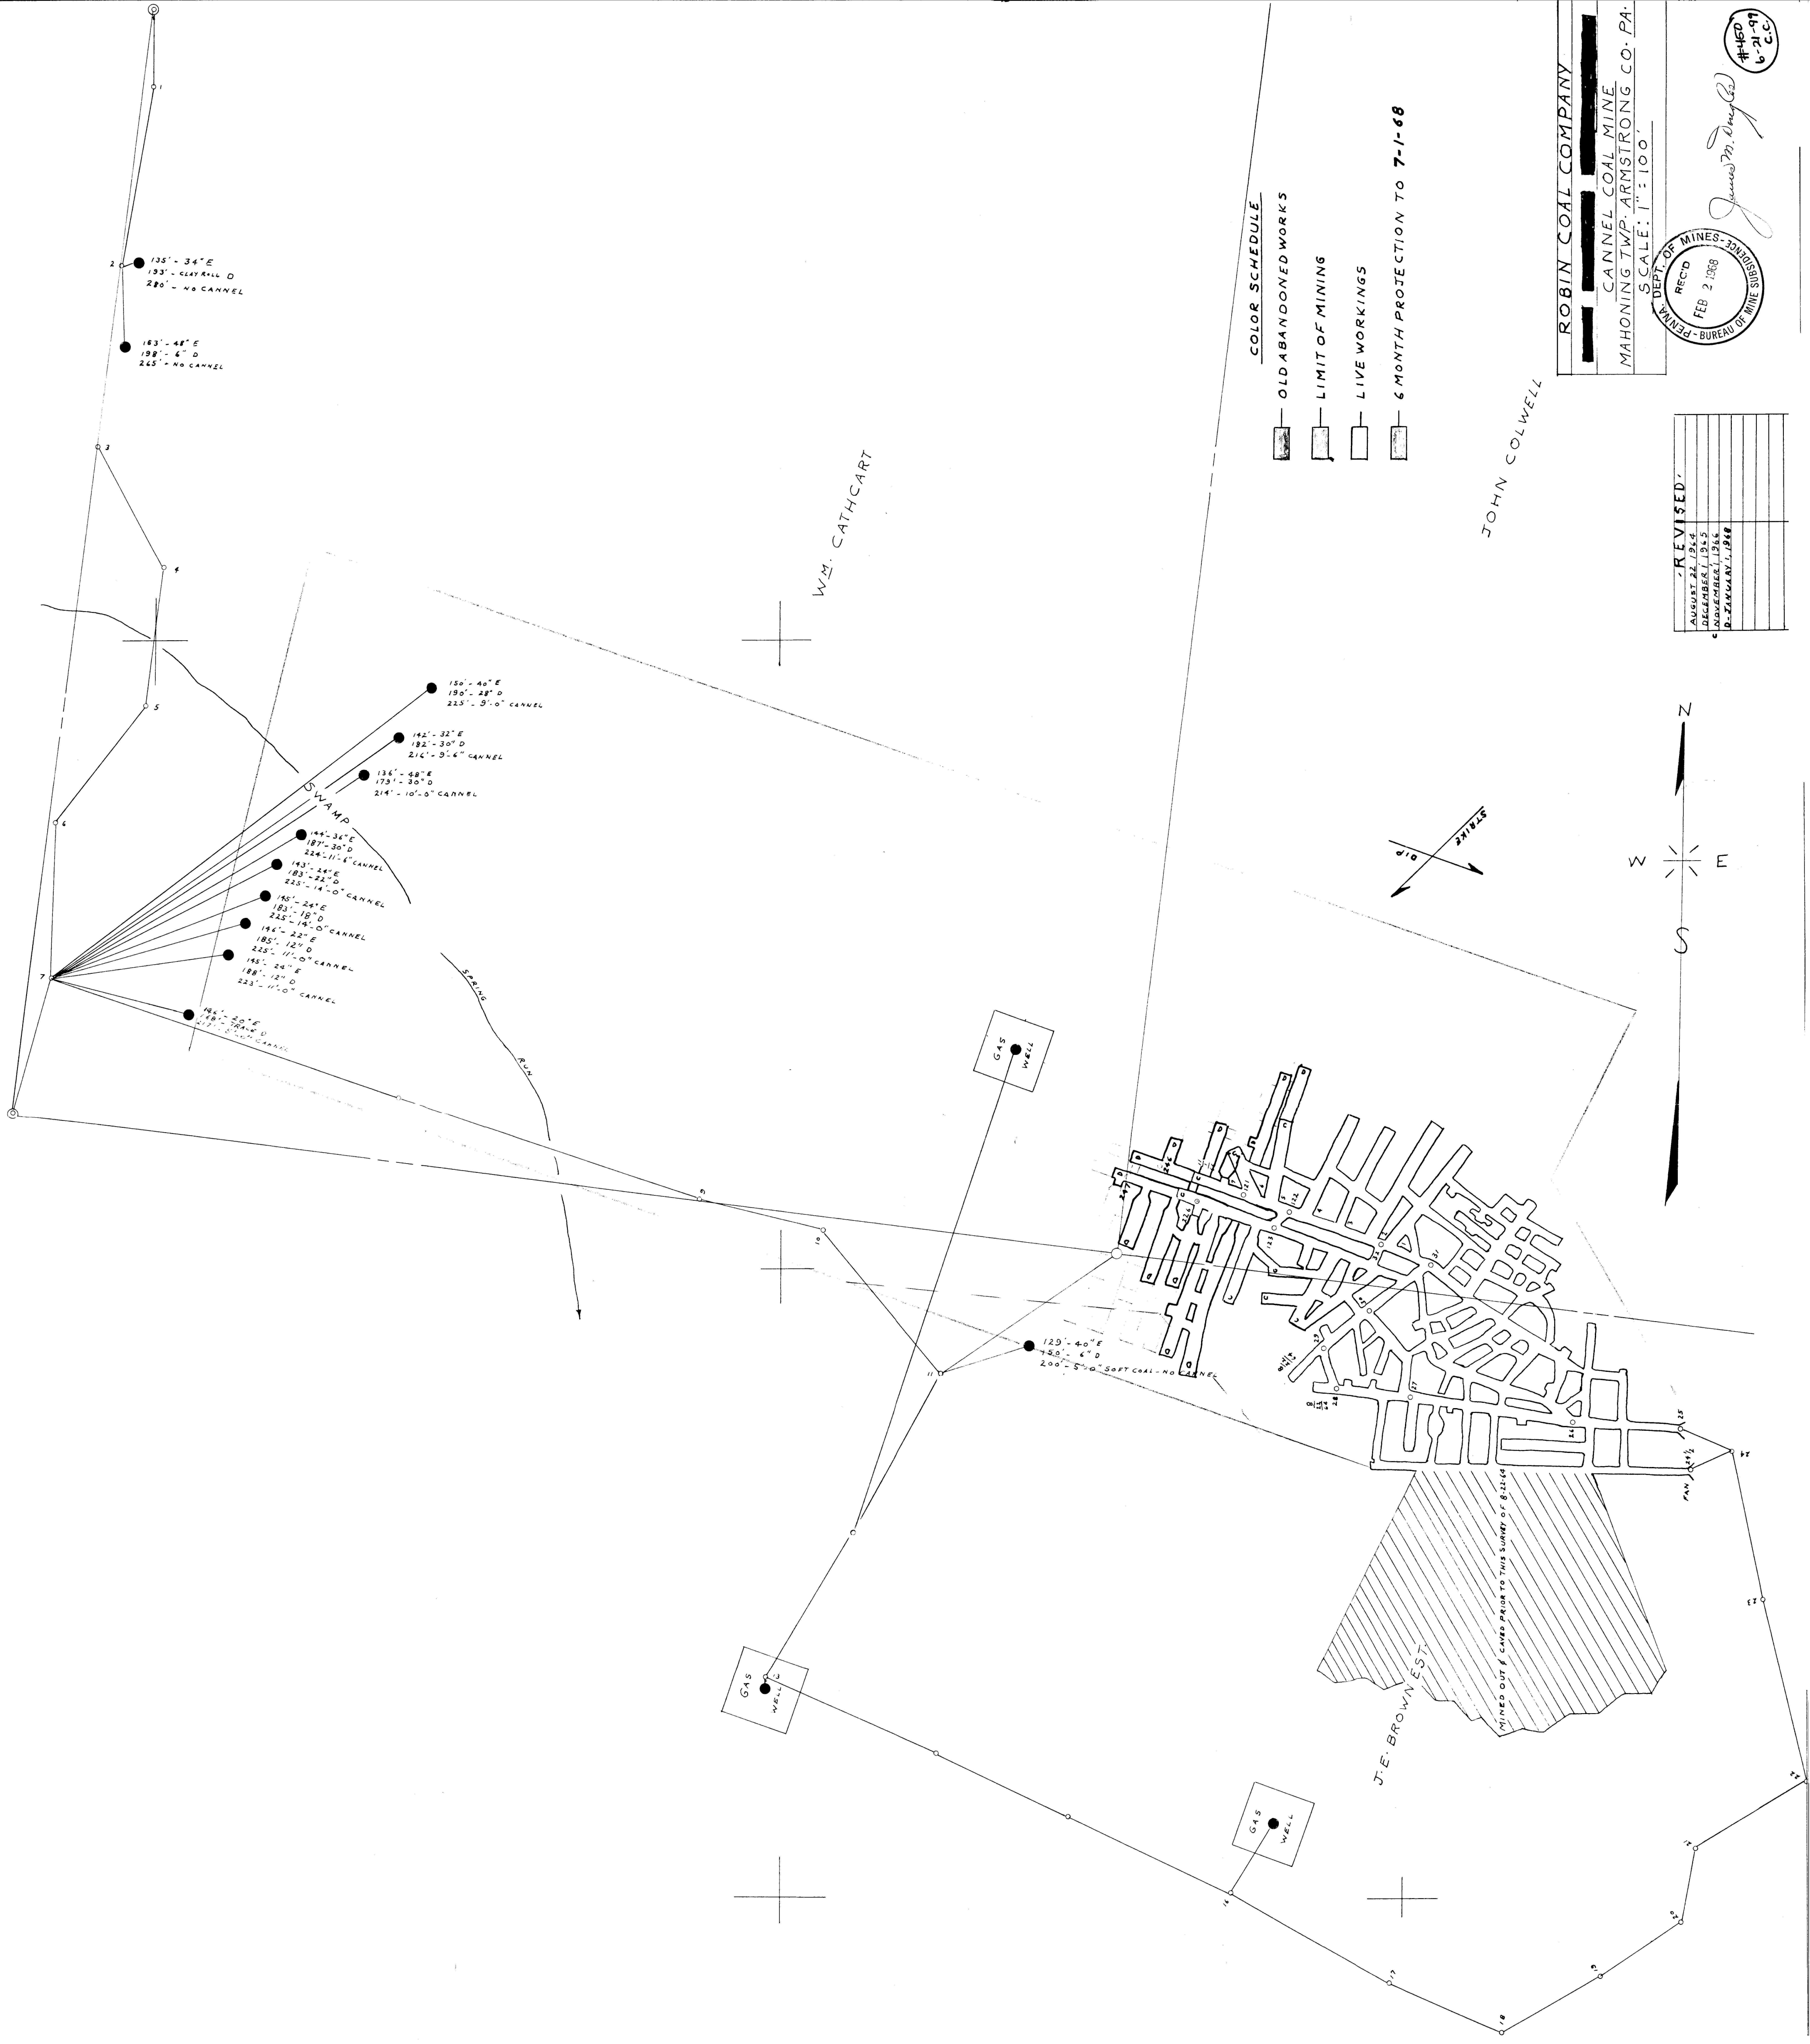

ROBIN COAL COMPANY
CANNEL COAL MINE
MAHONING TWP. ARMSTRONG CO. PA.
SCALE: 1" = 100'

REVISED	

DEPT. OF MINES - PENNSYLVANIA
RECD
FEB 2 1968
BUREAU OF MINE

6-21-97
#450
C.C.