


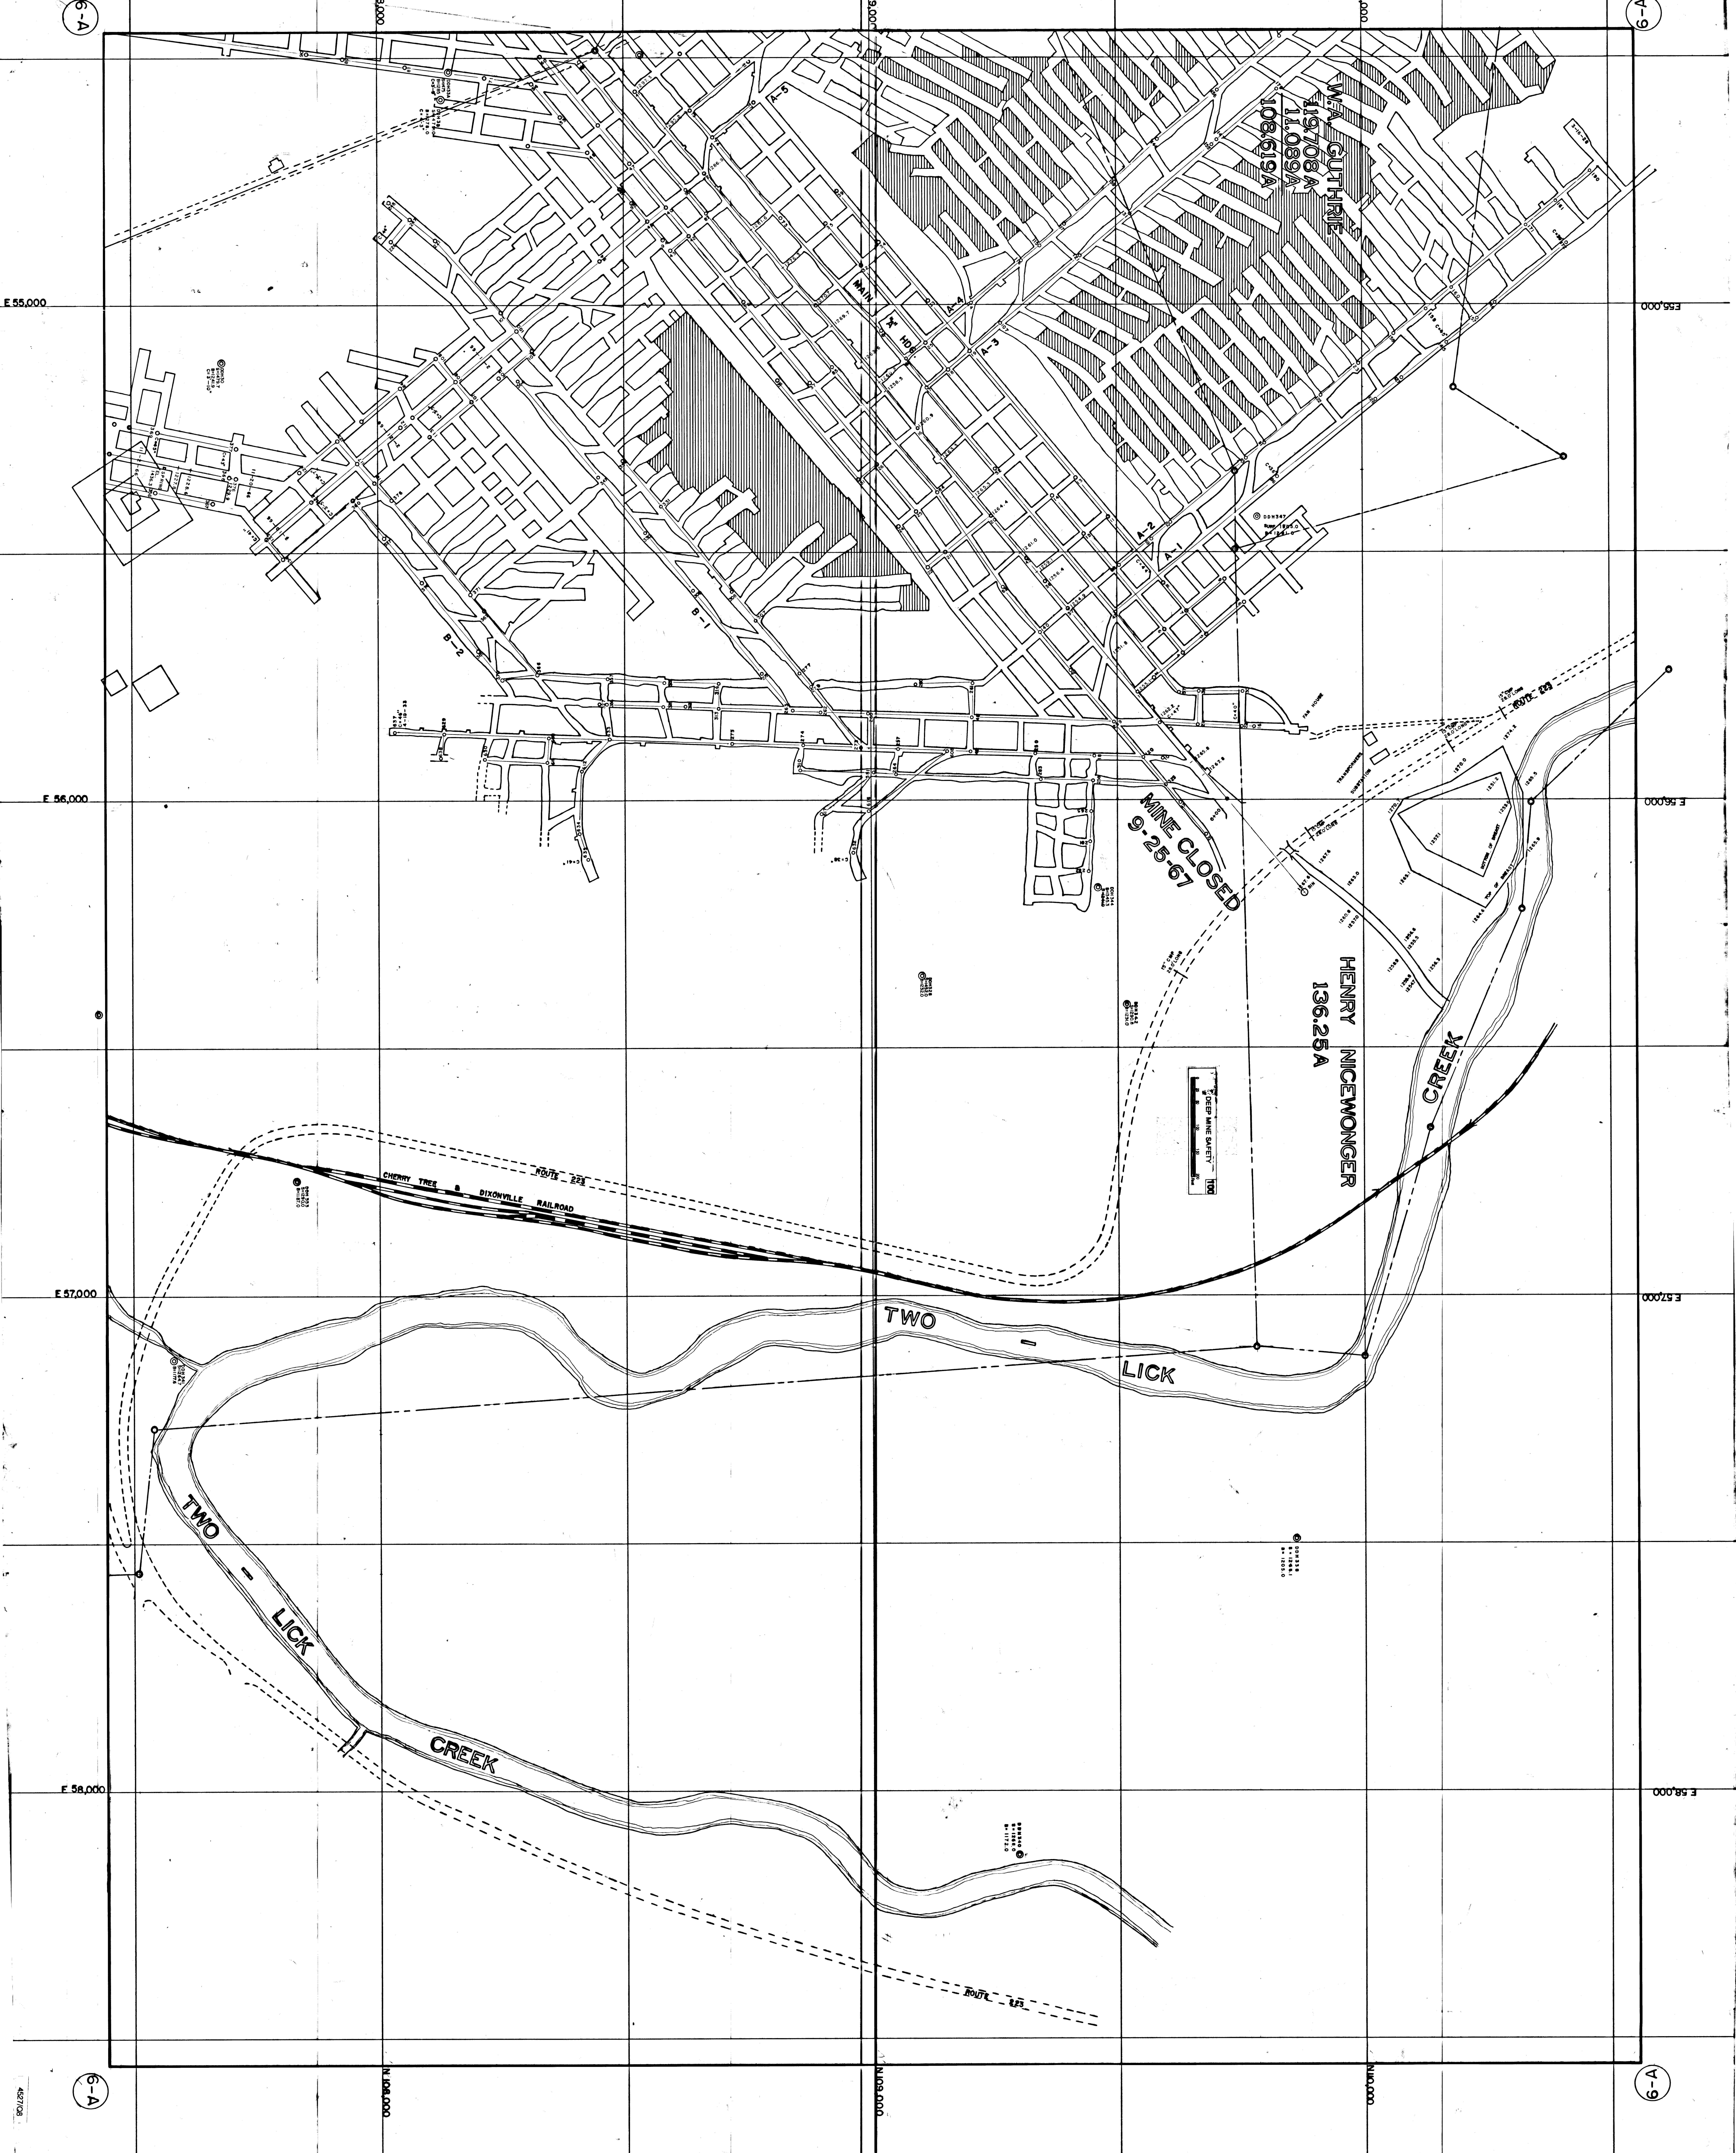

E 55,000

E 56,000

E 57,000

E 58,000

E 55,000

E 56,000

E 57,000

E 58,000

N 108,000






6-A

6-A

6-A

6-A

W.A. GUTHRIE
419,708 A
11,089 A
108,619 A

MINE CLOSED
9-25-67

HENRY
NICEWONGER
136.25 A

CREEK

TWO

LICK

TWO

LICK

CREEK


CHERRY TREE
DIXONVILLE
RAILROAD

