


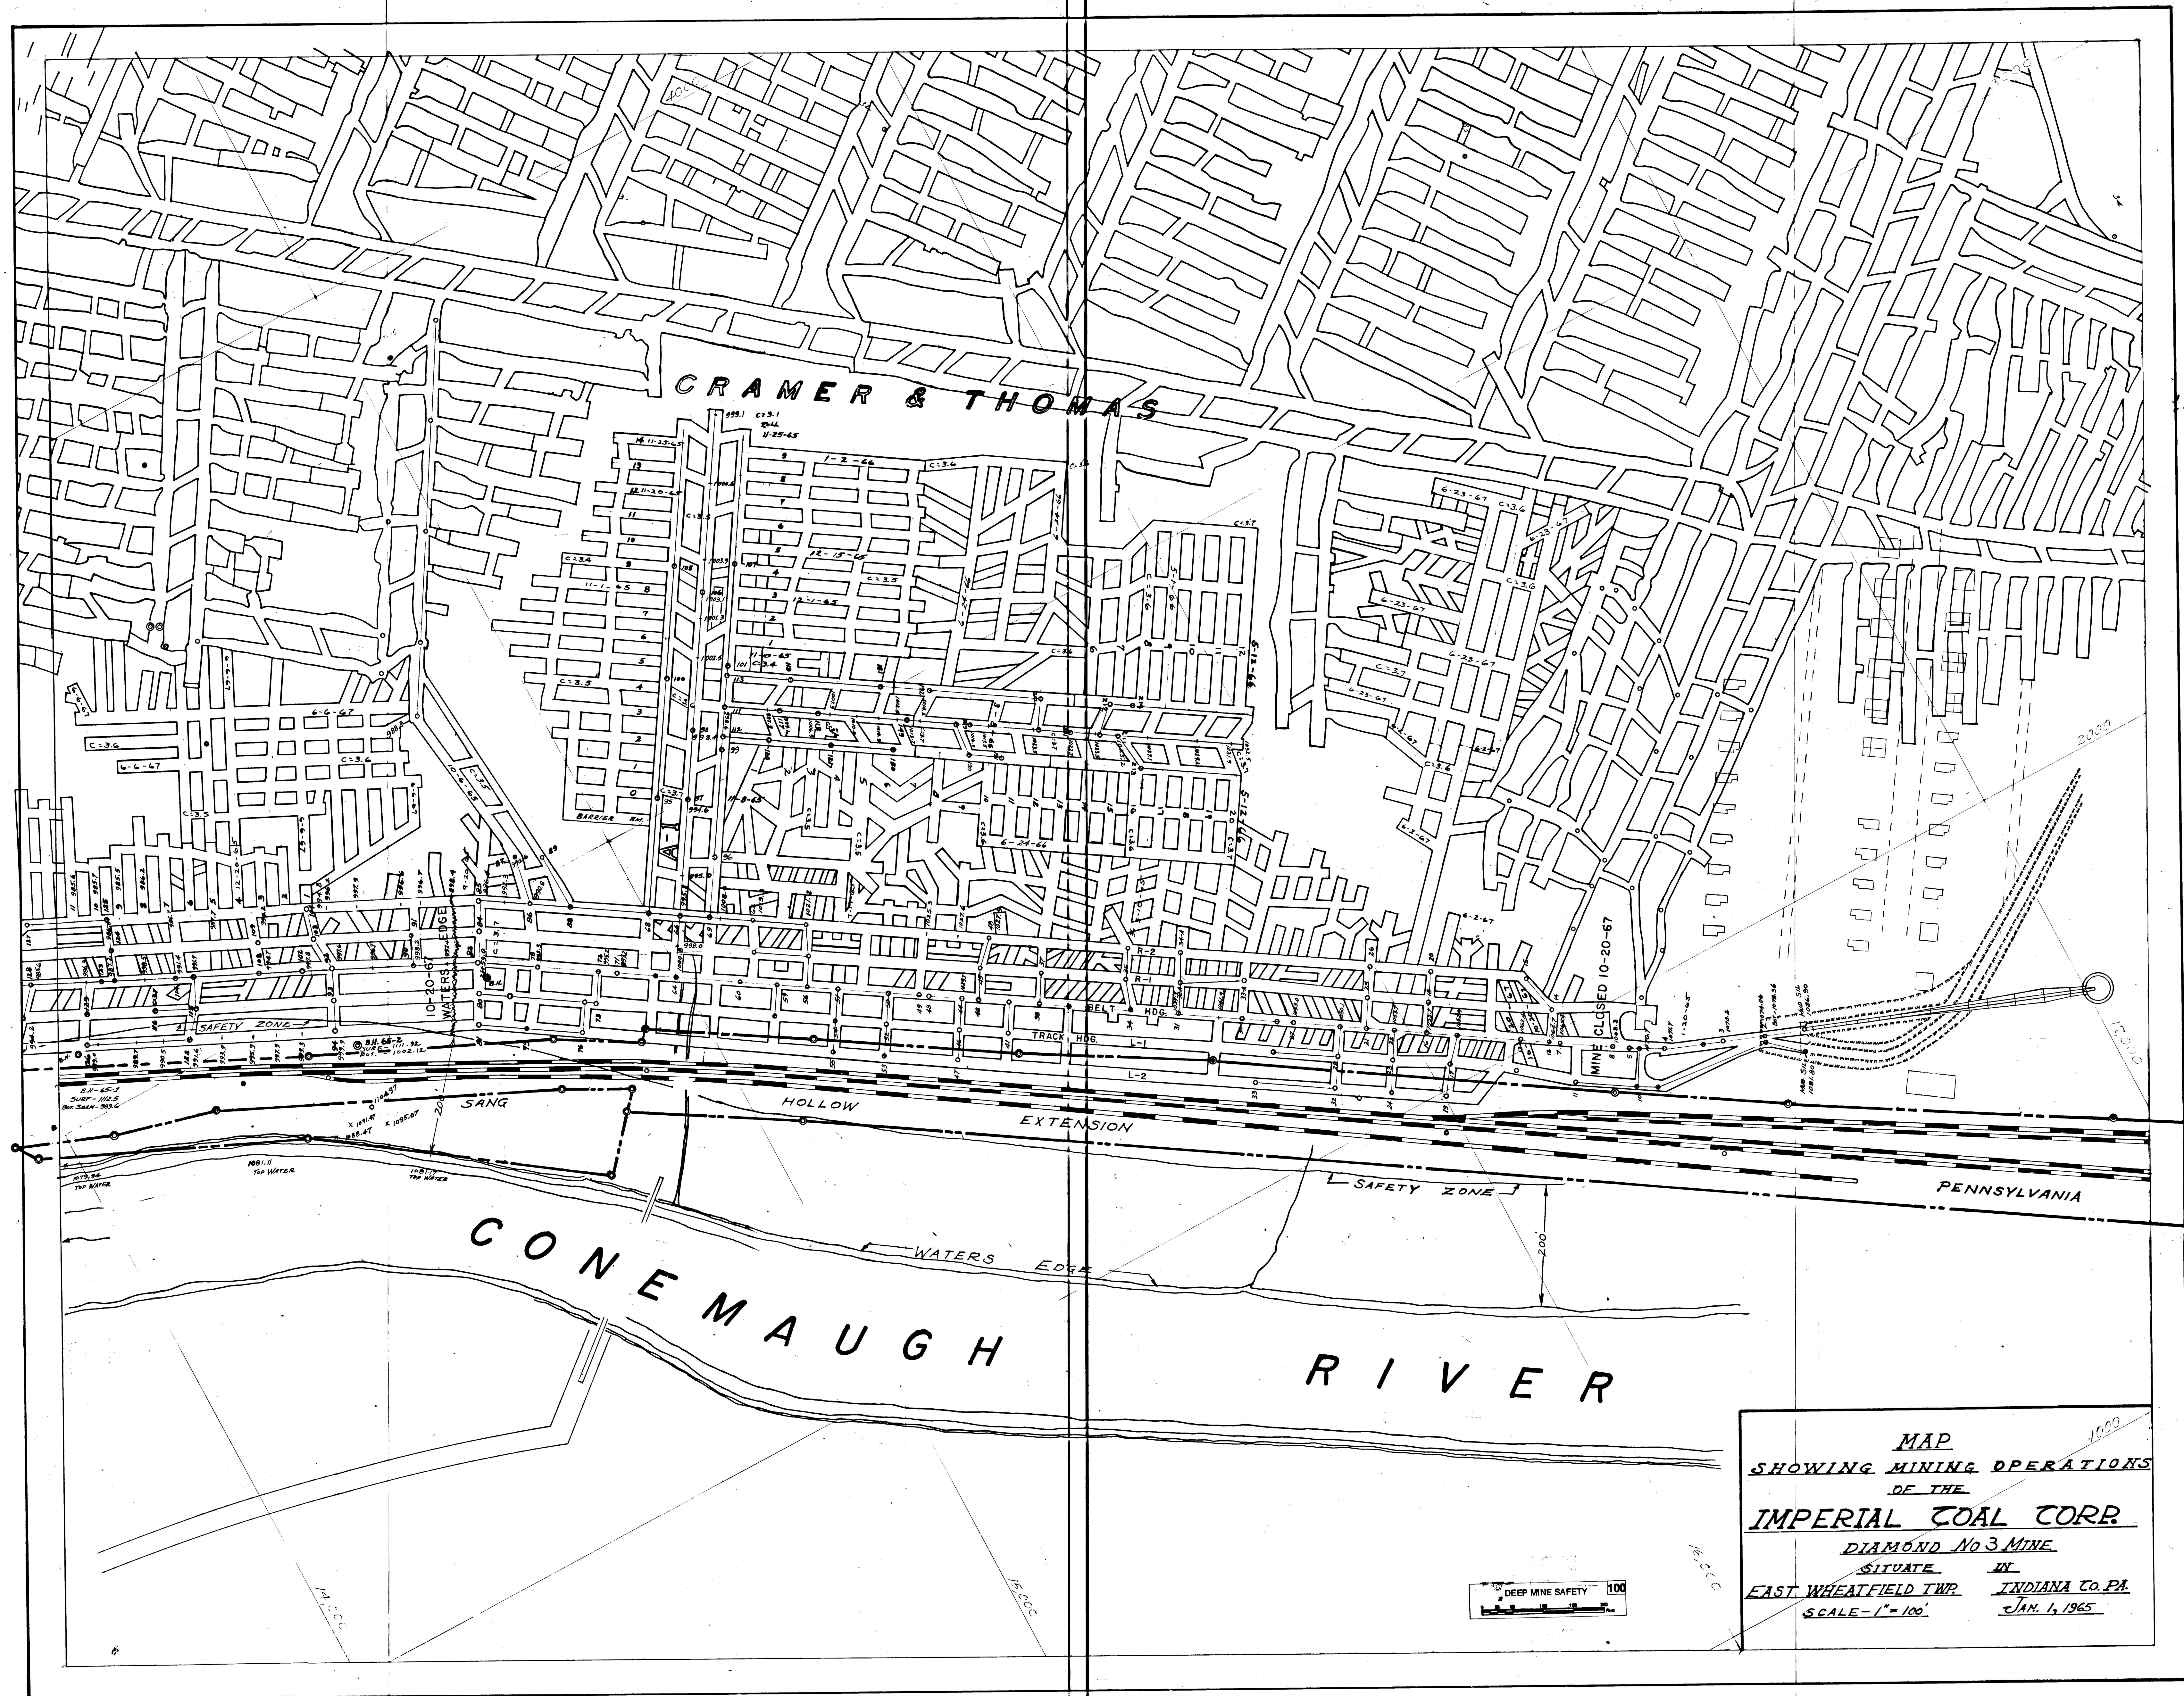

MAP
SHOWING MINING OPERATIONS
OF THE
IMPERIAL COAL CORP.
DIAMOND No. 3 MINE
SITUATE IN
EAST WHEATFIELD TWP. INDIANA CO. PA.
SCALE - 1" = 100'
JAN. 1, 1965