


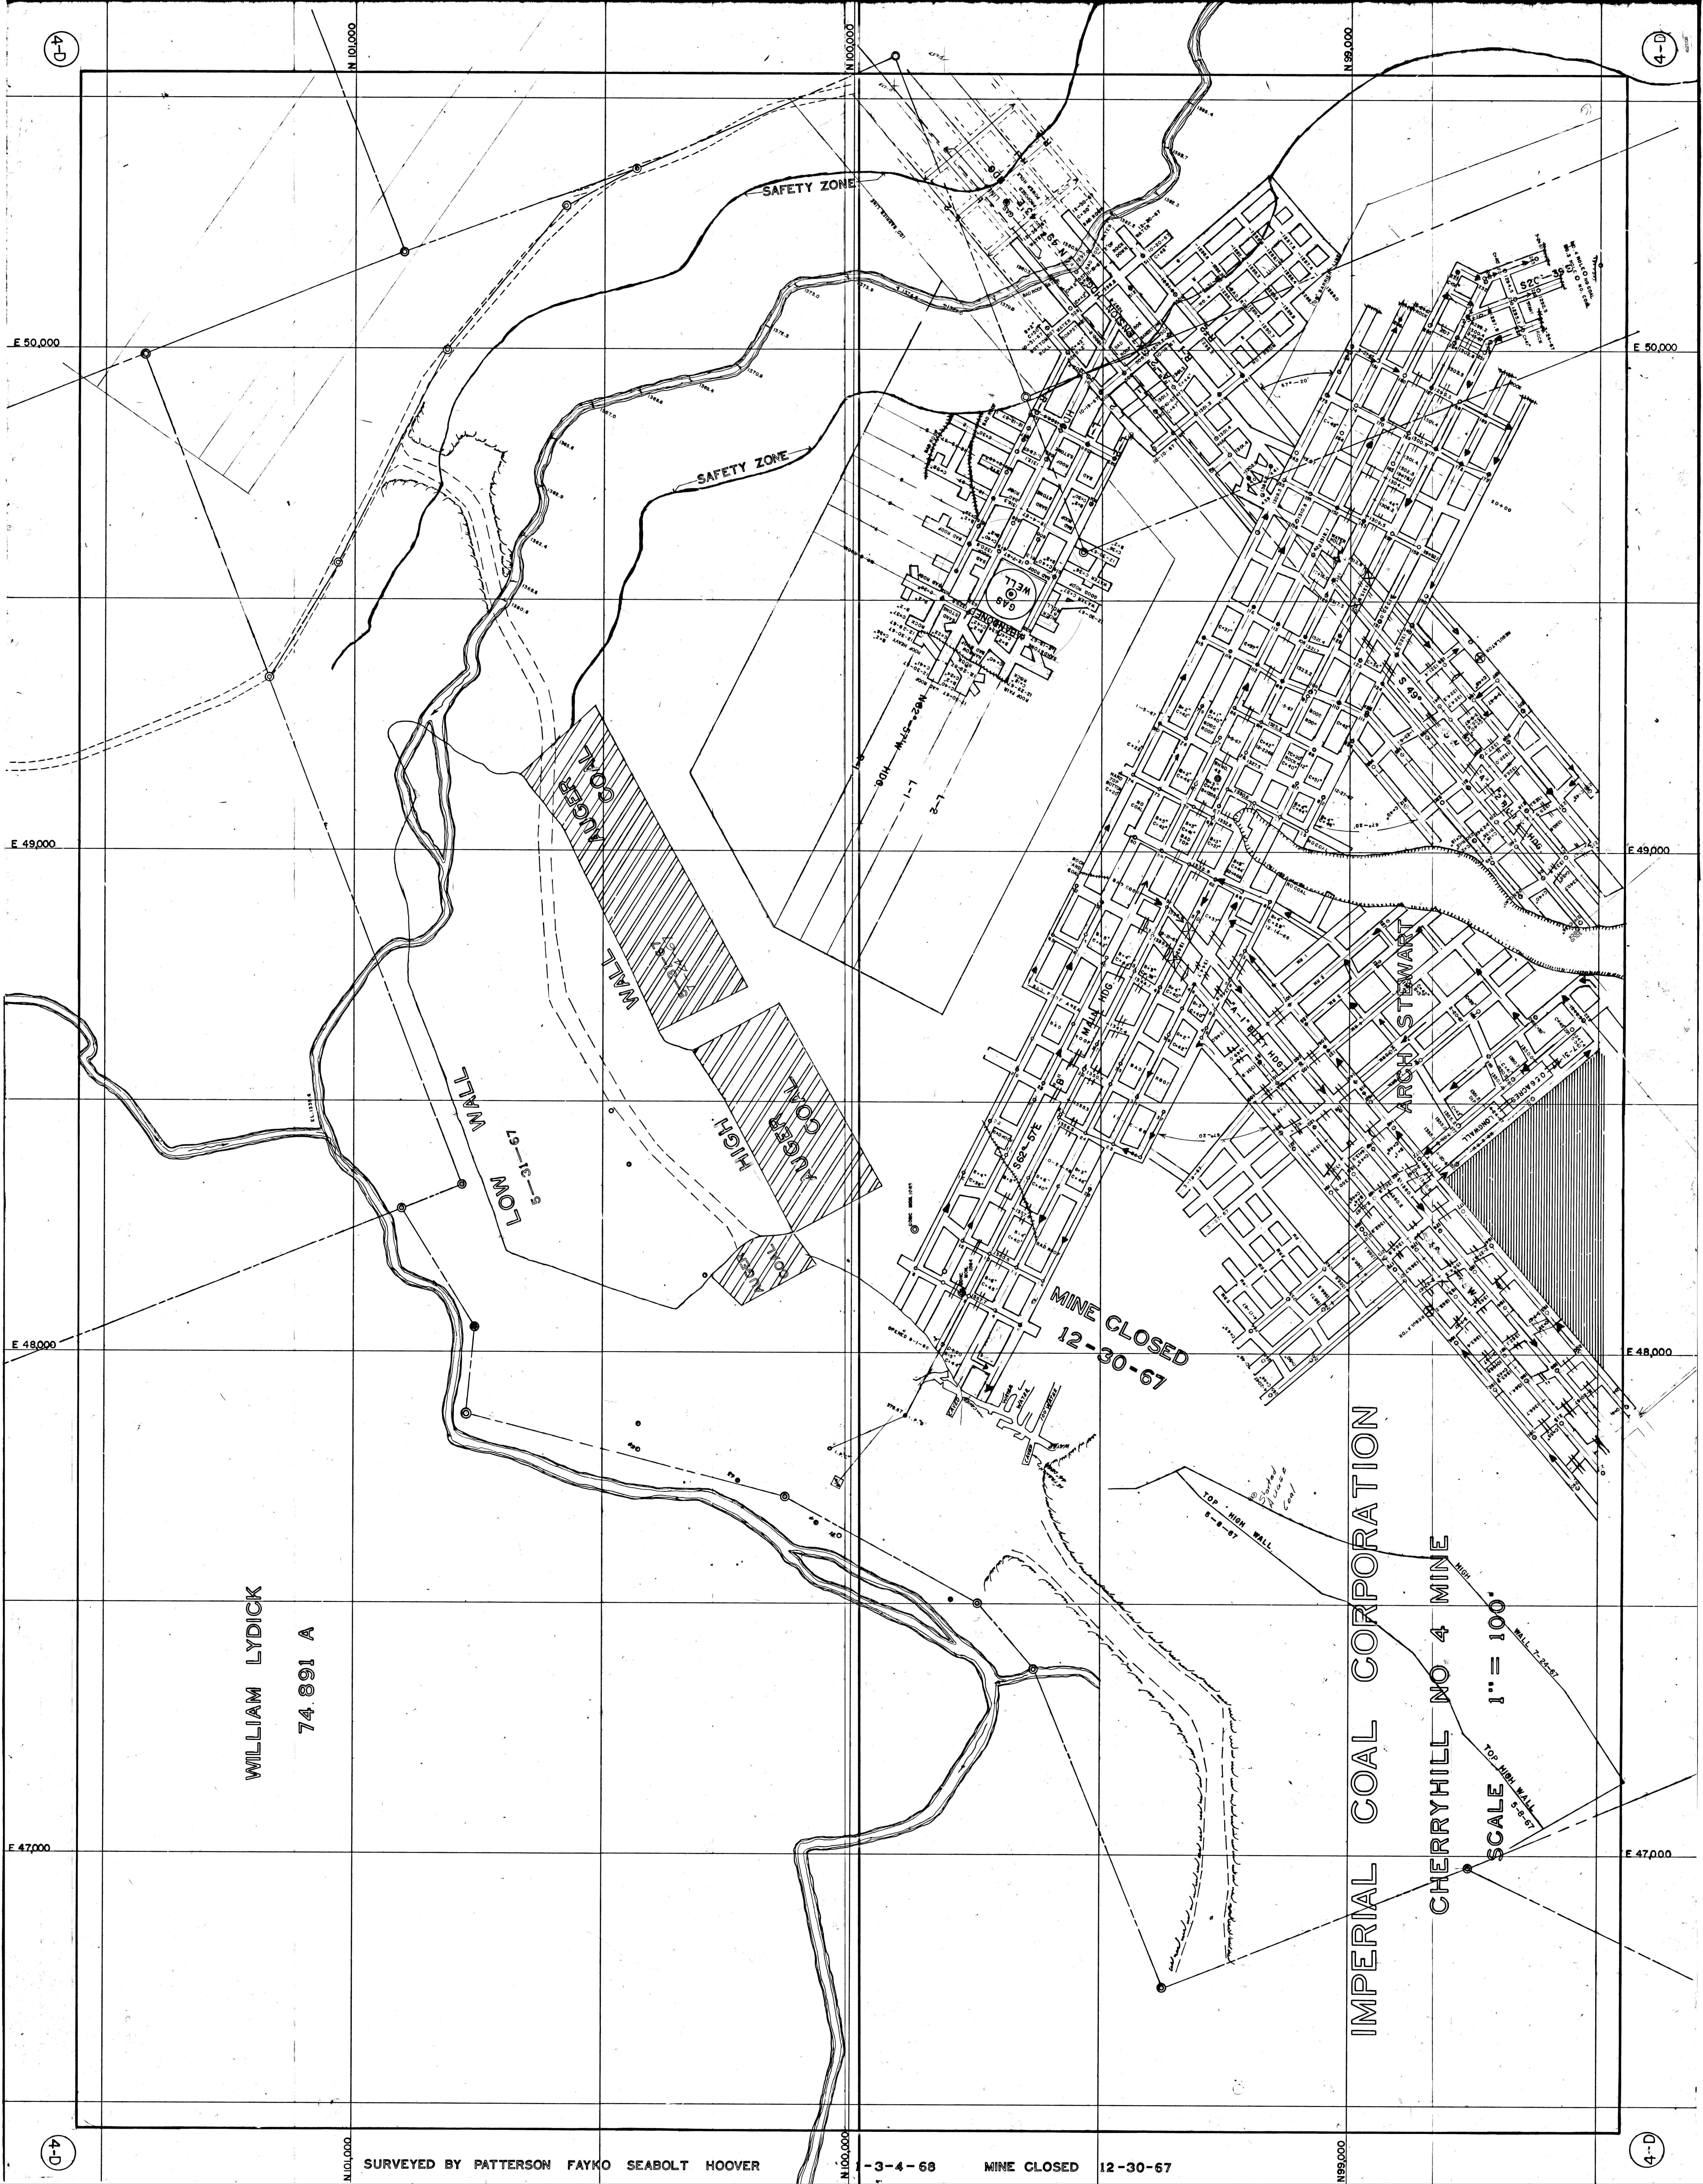

WILLIAM LYDICK
74.891 A

IMPERIAL COAL CORPORATION

CHERRYHILL NO 4 MINE

SCALE 1" = 100'