



Sarah Resources, Inc.  
Sarah Mine  
**Final Mine Map**  
**Temporarily Sealed**

MSHA I.D. No. 36-08571  
CMAF # 56961301

Date: 09-05-03  
Scale: 1" = 200'

Jenners Twp. & Jennerstown Boro  
Somerset County, Pennsylvania

P.O. Box 240  
Friedens, PA 15541  
Phone: 814-629-1379  
Fax: 814-629-8870

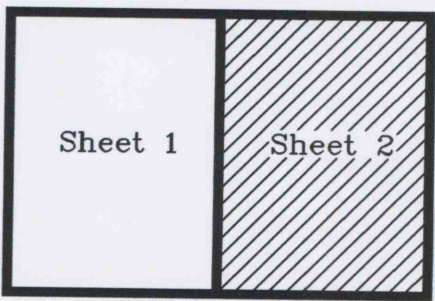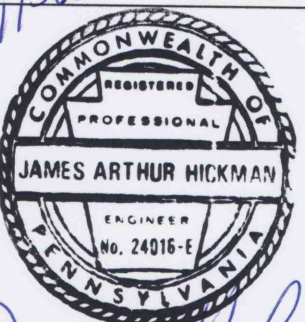

9-103  
All information on this map is accurate to the best of my knowledge, information and belief.  
The certification of this final map is based on prior certifications. Original mapping was provided by Penn Coal, Inc.

**ORIENTATION PROCEDURES USED TO LOCATE ADJACENT ABANDONED MINES**

**Orenda Mine - Upper Kittanning Seam (Mine Ref. F)**

Maps of the Orenda Mine were reviewed at Deep Mine Safety in Uniontown, Penn Pocahontas Land Co., and the Bureau of District Mining Operations at McKeesport, PA. There is no certified final map available. The source of the maps at Penn Pocahontas was the PA Bureau of District Mining Operations, McKeesport Office. The last date of mining on these maps was March 30, 1939. The mine operated for 55 days in 1939 according to the PA Bituminous Coal Annual Report. There is no record of the mine operating after 1939. The mine workings were oriented from an airshaft, a borehole located near the drift, roads, coveys, and buildings in the area.

**Consol 112 Mine - Upper Kittanning Seam (Mine Ref. A)**

This mine was plotted from maps obtained from Consol Energy. This map is a final notarized map marked "Abandoned March 11, 1949". The PA Bituminous Coal Annual Report stated "no coal mined since March, 1949" and it is not listed in subsequent years. The mine workings were oriented by the relative location to U.S. Route 30. Also, a map marked "Abandoned March 11, 1949" was reviewed at Deep Mine Safety and exhibited the same orientation and mining boundary.

**Consol 123 Mine - Upper Freeport Seam (Mine Ref. B)**

This mine was plotted from maps obtained from Consol Energy. A 1" = 100' map marked "Abandoned February 1, 1955" was reviewed at Deep Mine Safety and revealed the same orientation and mining boundary. The PA Bituminous Coal Annual Report indicates the last coal was mined in 1955. This mine was oriented by its relative location to U.S. Route 30.

**Polesomilco Paradise Mine - Upper Freeport Seam (Mine Ref. H)**

A certified map dated December 9, 1992, with a note that the mine was idled on December 1, 1992, was obtained from PA DEP at McKeesport. Statements from former mine officials verify that no mining took place after December 1, 1992. The orientation and mining boundary are based on this map.

**Stuffs E Seam Mine - Upper Freeport Seam (Mine Ref. C)**

The mine workings were plotted from maps obtained from Penn Pocahontas Land Co. and the USM map repository in Greentree. The maps are not certified or marked final.

**John Cable Mine - Upper Freeport Seam (Mine Ref. D)**

This mine reportedly operated from 1949 to 1952. No maps or records could be located for this mine. The operator is deceased and his descendants have no information regarding this mine.

