


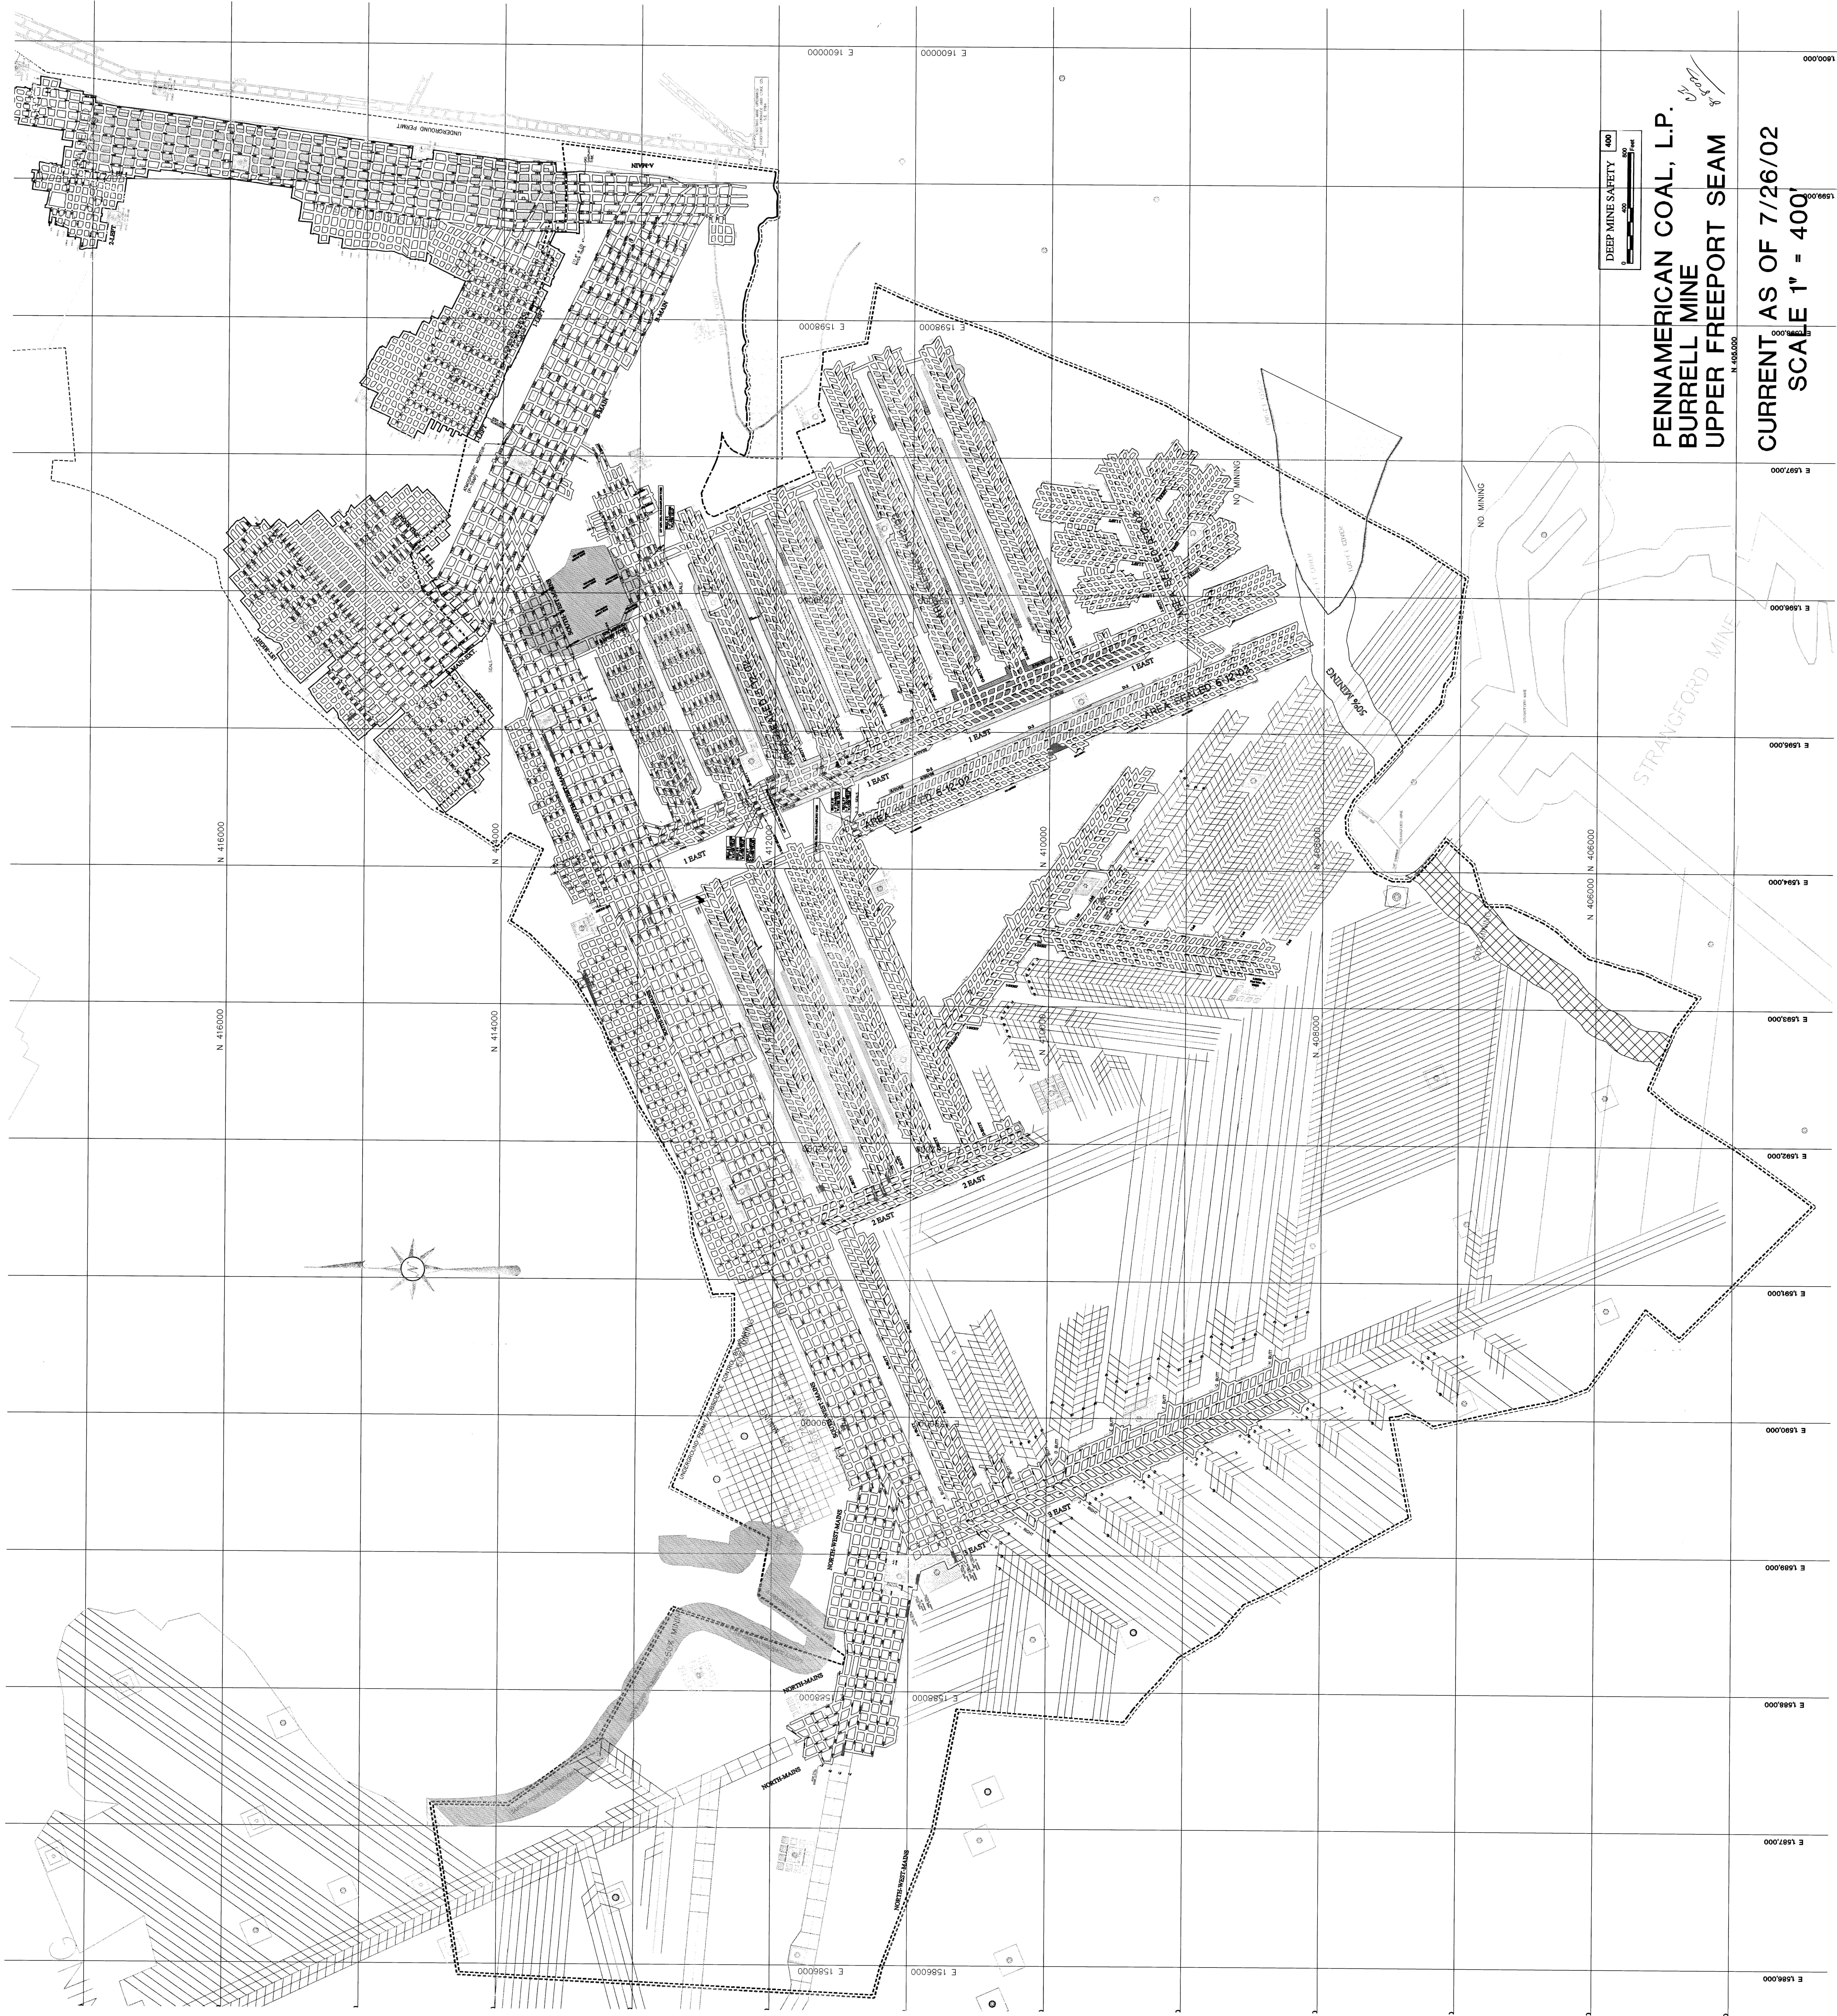

DEEP MINE SAFETY	400
------------------	-----

400






PENNAMERICAN COAL, L.P.
BURRELL MINE
UPPER FREEPORT SEAM

BURRELL MINE

UPPER FREEPORT SEAM

405.000

CURRENT AS OF 7/26/02

SCALE 1" = 400'