

DEEP MINE SAFETY 400
0 200 400 800
Feet

LEGEND

18 ACRE AMENDMENT
PERMIT AREA 3339.6 ACRES
SUBSIDENCE CONTROL PLAN BOUNDARY 3333.5 ACRES
25' ANGLE OF DRAIN LINE
COAL OUTCROP ON UPPER KITTIMANING SEAM
STRUCTURE CONTOUR ON UPPER KITTIMANING SEAM 1710
STREAMS, LAKES, SPRINGS
TELEPHONE LINES
POWER LINES
TREE LINES
DRILL HOLES


PONDS
RAILROADS
WELLS
BACKGROUND SAMPLE POINTS
PUBLIC ROADS
PRIVATE ACCESS ROADS
SURFACE PROPERTY LINES
SURFACE OWNER: James D. Stahl
50% MINING AREAS

SPRINGS
MONITORING POINTS

SUBSURFACE PROPERTY LINES
SUBSURFACE OWNER: D15 DAVID E. MAXWELL
50% MINING AREAS


RESERVATION AREAS
RESERVATION

BUILDINGS
(CURRENT USE OF BUILDINGS IS LISTED IN THE APPLICATION.)
(POST "1966" STRUCTURES ARE DENOTED WITH "AA" AFTER THE NUMBER OF THE STRUCTURE.)

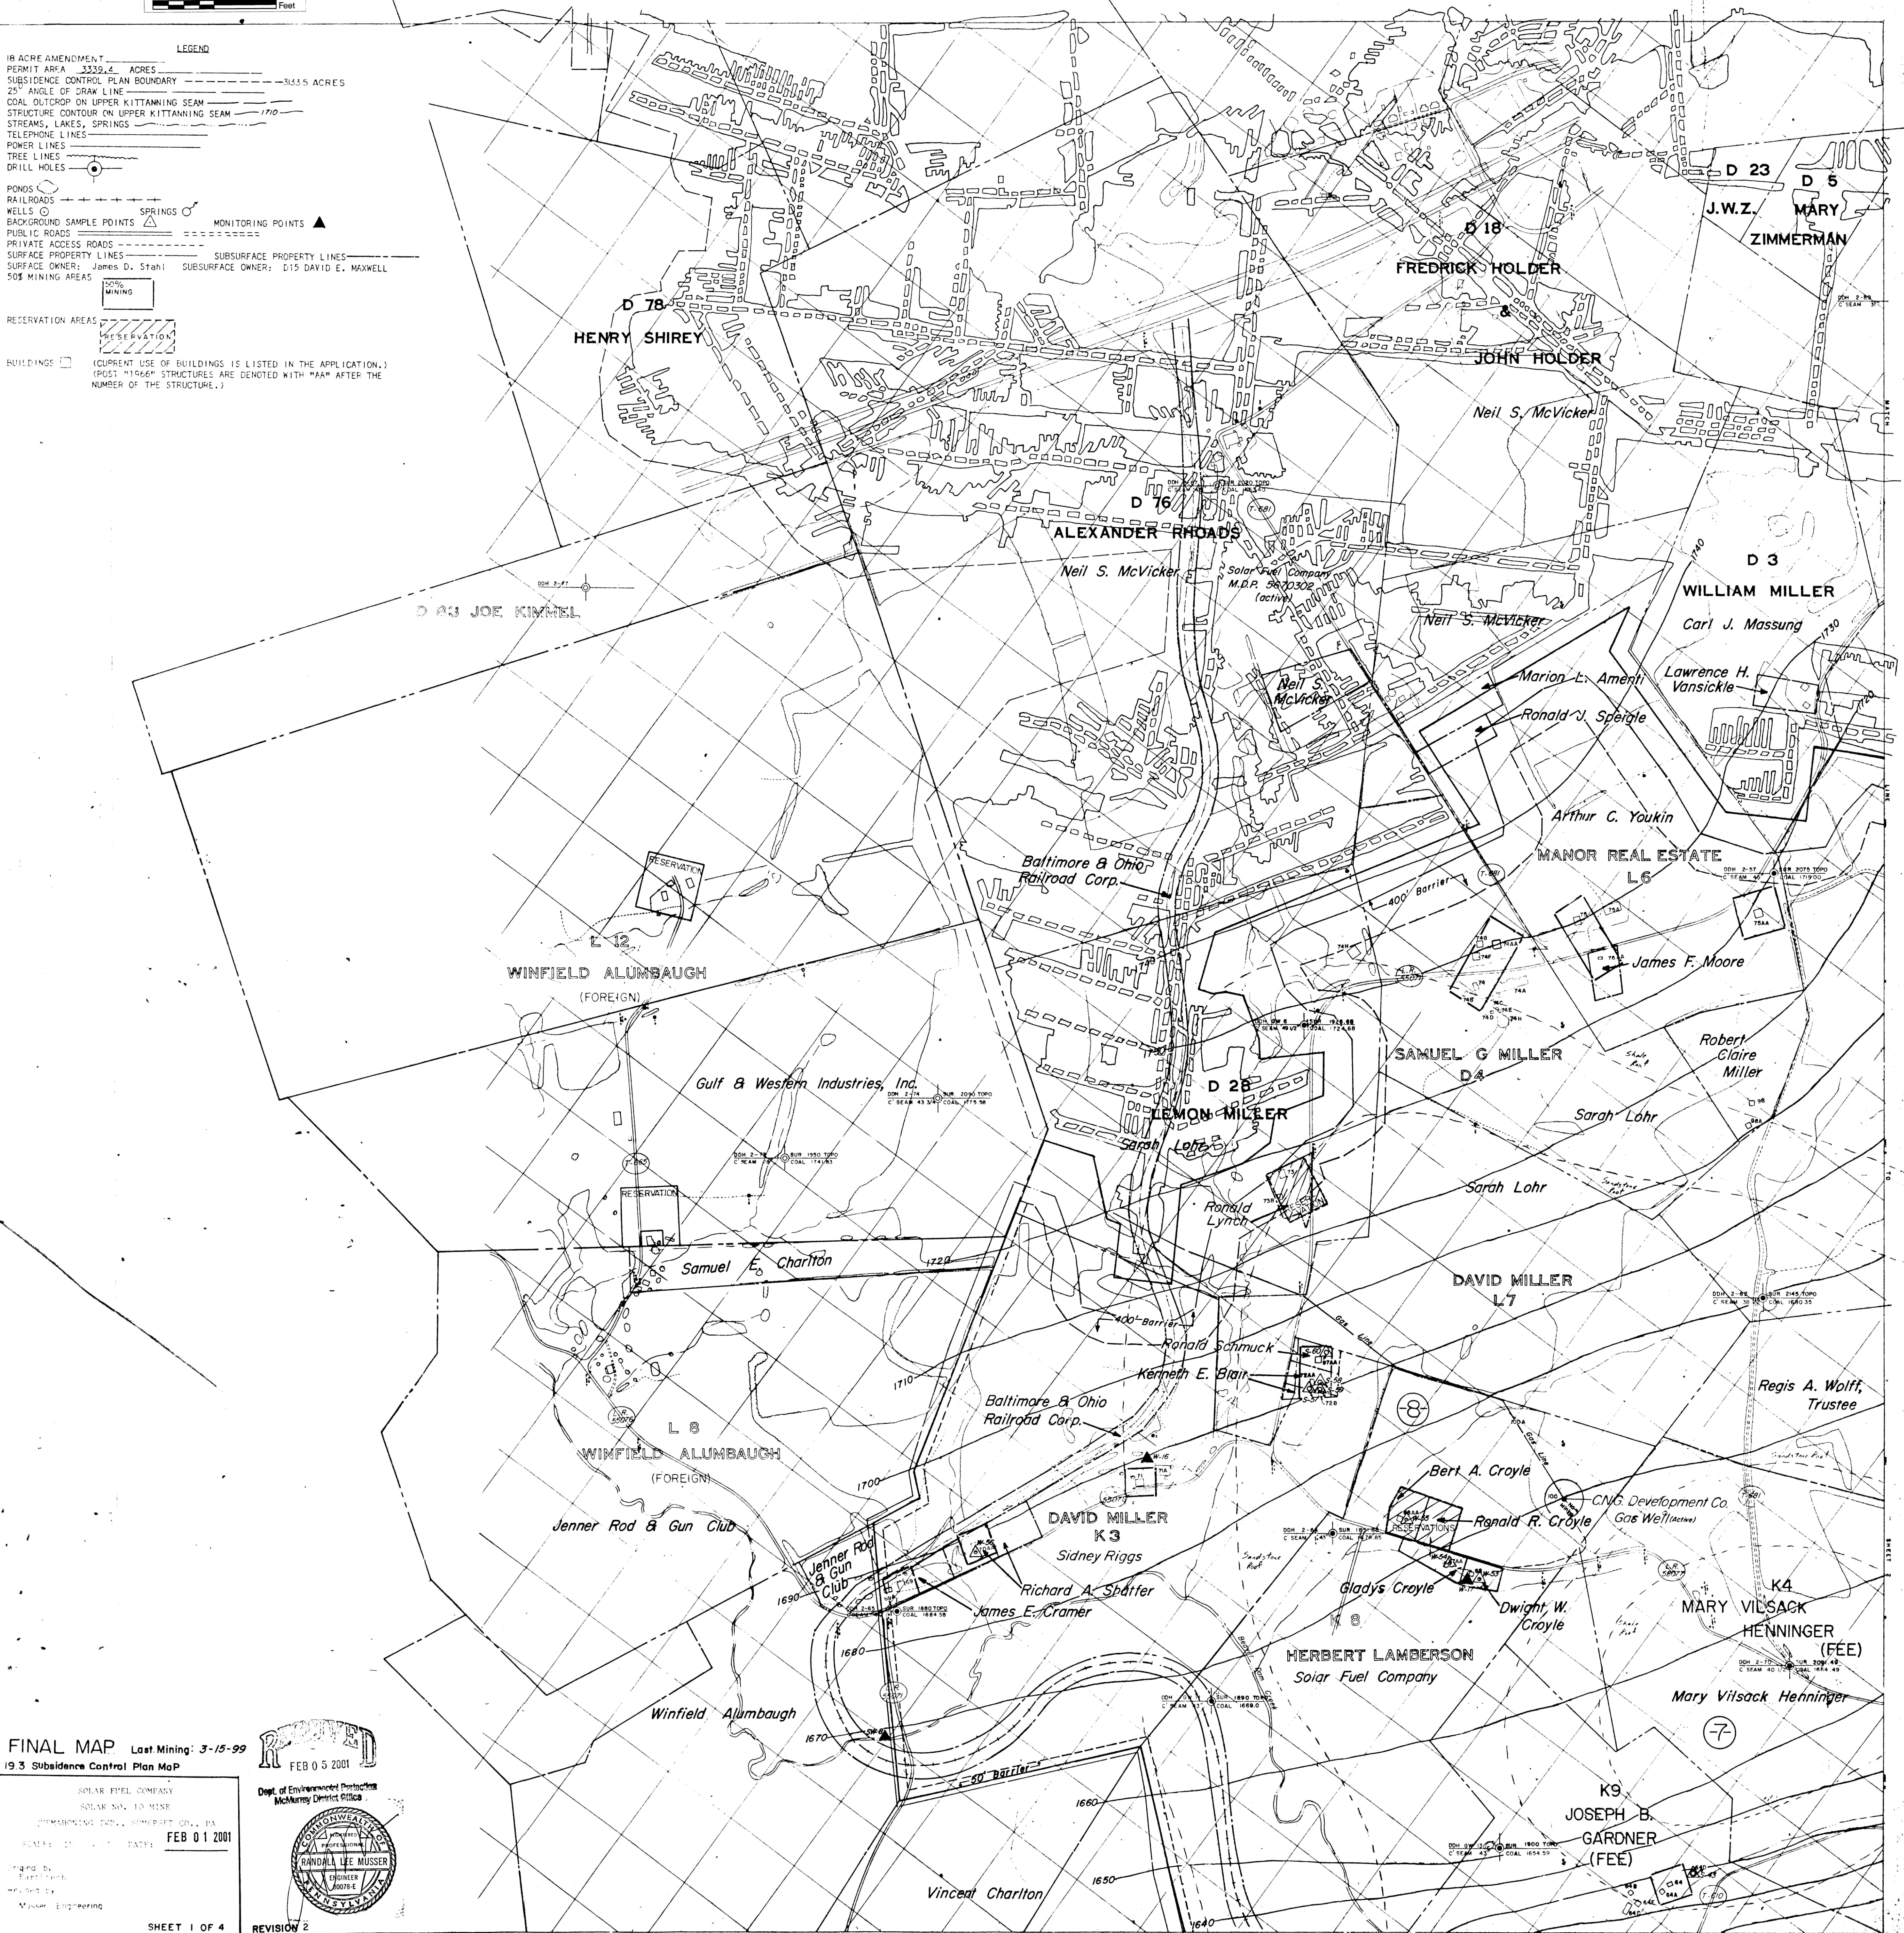

FINAL MAP Last Mining: 3-15-99
193 Subsidence Control Plan Map

SOLAR FUEL COMPANY
SOLAR NO. 10 MINE
DEVELOPING DIV., SUMMITTOWN, PA
DATE: FEB 01 2001
Signed by: [Signature]
Checked by: [Signature]
MUSSEY ENGINEERING

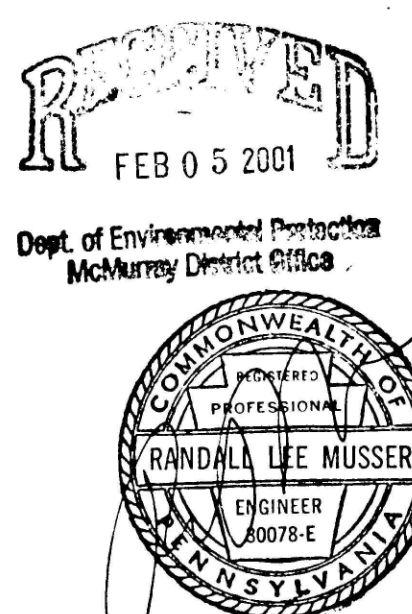

SHEET 1 OF 4

REVISION 2

Match to Sheet 3