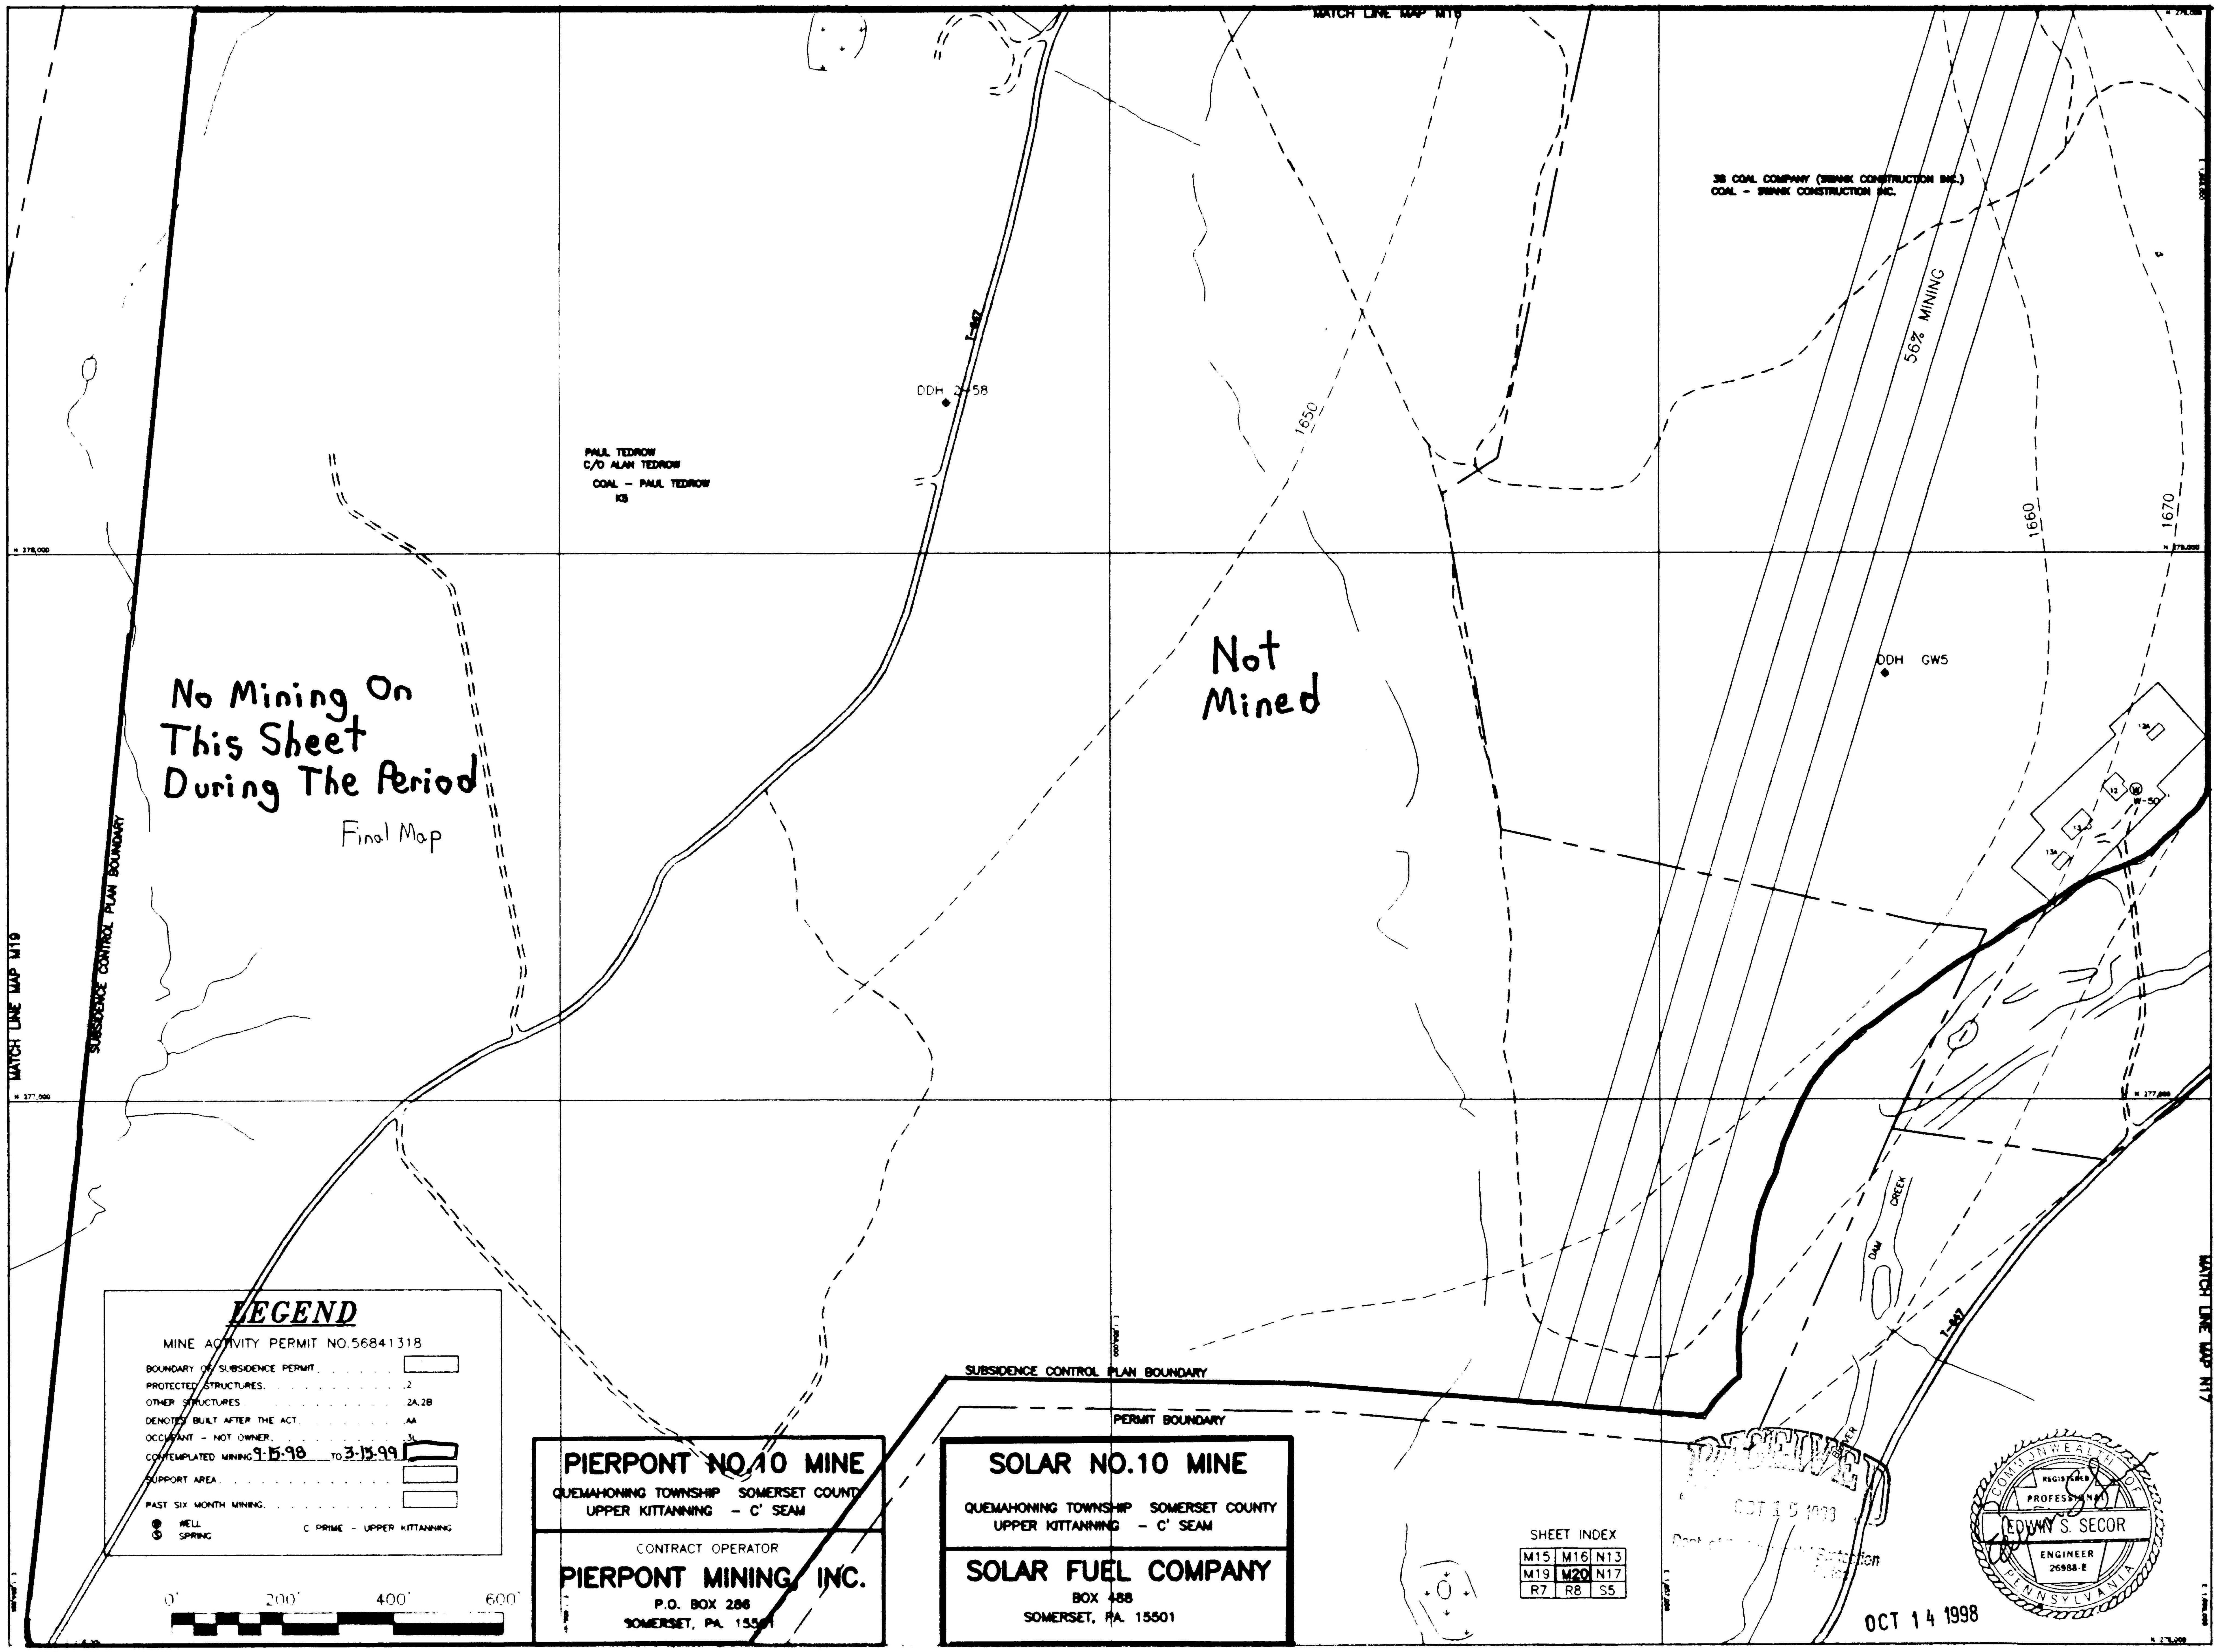
MATCH LINE MAP M16
MATCH LINE MAP M19
MATCH LINE MAP N17
SUBSIDENCE CONTROL PLAN BOUNDARY
PERMIT BOUNDARY
No Mining On
This Sheet
During The Period
Final Map
Not
Mined
PAUL TEDROW
C/O ALAN TEDROW
COAL - PAUL TEDROW
KS
DDH 2-58
T-847
1650
1660
1670
56% MINING
DDH GW5
3B COAL COMPANY (SWANK CONSTRUCTION INC.)
COAL - SWANK CONSTRUCTION INC.
W-50
DAM
CREEK
LEGEND
MINE ACTIVITY PERMIT NO.56841318
BOUNDARY OF SUBSIDENCE PERMIT
PROTECTED STRUCTURES .2
OTHER STRUCTURES .2A,2B
DENOTES BUILT AFTER THE ACT .AA
OCCUPANT - NOT OWNER .3L
CONTEMPLATED MINING 9-15-98 TO 3-15-99
SUPPORT AREA
PAST SIX MONTH MINING
WELL
SPRING
C PRIME - UPPER KITTANNING
0' 200' 400' 600'
PIERPONT NO.10 MINE
QUEMAHONING TOWNSHIP SOMERSET COUNTY
UPPER KITTANNING - C' SEAM
CONTRACT OPERATOR
PIERPONT MINING, INC.
P.O. BOX 286
SOMERSET, PA. 15501
SOLAR NO.10 MINE
QUEMAHONING TOWNSHIP SOMERSET COUNTY
UPPER KITTANNING - C' SEAM
SOLAR FUEL COMPANY
BOX 488
SOMERSET, PA. 15501
SHEET INDEX
M15 M16 N13
M19 M20 N17
R7 R8 S5
OCT 1 5 1998
COMMONWEALTH OF PENNSYLVANIA
REGISTERED PROFESSIONAL
EDWIN S. SECOR
ENGINEER
26988-E
OCT 14 1998

M20