



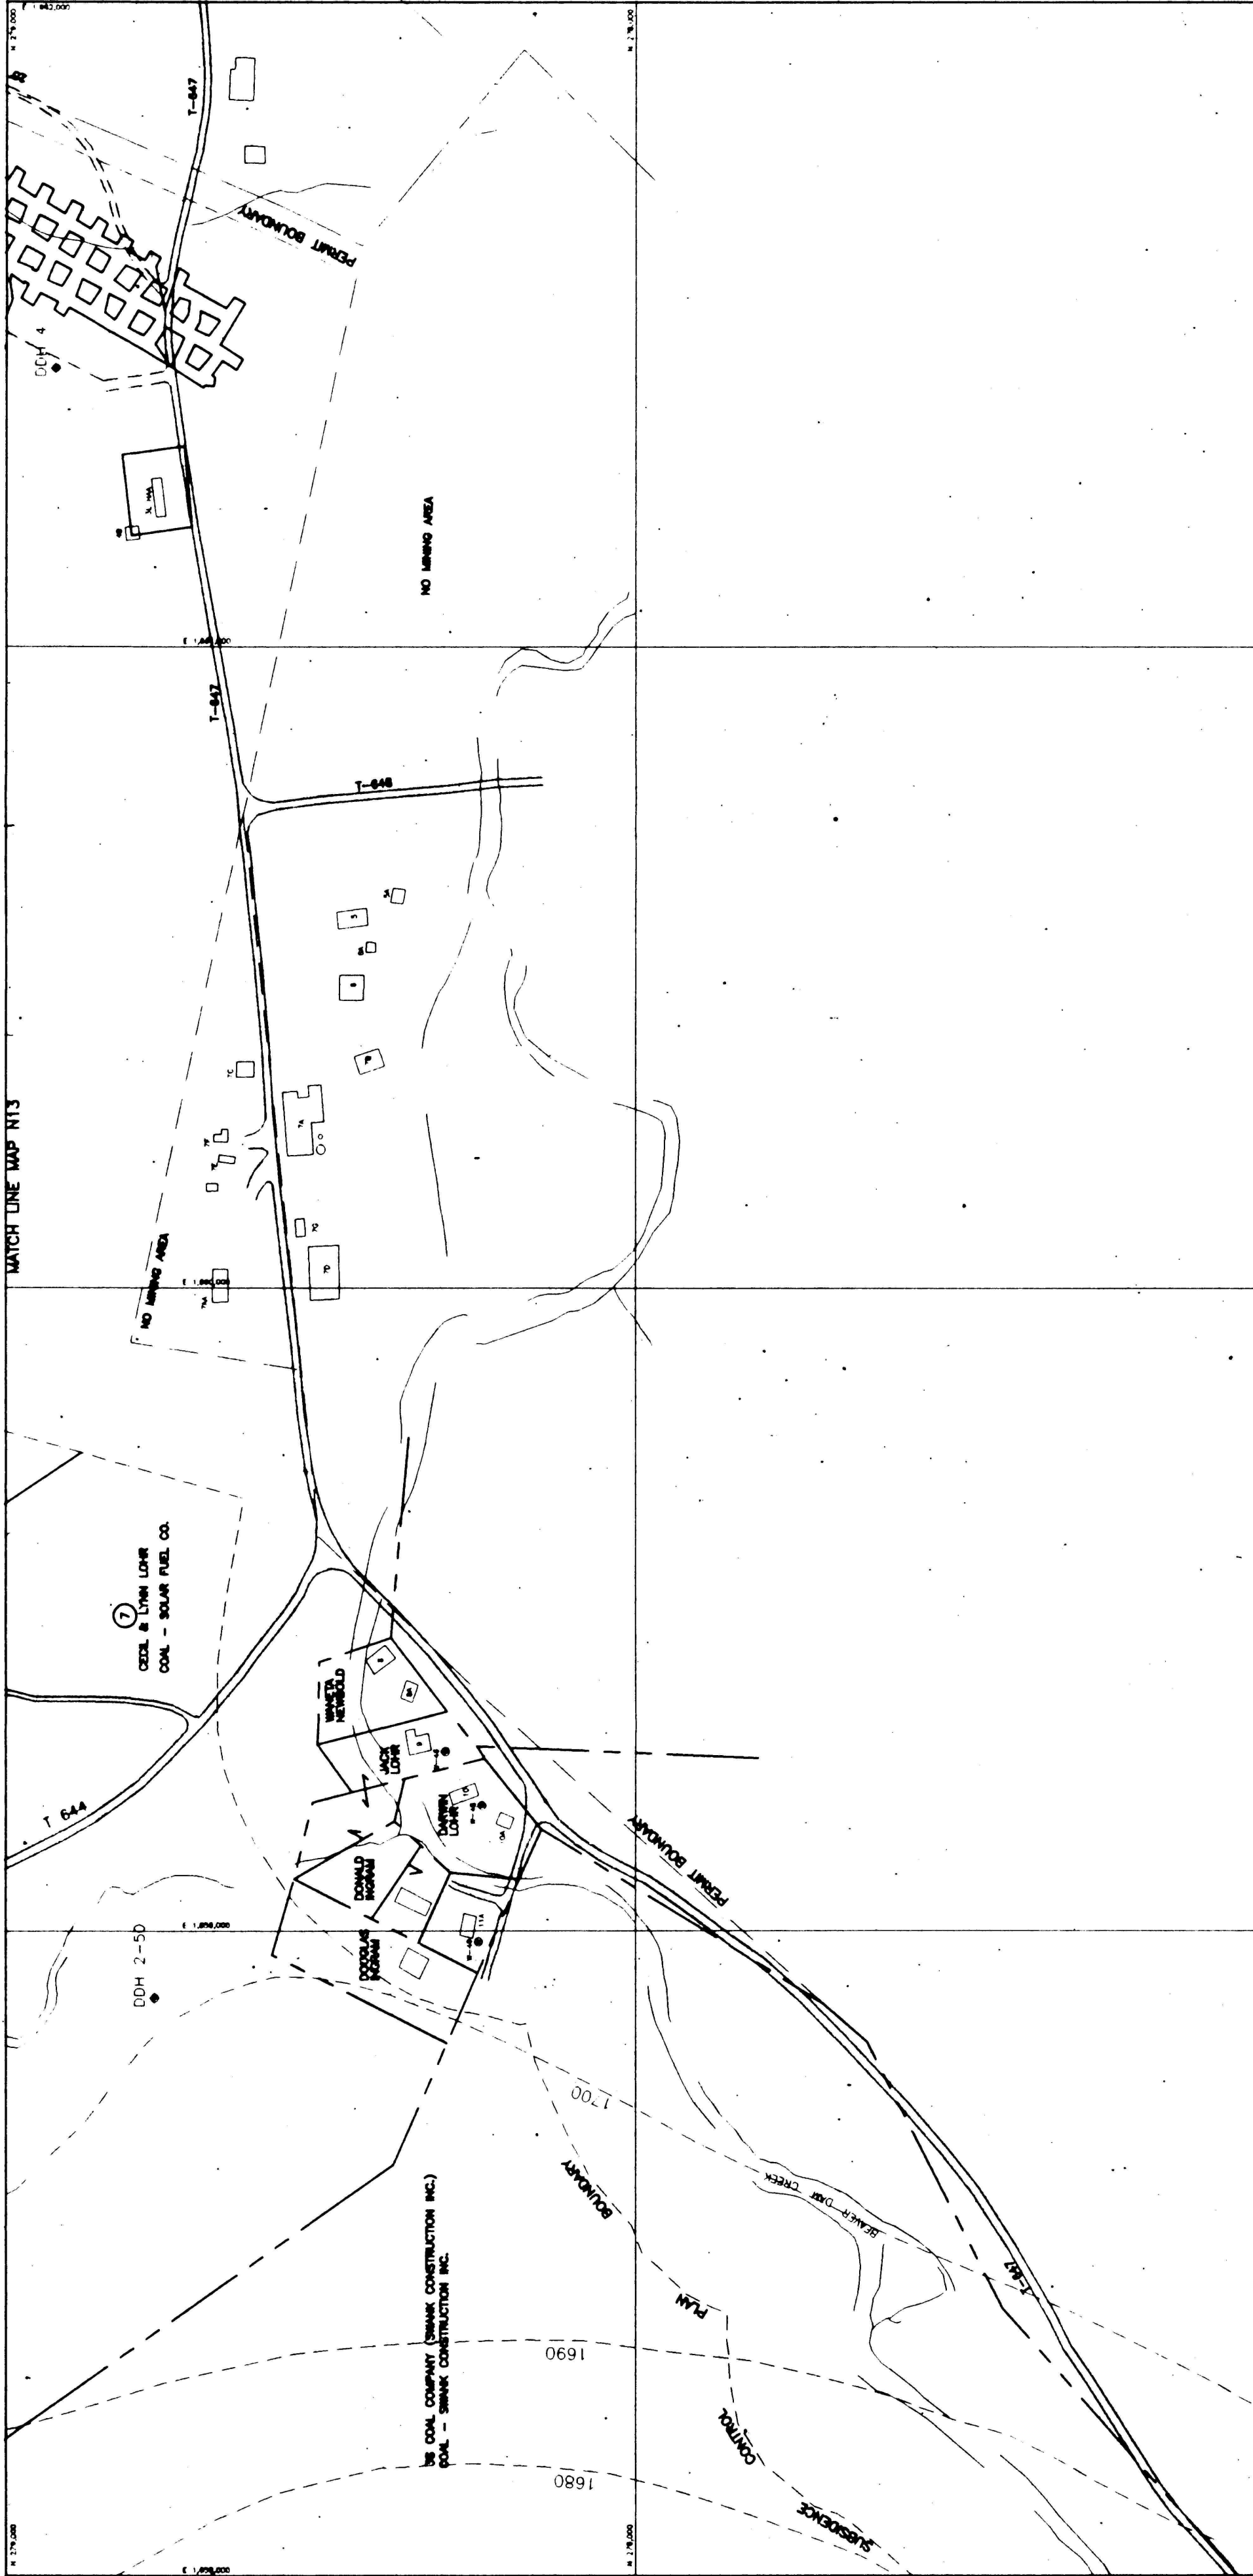

MATCH LINE MAP N20


PIERPONT NO.10 MINE
QUEMAMONING TOWNSHIP SOMERSET COUNTY
UPPER KITTANNING - C' SEAM

PIERPONT MINING, INC.
CONTRACT OPERATOR
P.O. BOX 286
SOMERSET, PA. 15501

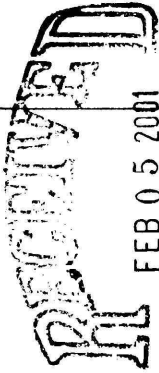

FEB 05 2001

Dept. of Environmental Protection
McMurray District Office

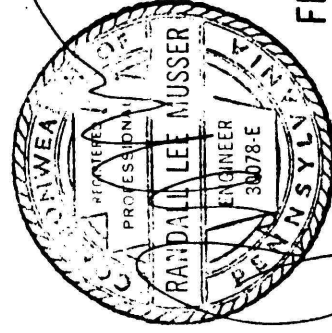

FEB 01 2001

FINAL MAP Last Mining: 3-15-99
19.5 Six Month Projection Map

SOLAR NO.10 MINE
QUEMAMONING TOWNSHIP SOMERSET COUNTY
UPPER KITTANNING - C' SEAM

SOLAR FUEL COMPANY
BOX 488
SOMERSET, PA. 15501

SHEET INDEX

M16	N13	N14
M20	N17	N18
R8	S5	S6

LEGEND

MINE ACTIVITY PERMIT NO.56841318

BOUNDARY OF SUBSIDENCE PERMIT

PROTECTED STRUCTURES

OTHER STRUCTURES

DENOTES BUILT AFTER THE ACT.

OCCUPANT - NOT OWNER

CONTEMPLATED MINING

SUPPORT AREA

PAST SIX MONTH MINING

WELL

SPRING

C PRIME - UPPER KITTANNING

