


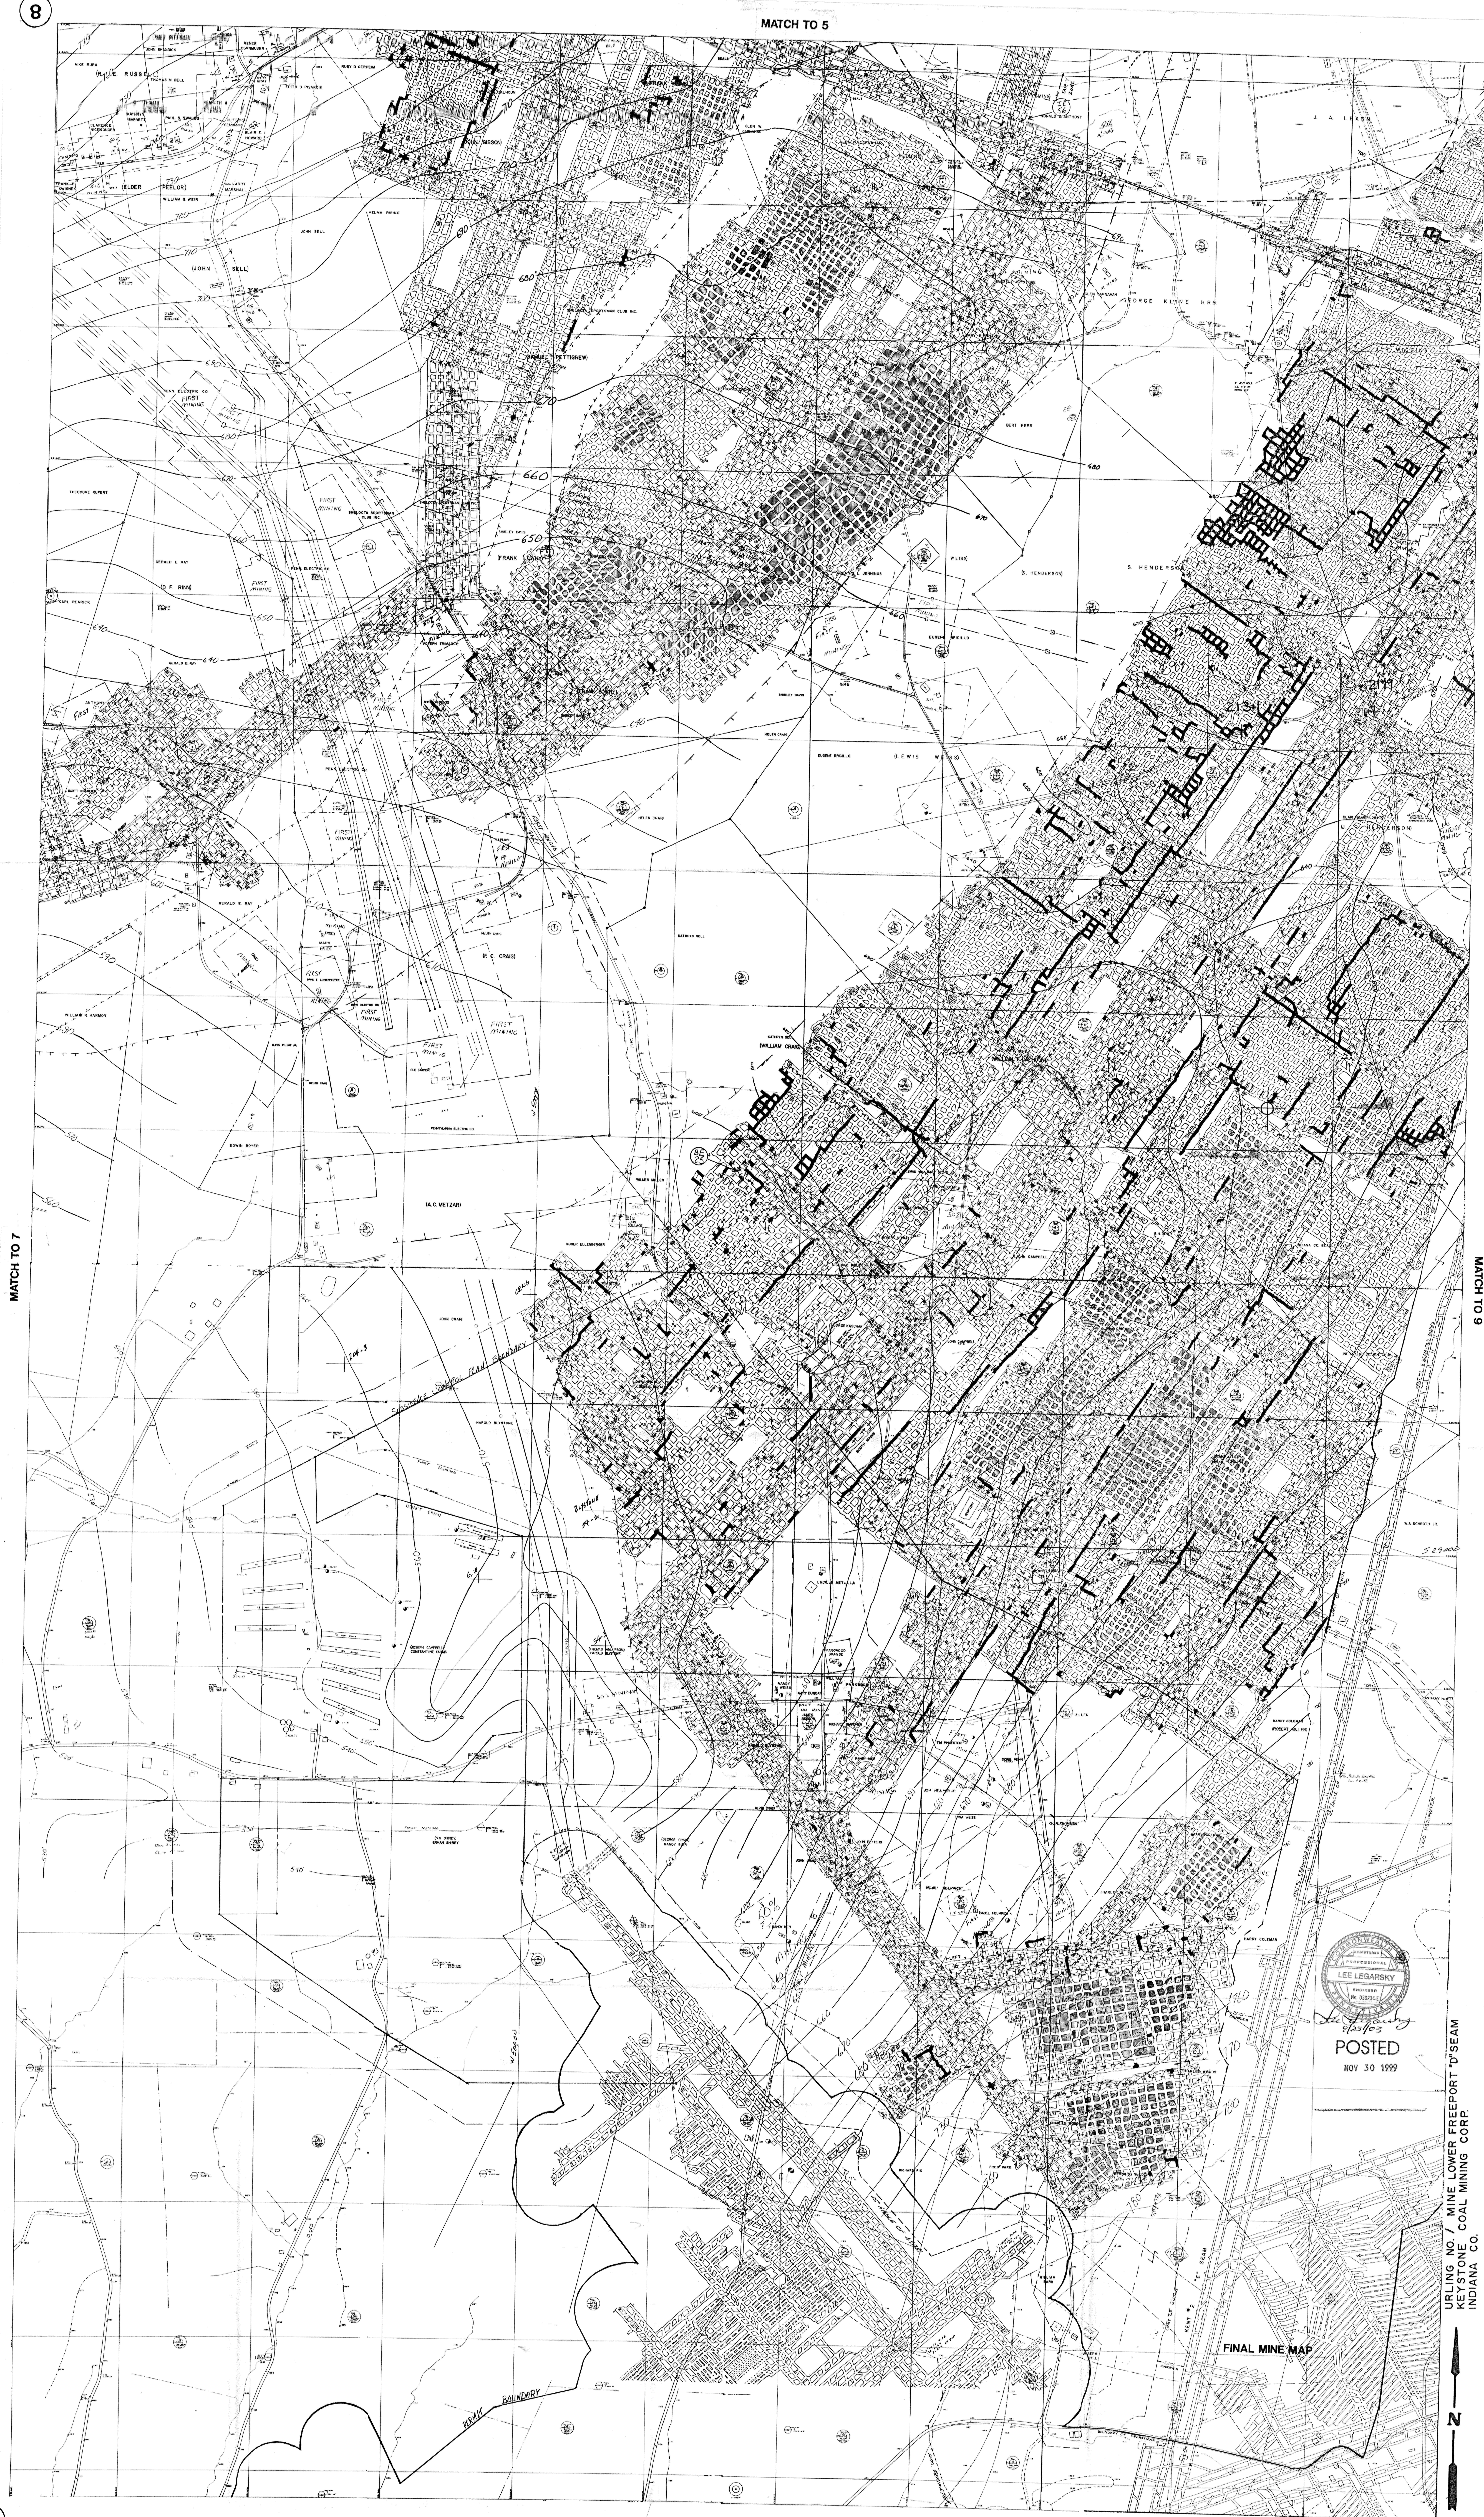

LEE LEGARSKY
REGISTERED PROFESSIONAL ENGINEER
NOV 30 1999
POSTED

URLING NO. / MINE LOWER FREEPORT D'SEAM
KEYSTONE COAL MINING CORP.
INDIANA CO.

FINAL MINE MAP

