


MATCH TO 20

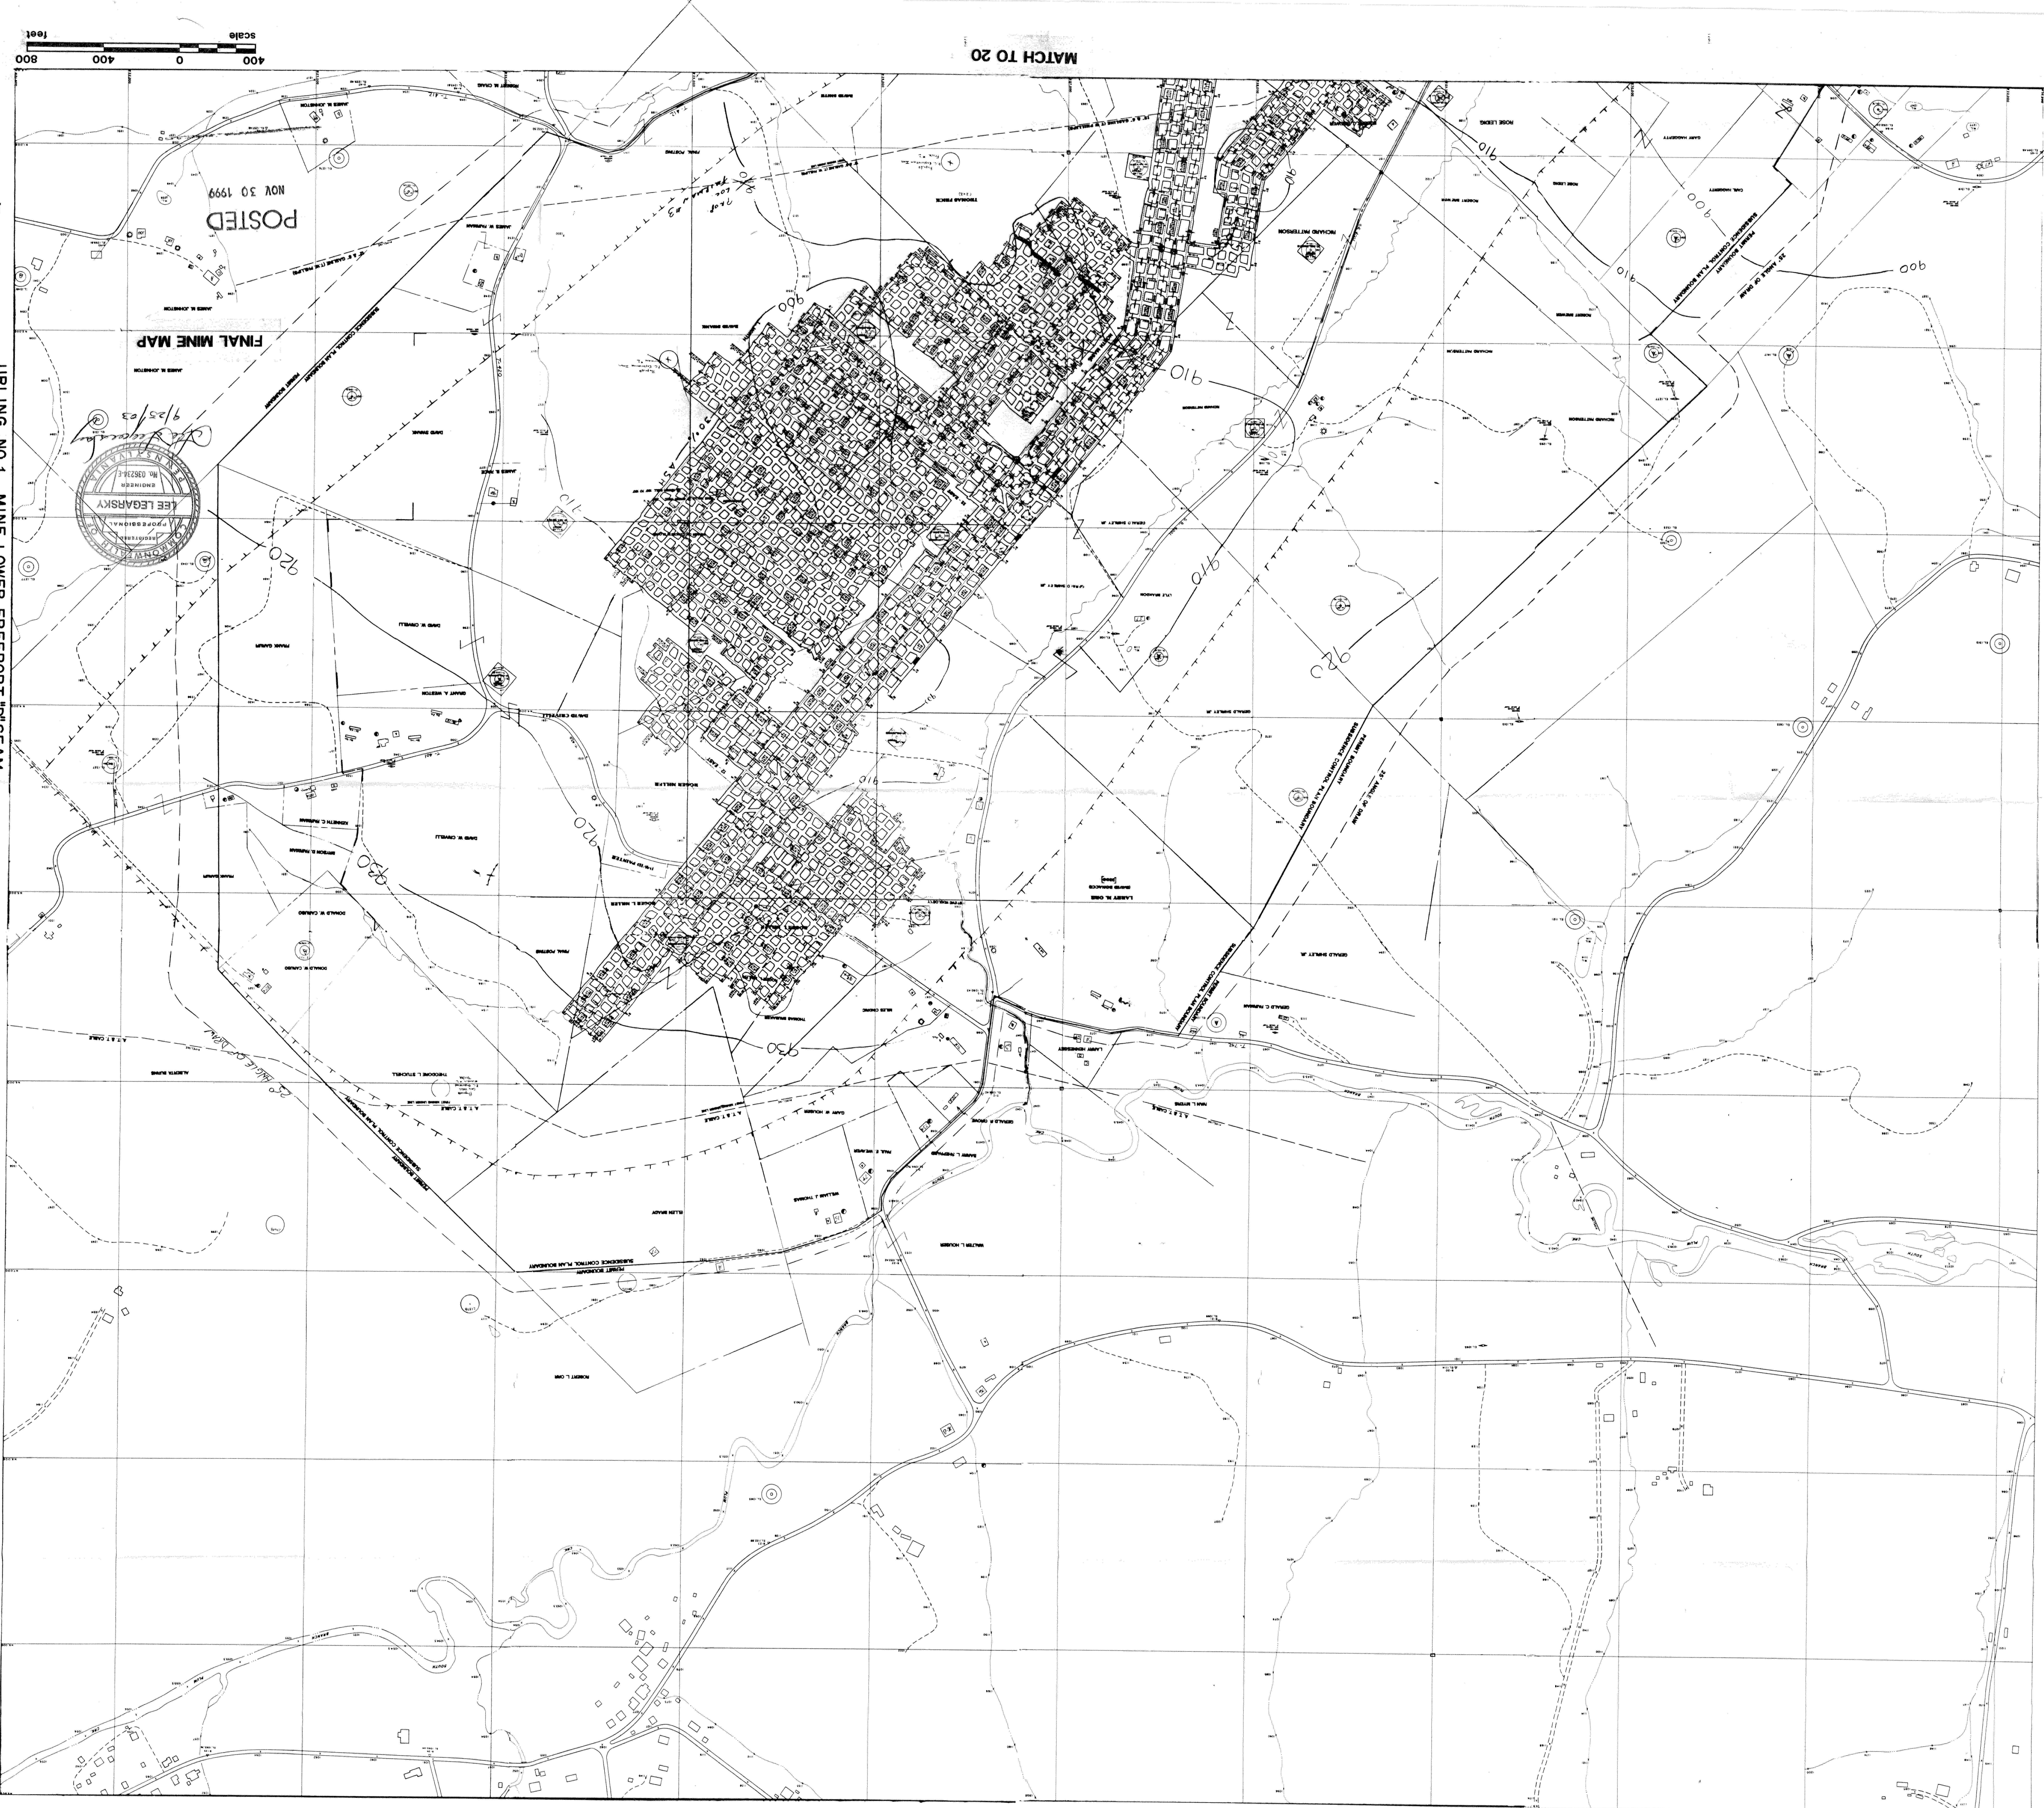

N
T = 400'

URLING NO. 1 MINE LOWER FREEPORT D'SEAM
KEYSTONE COAL MINING CORP.
INDIANA CO.