


MATCH TO 8

POSTED
NOV 30 1999

FINAL MINE MAP

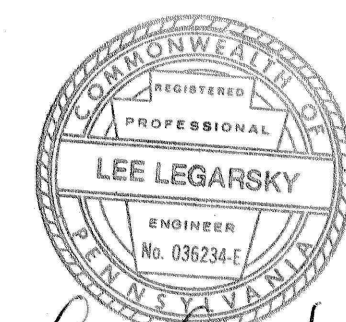

URLING NO. / MINE LOWER FREEPORT "D" SEAM
KEYSTONE COAL MINING CORP.
INDIANA CO.

