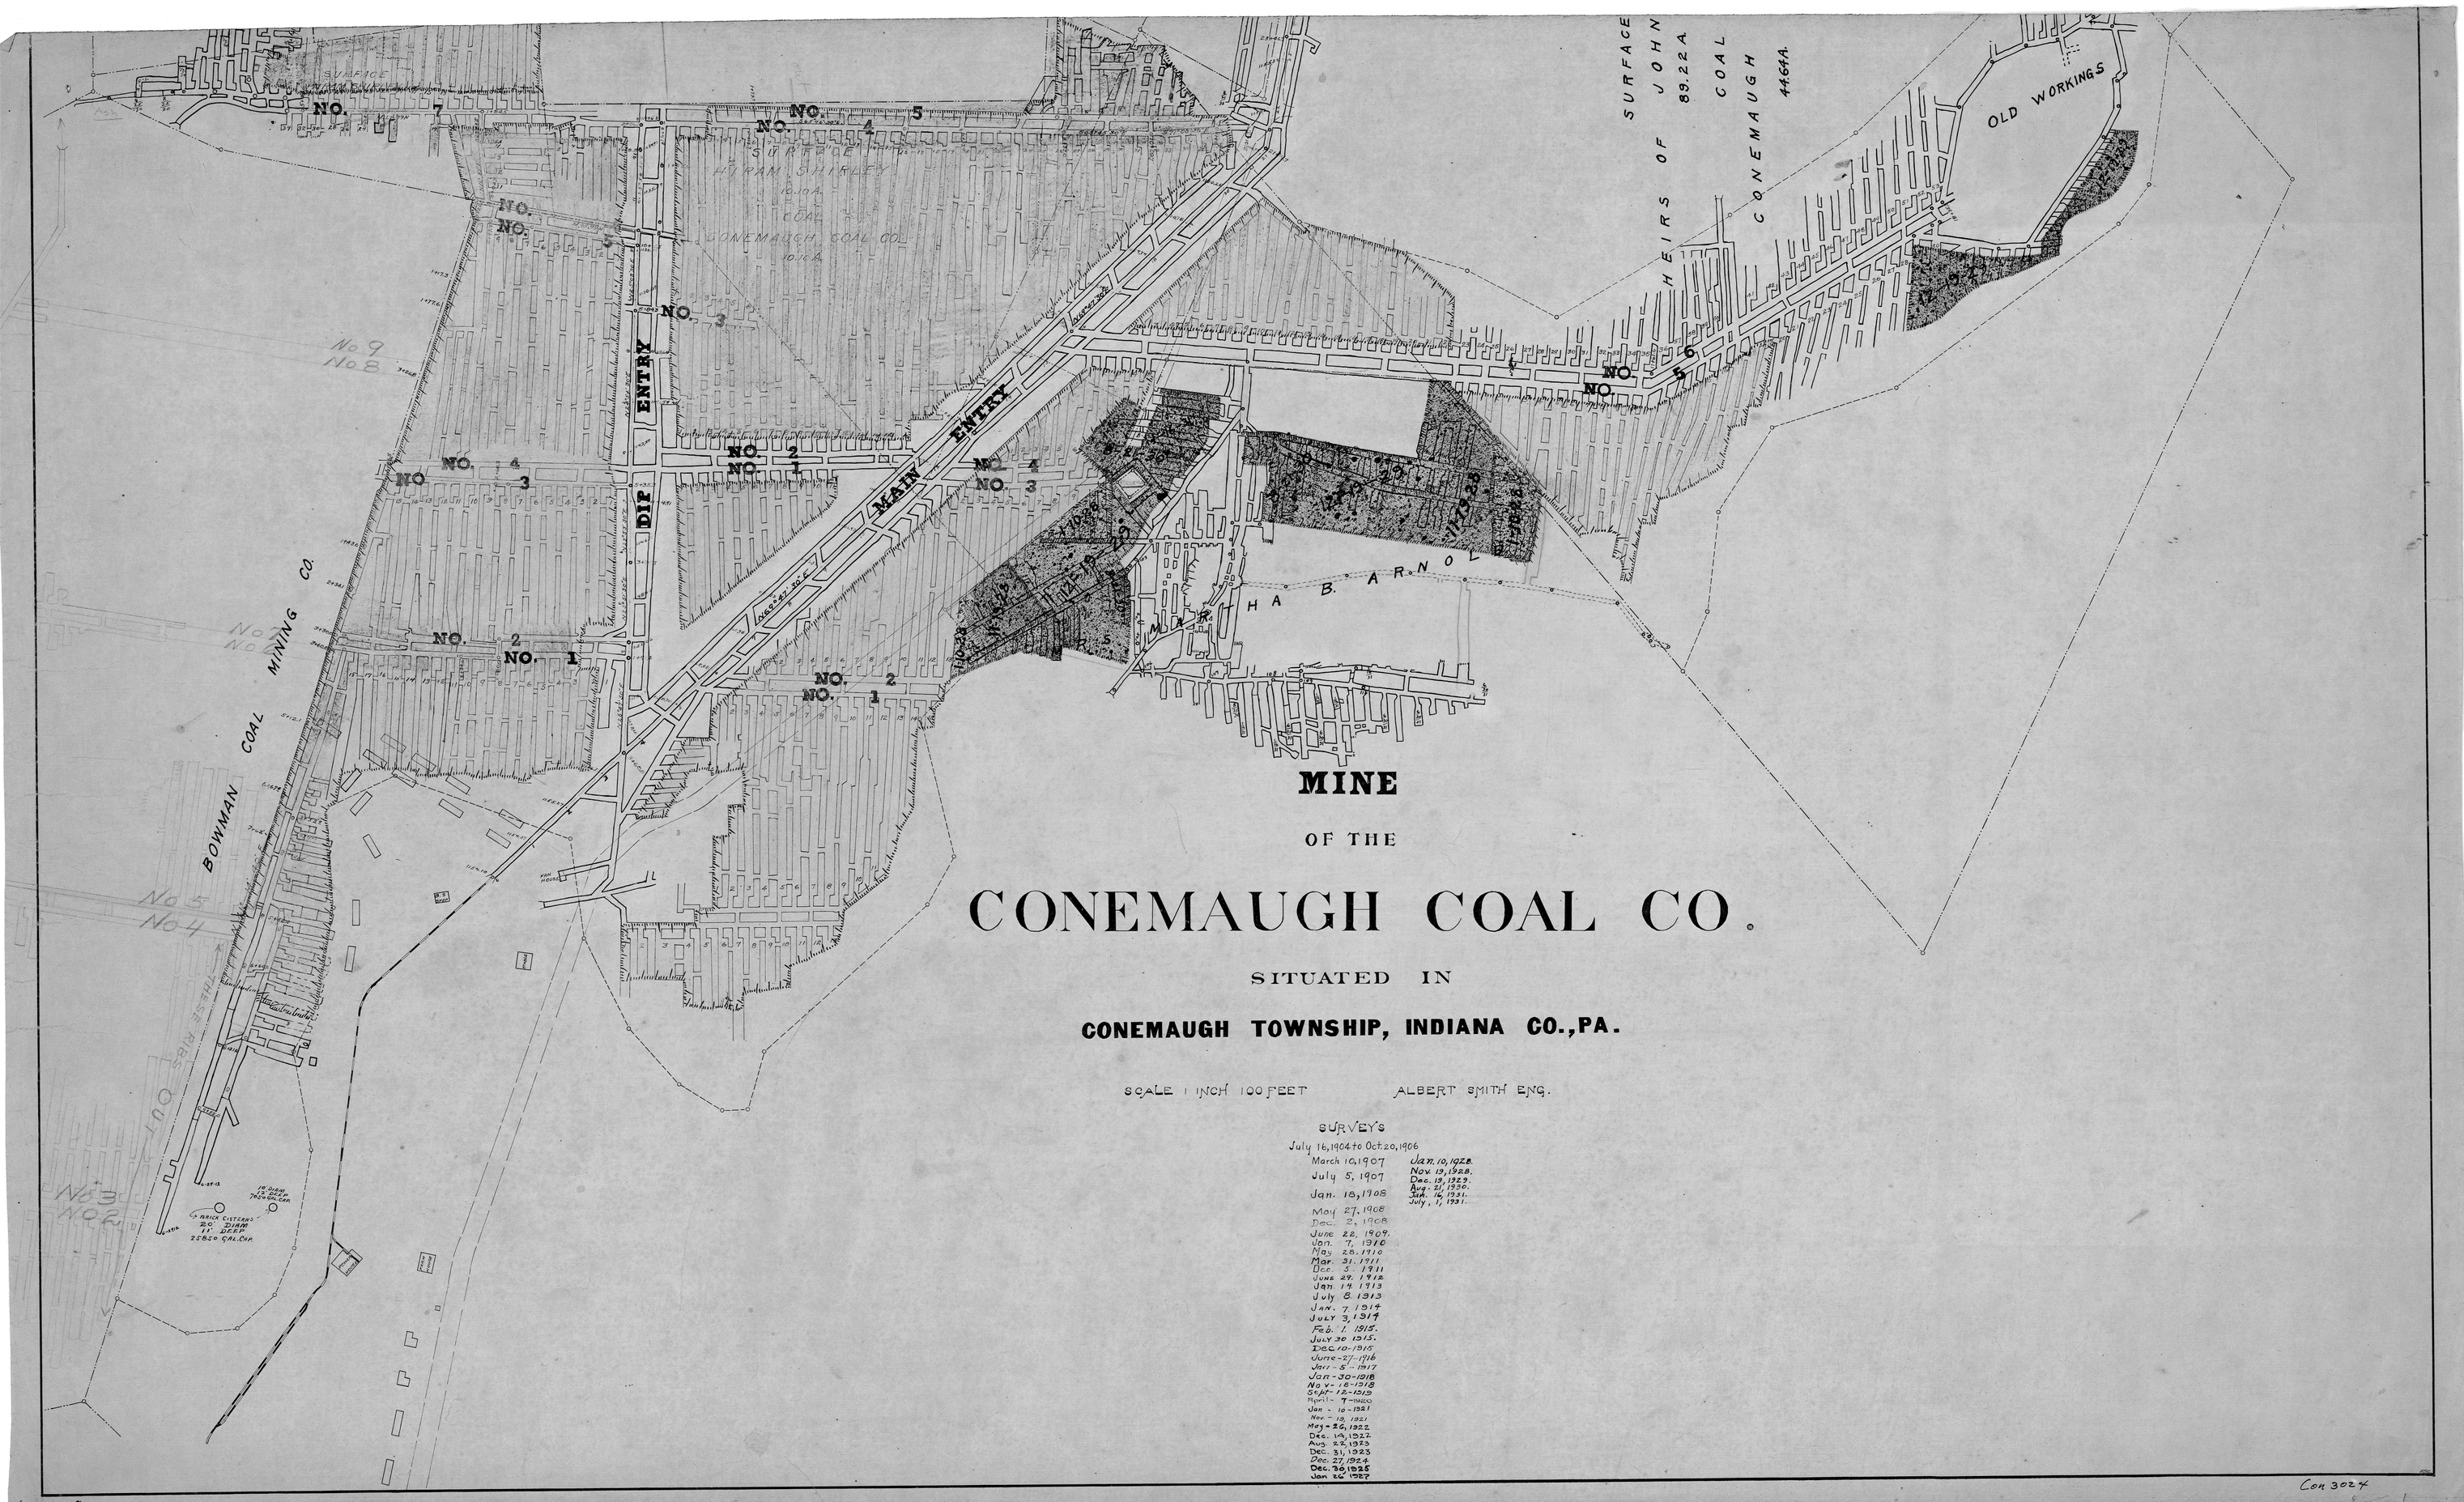

MINE

OF THE

CONEMAUGH COAL CO.

SITUATED IN

CONEMAUGH TOWNSHIP, INDIANA CO., PA.

SCALE 1 INCH 100 FEET ALBERT SMITH ENG.

SURVEYS

July 16, 1904 to Oct. 20, 1906
March 16, 1907
July 5, 1907
Jan. 18, 1908
May 27, 1908
Dec. 2, 1908
June 22, 1909
Jan. 7, 1916
May 28, 1910
Mar. 31, 1911
Dec. 5, 1911
June 29, 1912
Jan. 19 1913
July 8 1913
Jan. 7 1914
July 3, 1914
Feb. 1 1915.
July 30 1915.
Dec 10-1915
June-27-1916
Jan - 5 - 1917
Jan - 20-1918
Nov - 18-1918
Sept - 12-1919
April - 7-1920
Jan - 10-1921
Nov - 18 1921
May - 26, 1922
Dec. 19, 1922
Aug 25, 1923
Dec. 31, 1923
Dec. 27, 1924
Dec. 26 1925
Jan 26 1927
Jan. 10, 1928.
Nov. 13, 1928.
Dec. 19, 1929.
Aug. 21, 1930.
Jan. 14, 1931.
July, 1, 1931.

Con 3024