


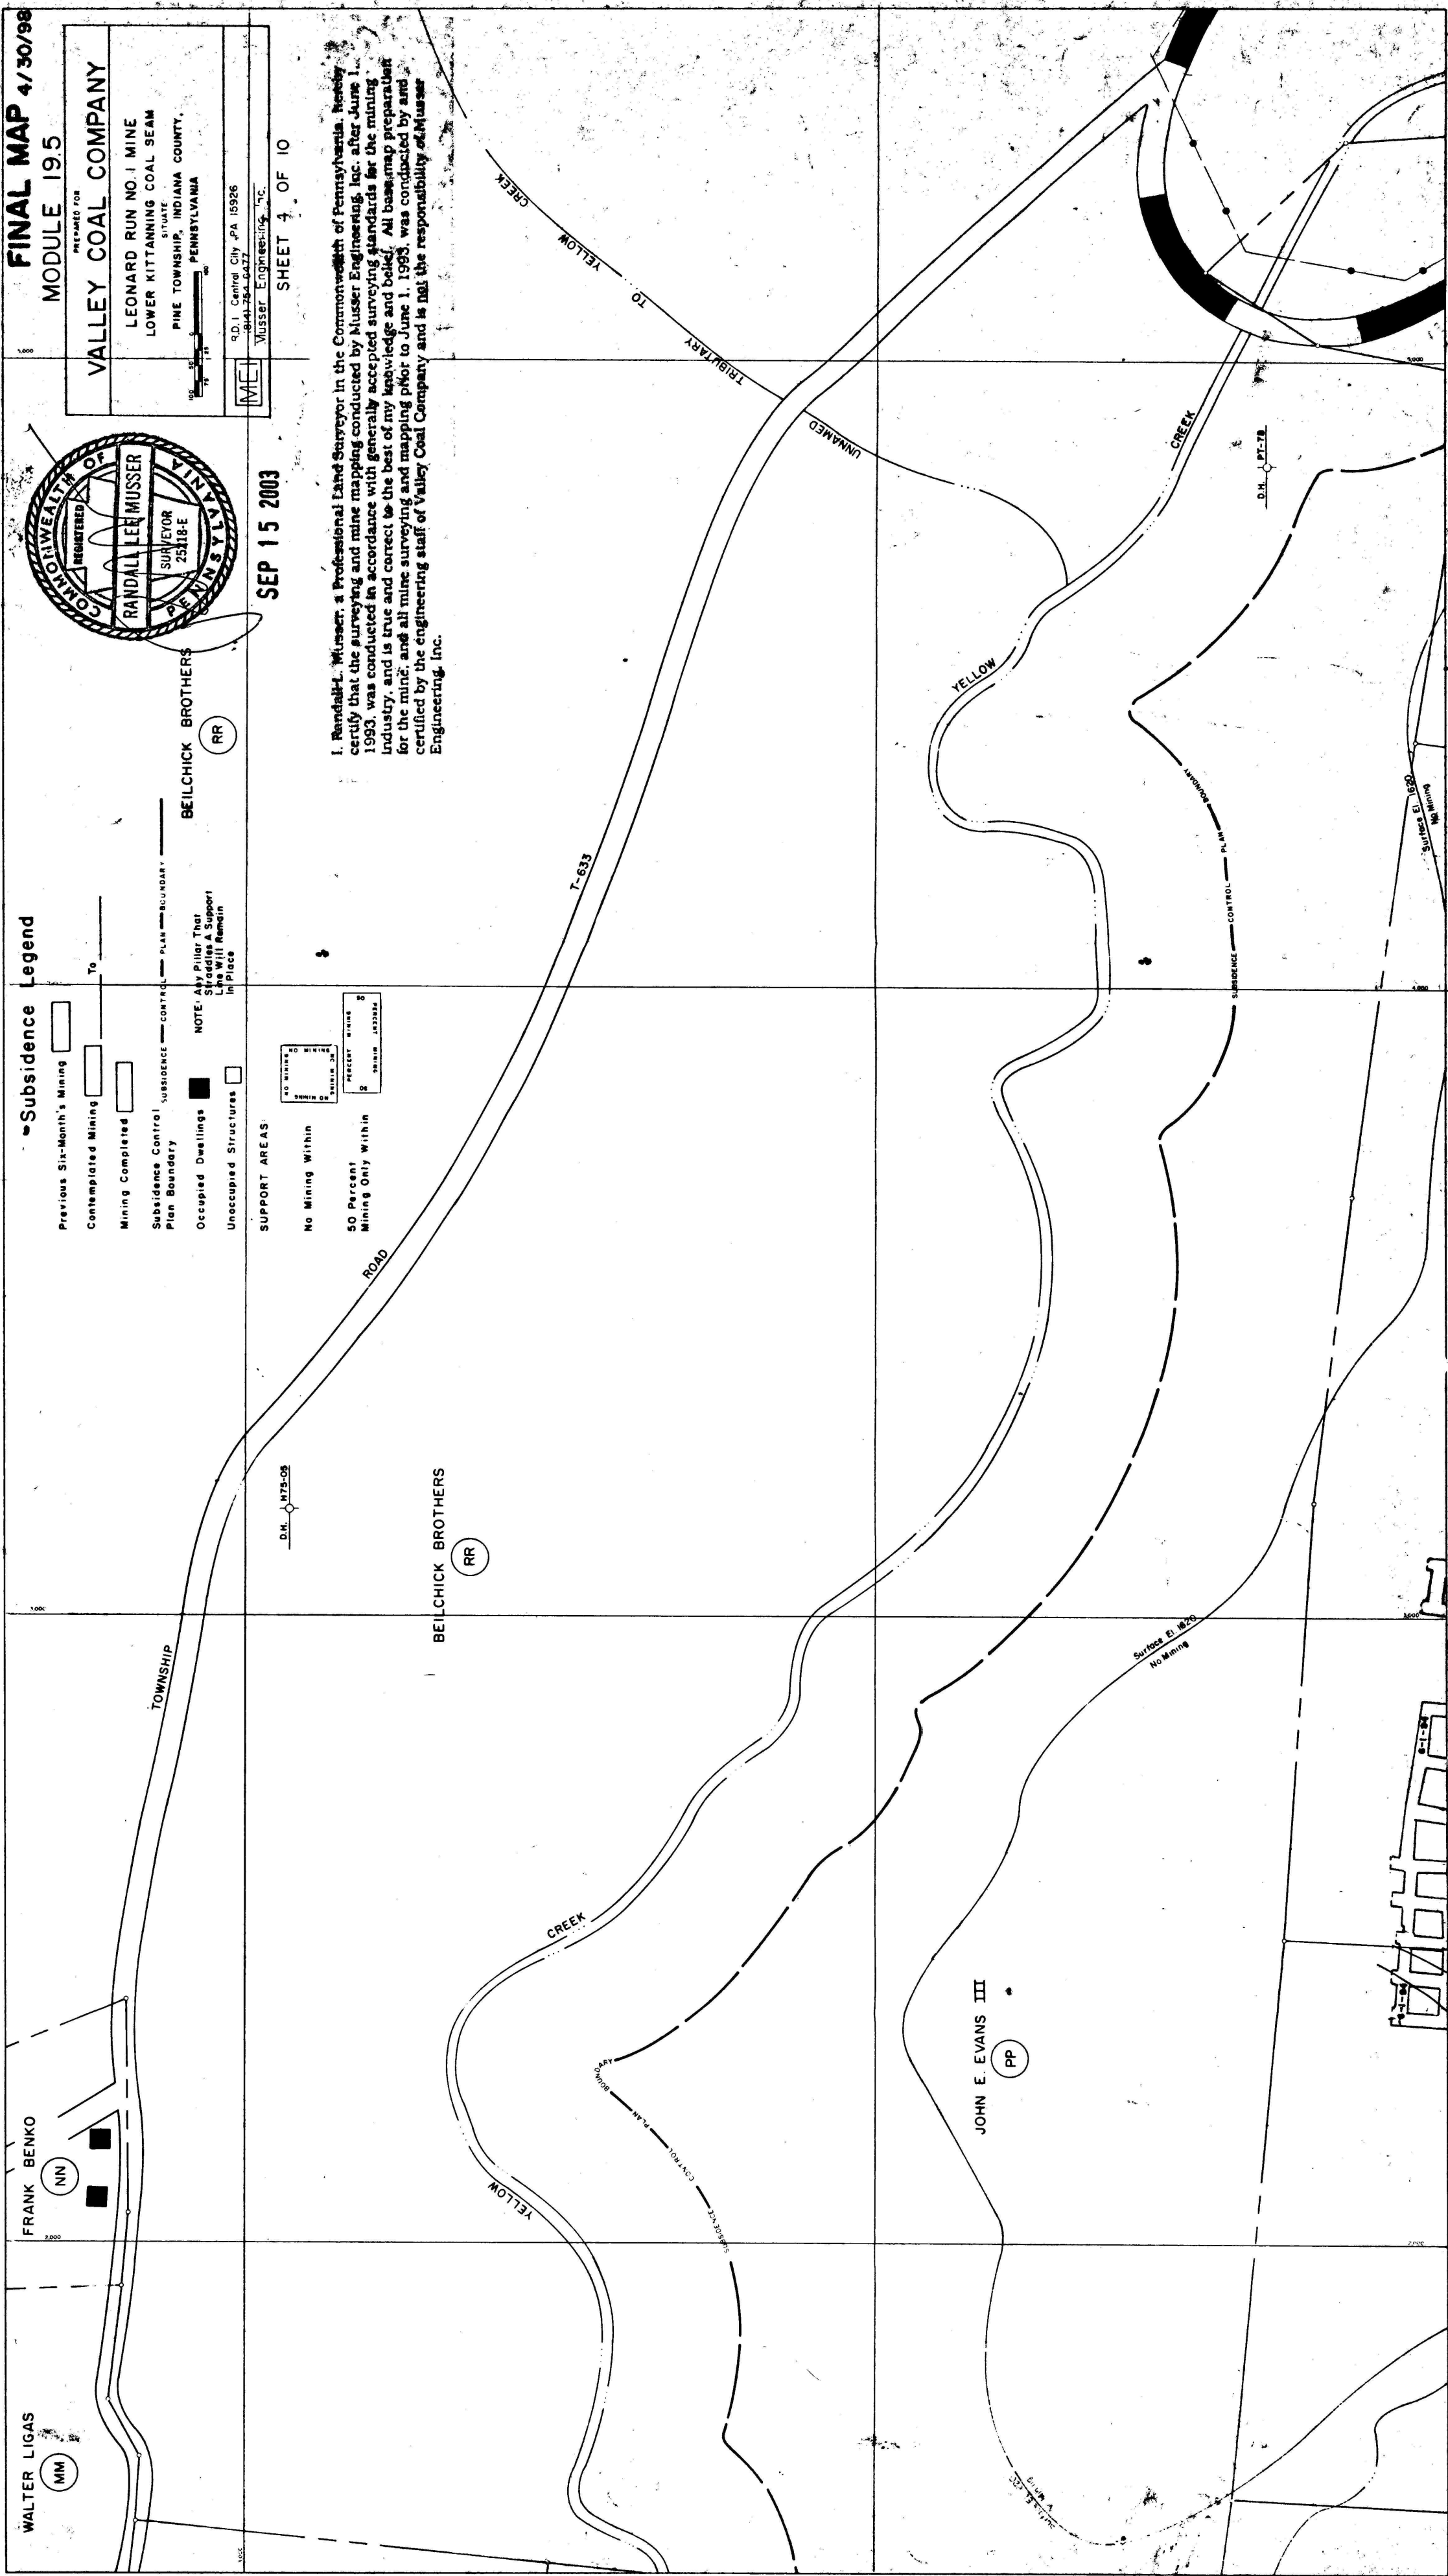

MATCH TO SHEET 5

MATCH TO SHEET '3