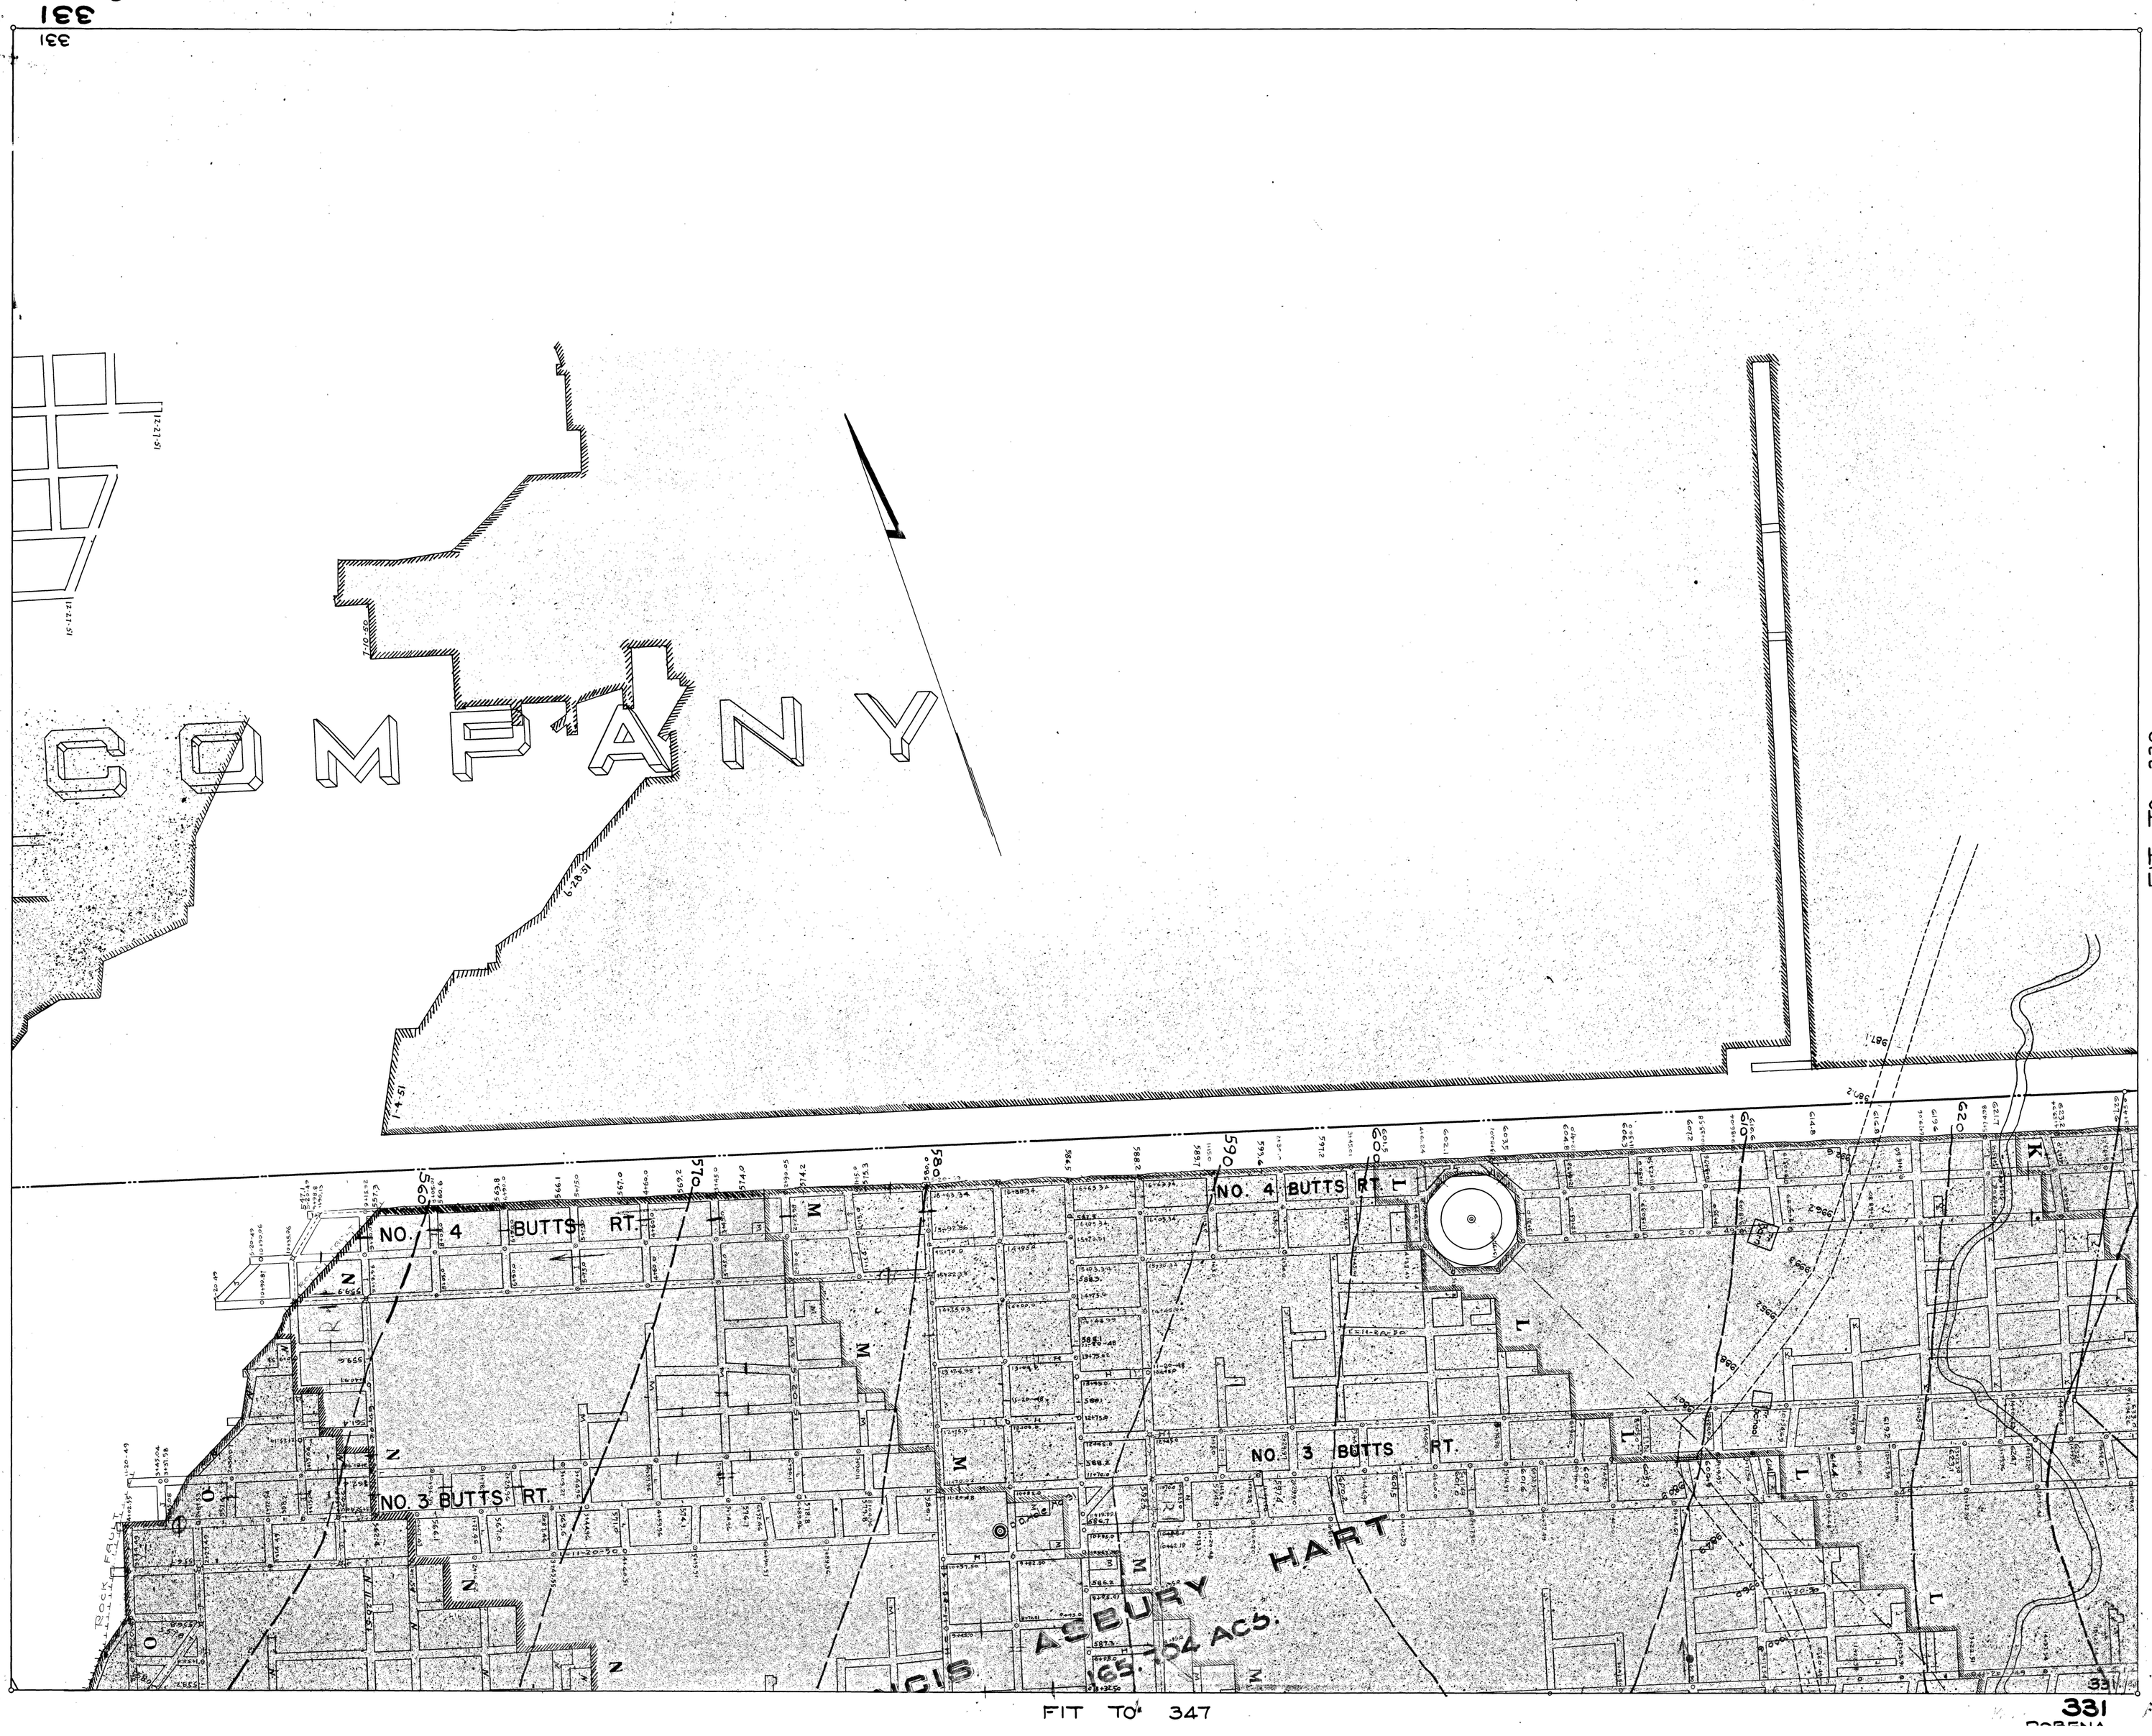
FIT TO 332
FIT TO 330
FIT TO 347
COMPANY
NO. 4 BUTTS RT.
NO. 3 BUTTS RT.
NO. 4 BUTTS RT.
NO. 3 BUTTS RT.
ROCK FALL
ASBURY HART
165.704 ACS.
331