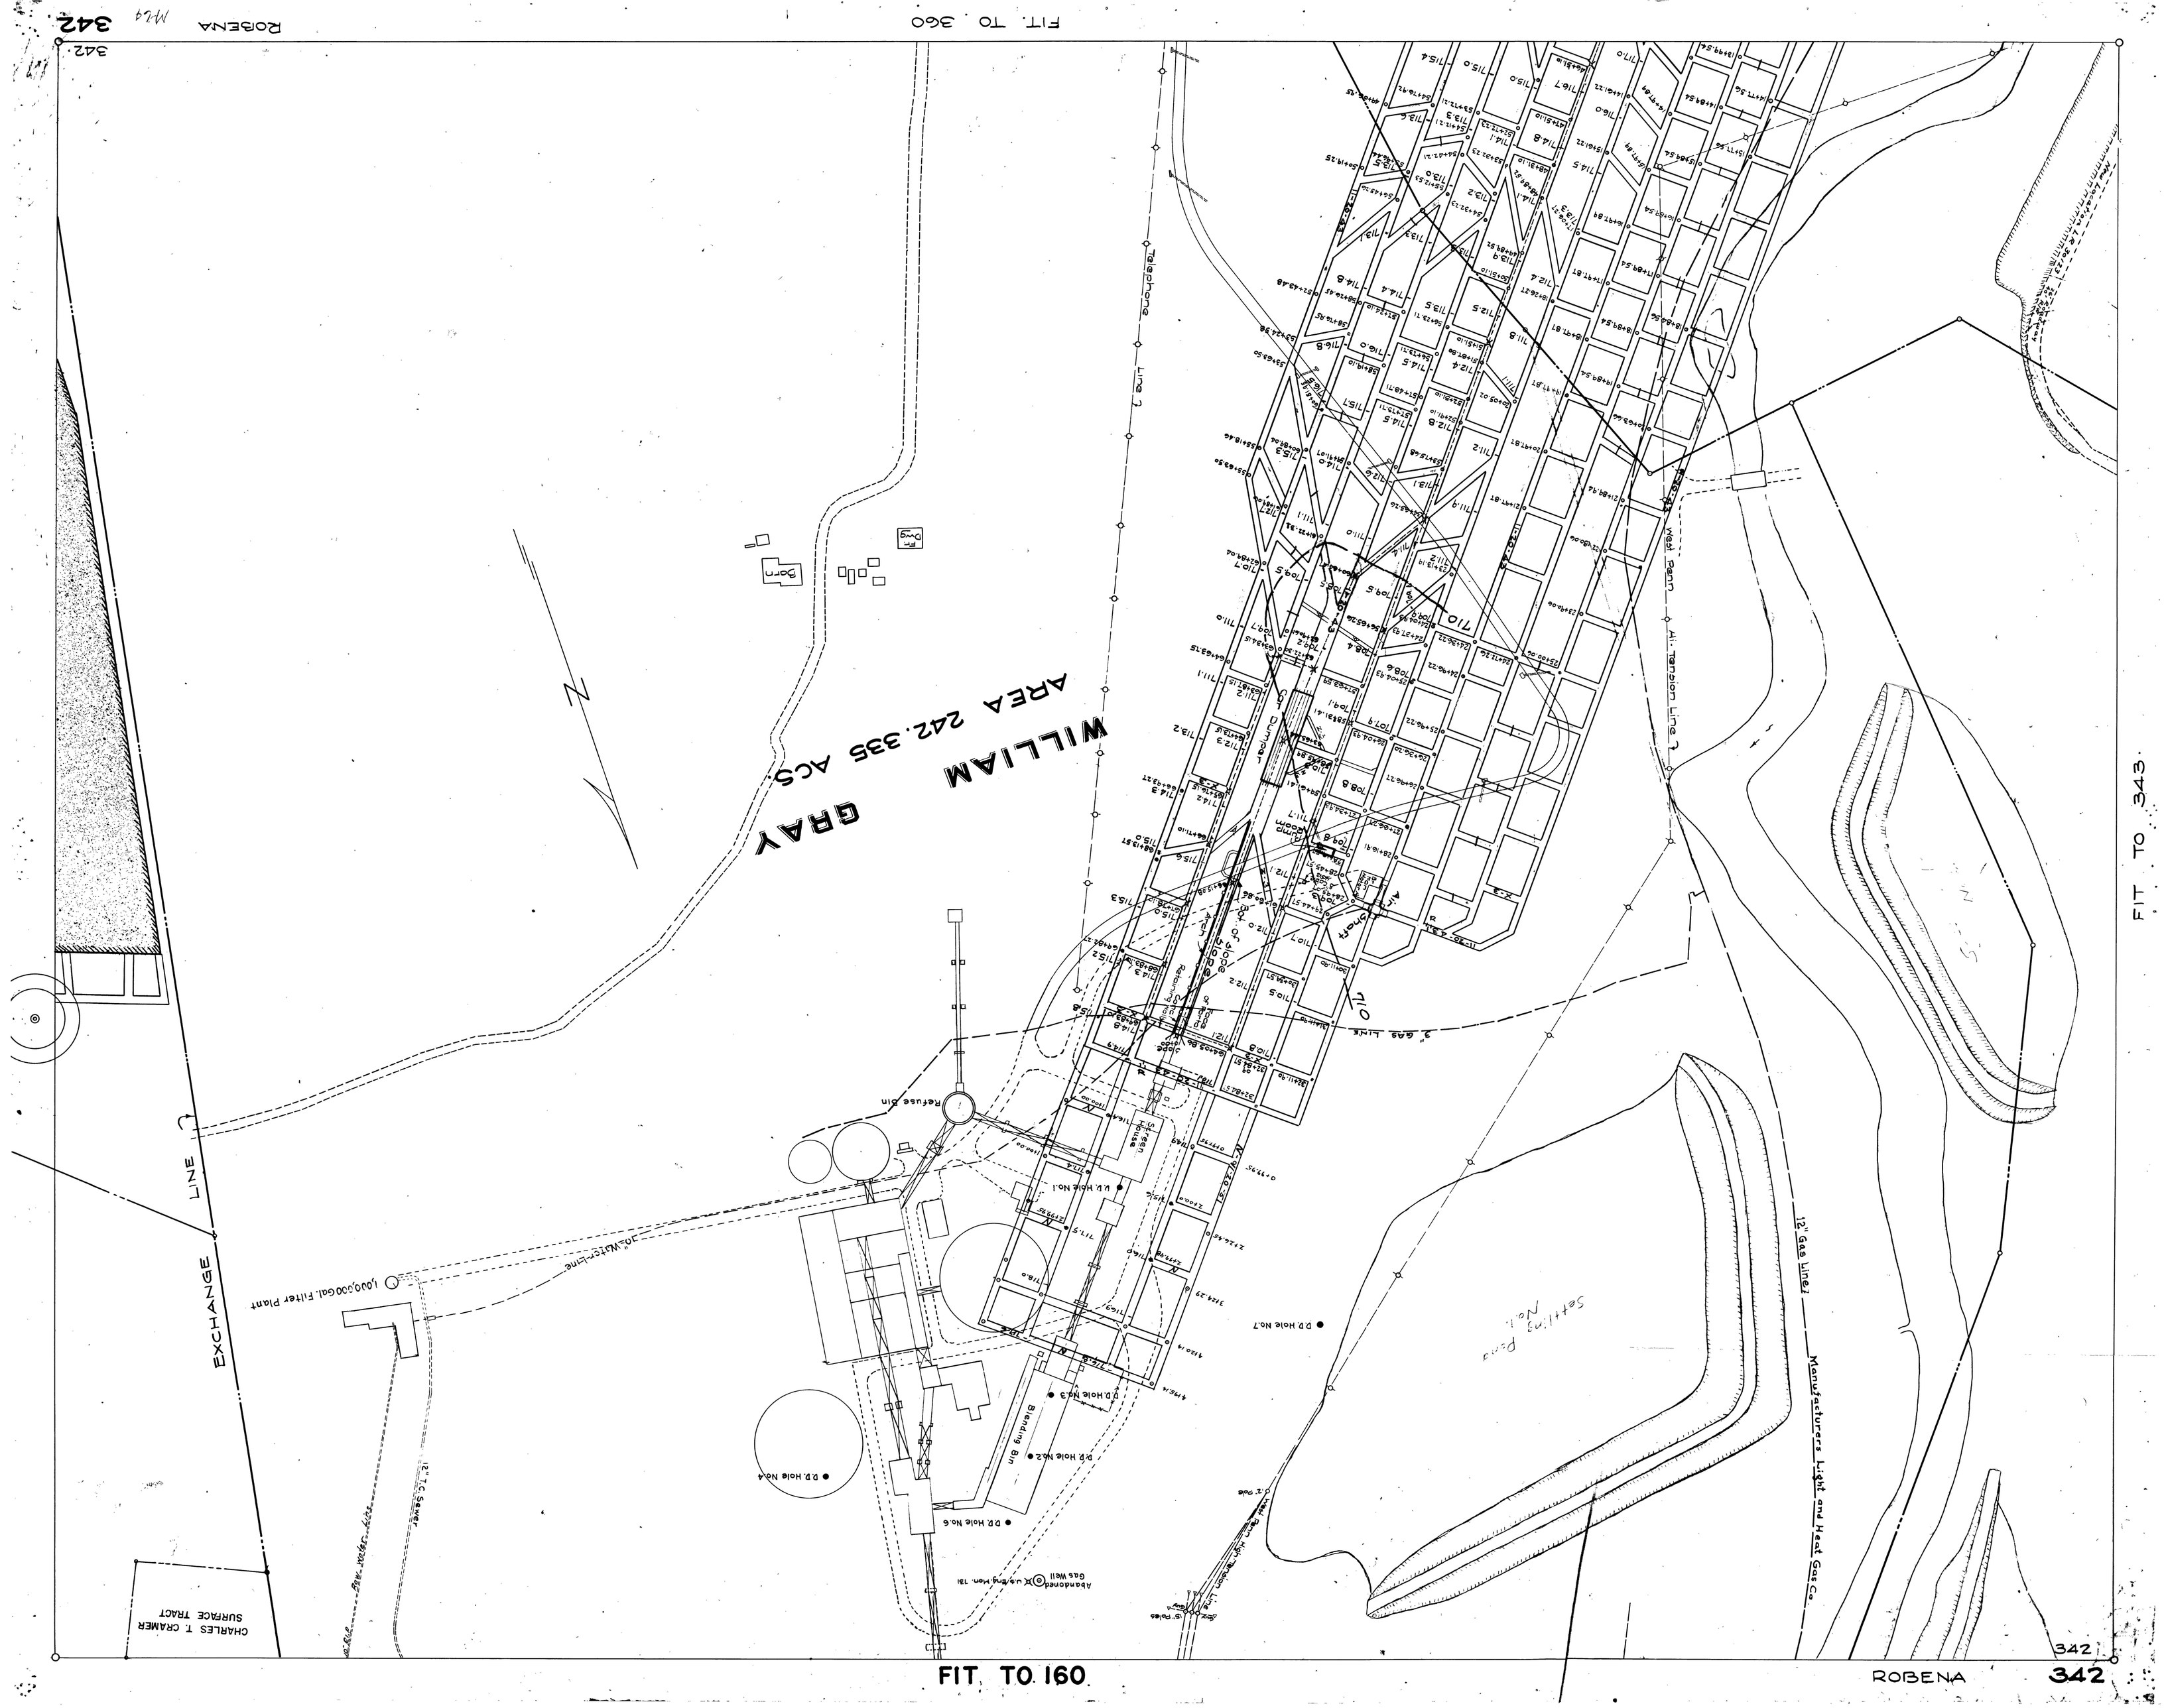
FIT. TO 360
ROBENA
342
WILLIAM GRAY
AREA 242.335 ACS.
Telephone Line
Barn
Dwg
