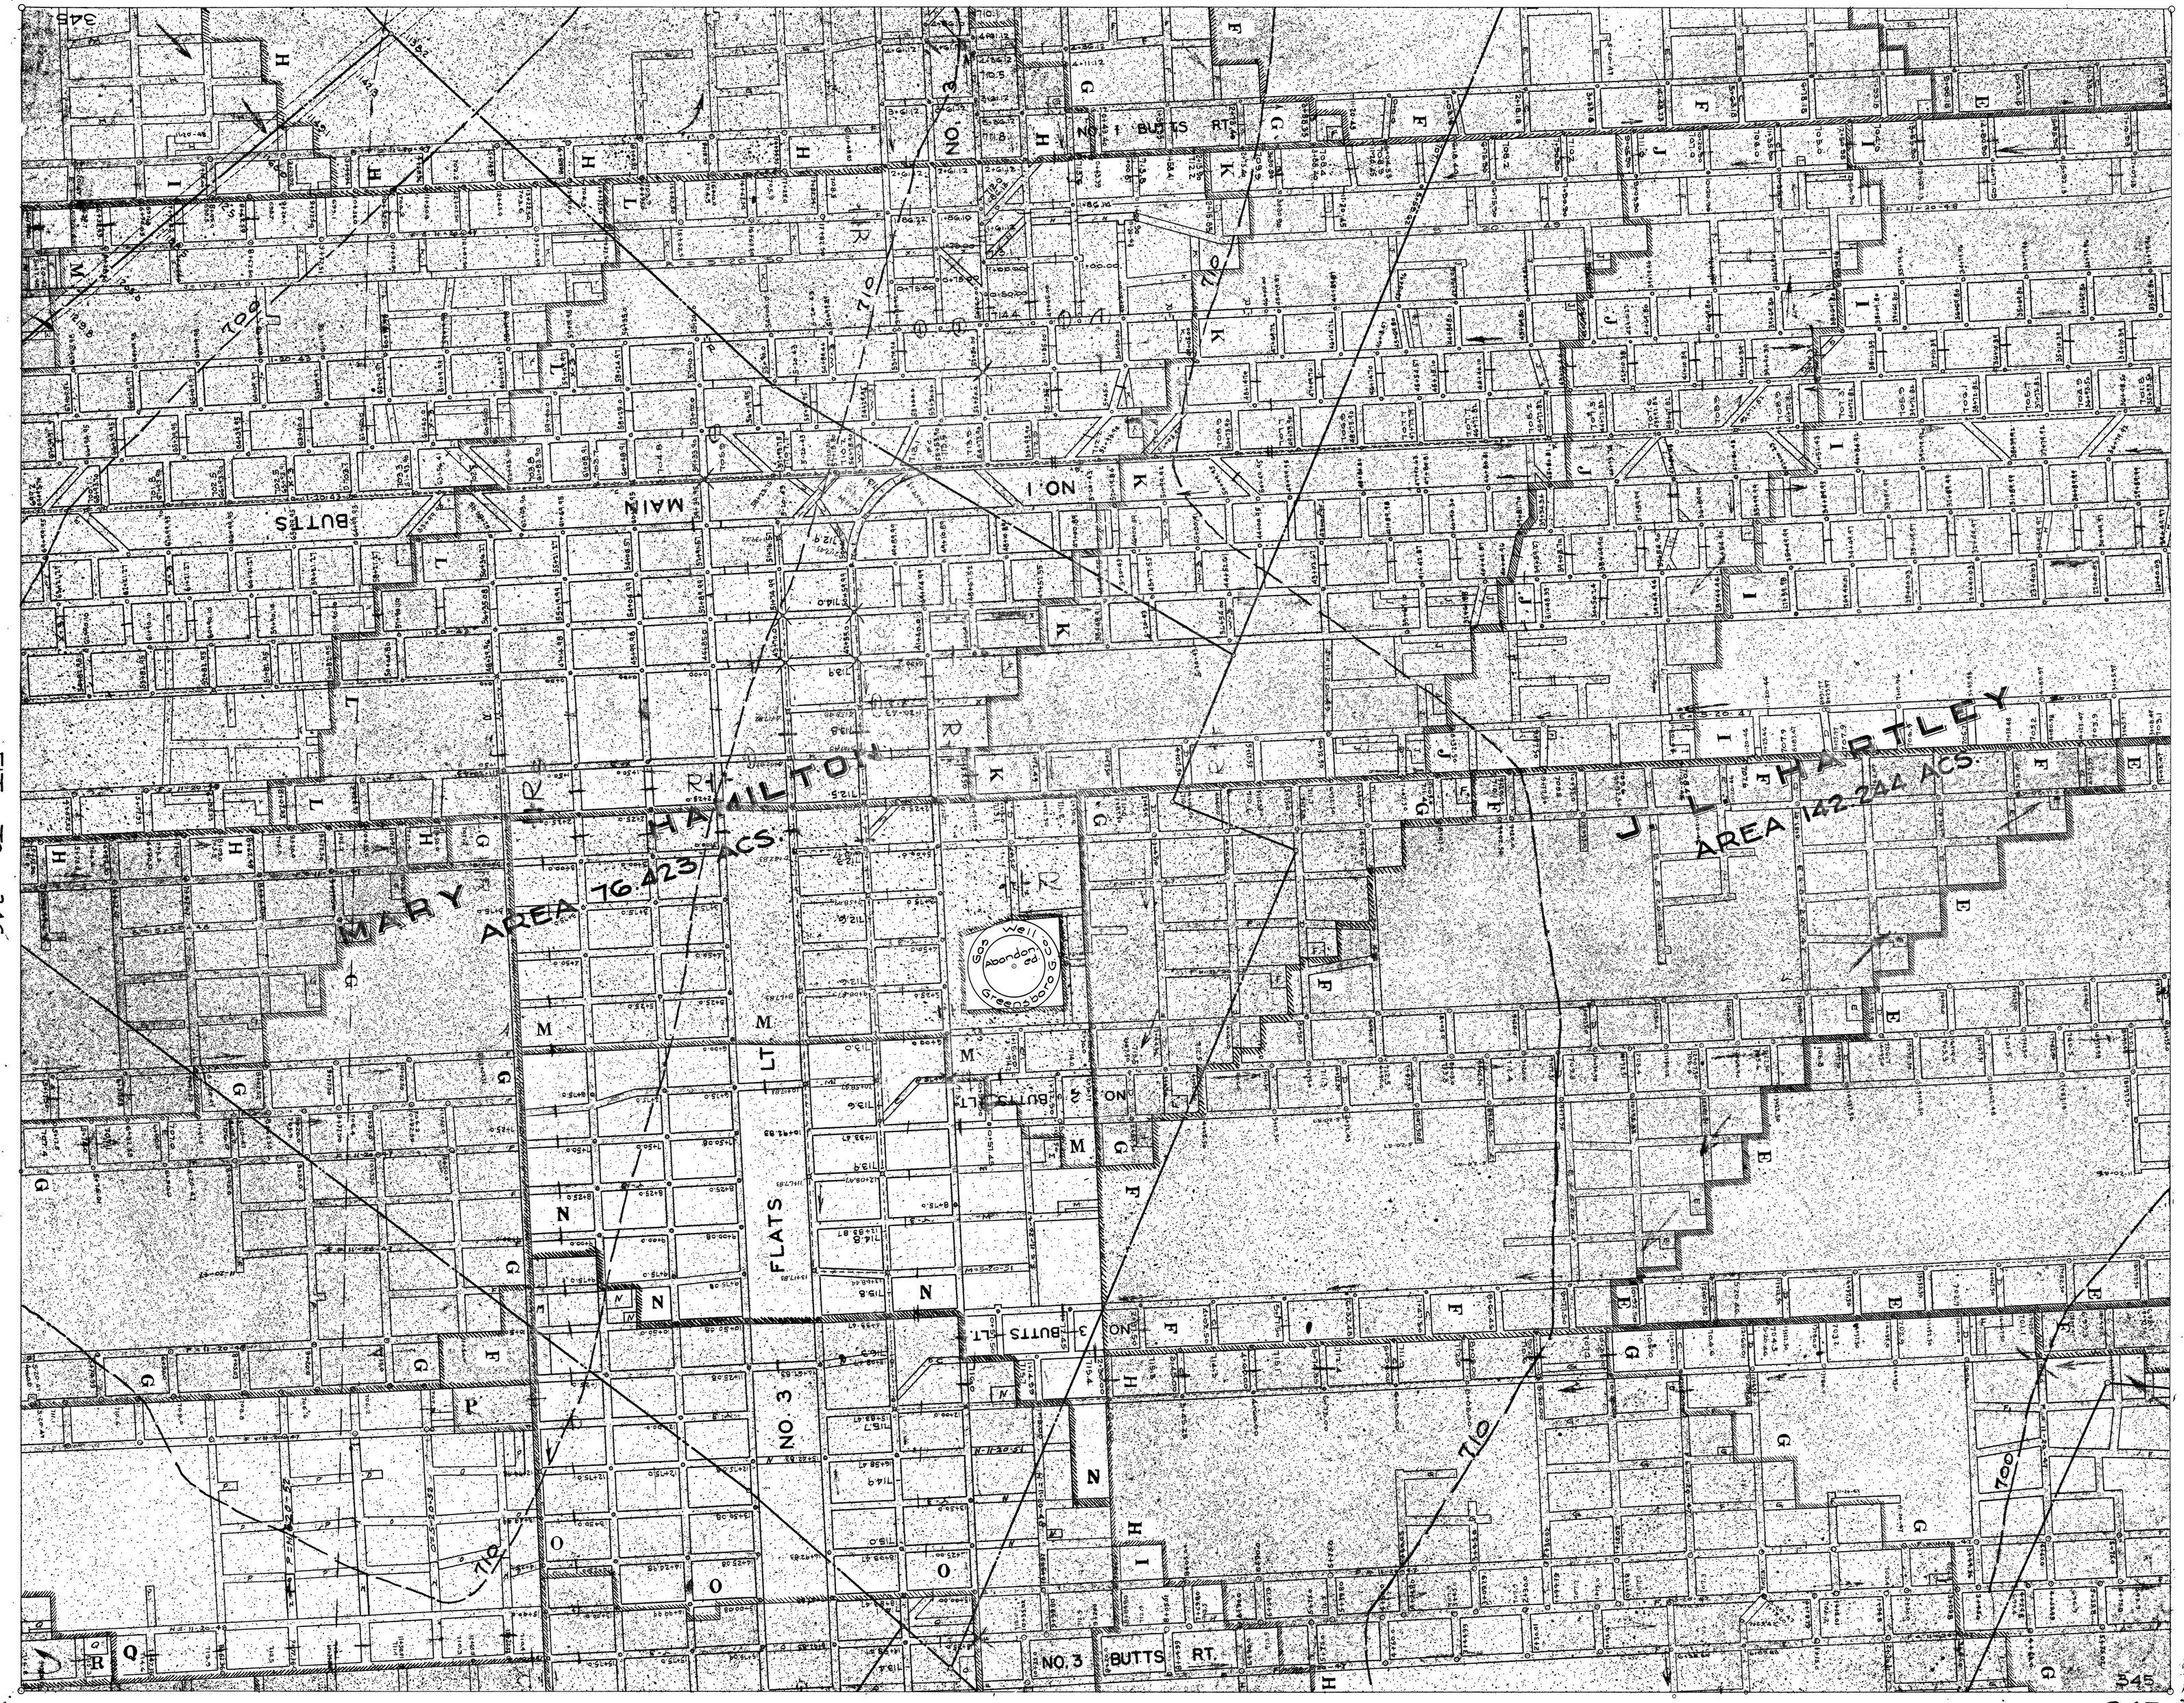
MARY HAMILTON
AREA 76.423 ACS.
J. L. HARTLEY
AREA 142.244 ACS.
Gas Well Abandoned Greensboro G.Co.
NO. 1 BUTTS RT.
NO. 1 MAIN BUTTS
NO. 2 BUTTS LT.
NO. 3 BUTTS LT.
NO. 3 BUTTS RT.
NO. 3 FLATS LT.
700
710
710
700
345