FIT TO 350

ROBENA 349

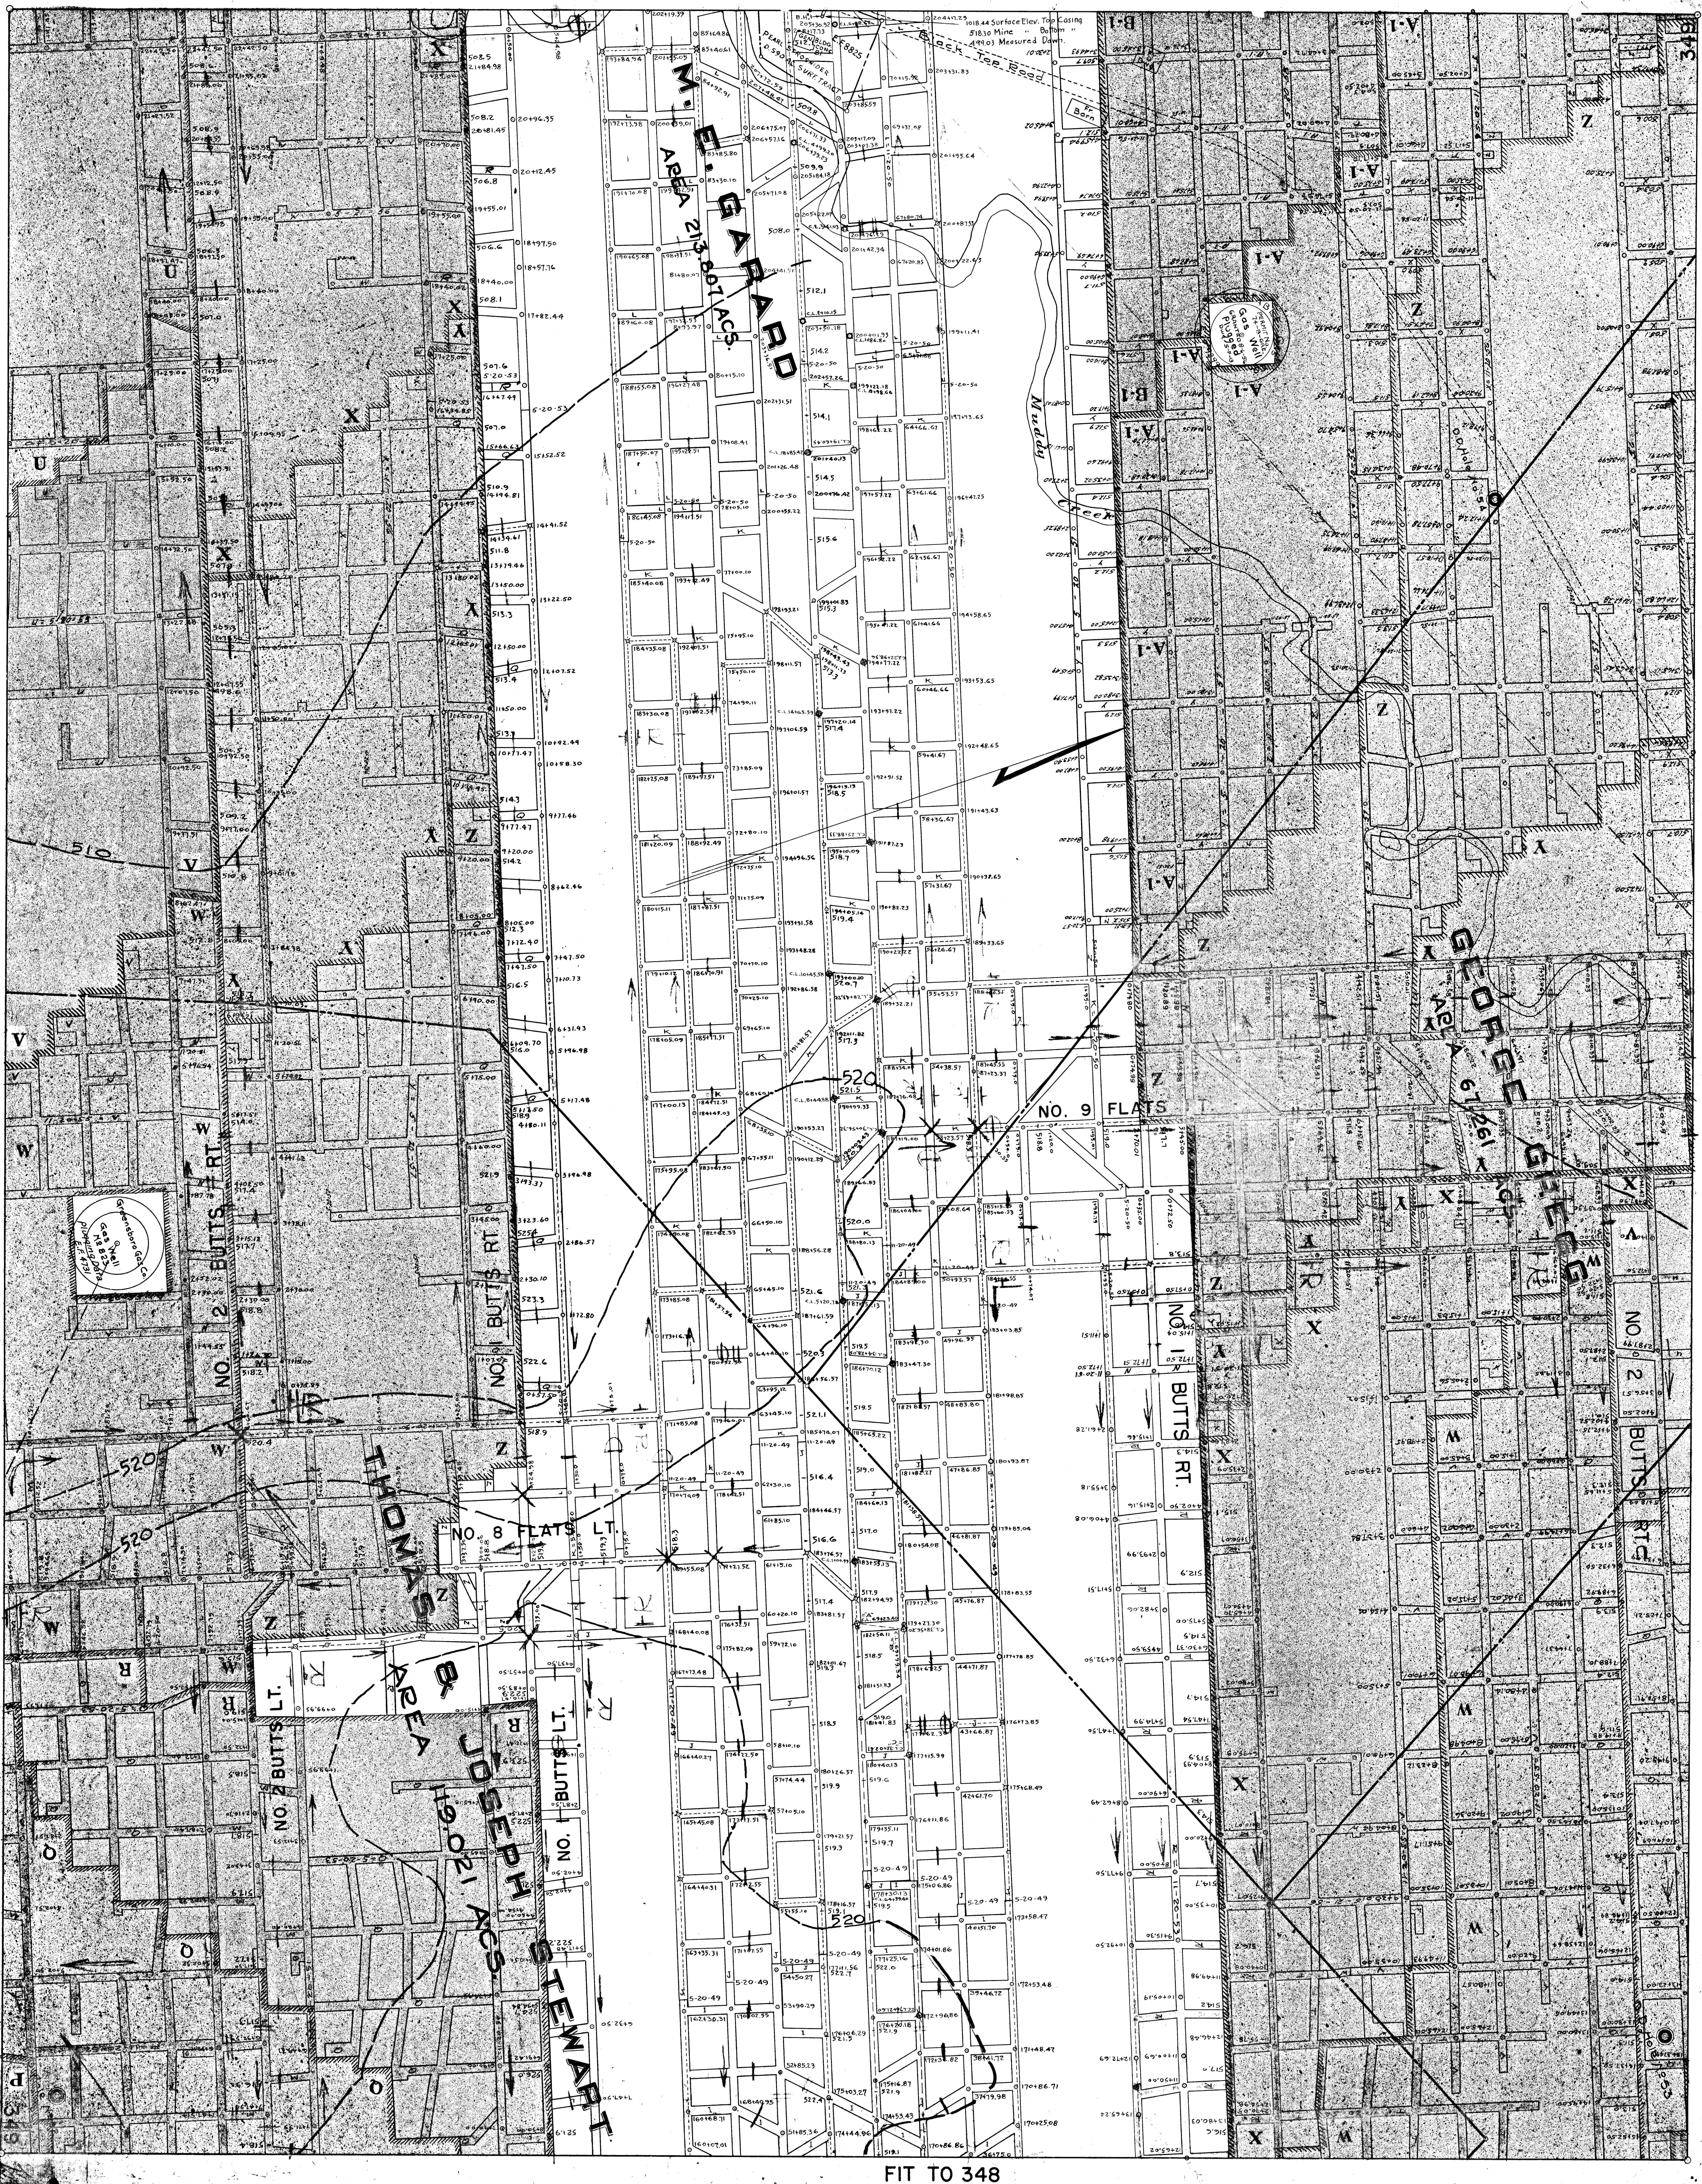
M. E. GARARD
AREA 213.807 ACS.
GEORGE GREGG
AREA 67.261 ACS.
THOMAS & JOSEPH STEWART
AREA 119.021 ACS.
NO. 9 FLATS RT.
NO. 8 FLATS LT.
NO. 2 BUTTS RT.
NO. 1 BUTTS RT.
NO. 2 BUTTS LT.
NO. 1 BUTTS LT.
NO. 1 BUTTS RT.
NO. 2 BUTTS RT.C
Muddy Creek
Black Top Road
Fr. Barn
1018.44 Surface Elev. Top Casing
518.30 Mine " Bottom "
499.03 Measured Down.
PEARL SNIDER SURF. TRACT 0.590 AC.
GEN. BLDG. CONC.
E.F. 8825
PERMIT No. 74-13-GRE.
Gas Well Plugged
Greensboro Gas Co.
Gas Well No 823
Plugging Data E.F. 4731
D.D. Hole No. 54
510
520
A-1
B-1
Z
Y
X
W
V
U
R
Q
P
O

FIT TO 367

FIT TO 333

ROBENA 349

FIT TO 348