



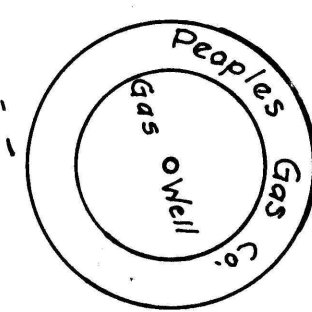

F. MARION BLAKER
AREA 49.448 ACS.

JASPER AREA
H. WILLIAMSON
49.617 ACS.

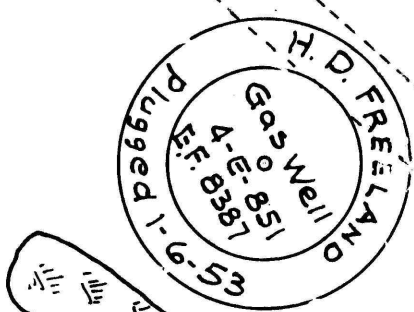

ROBENA ASSIGNMENT

IF THIS CONNECTION IS NOT MADE THEN LEAVE TWO BLEEDERS AROUND ROCK FAULT

MAIN AREA
91' 6" NW

FRANCIS INGHRAM BAILLY
AREA 35.563 ACS.

