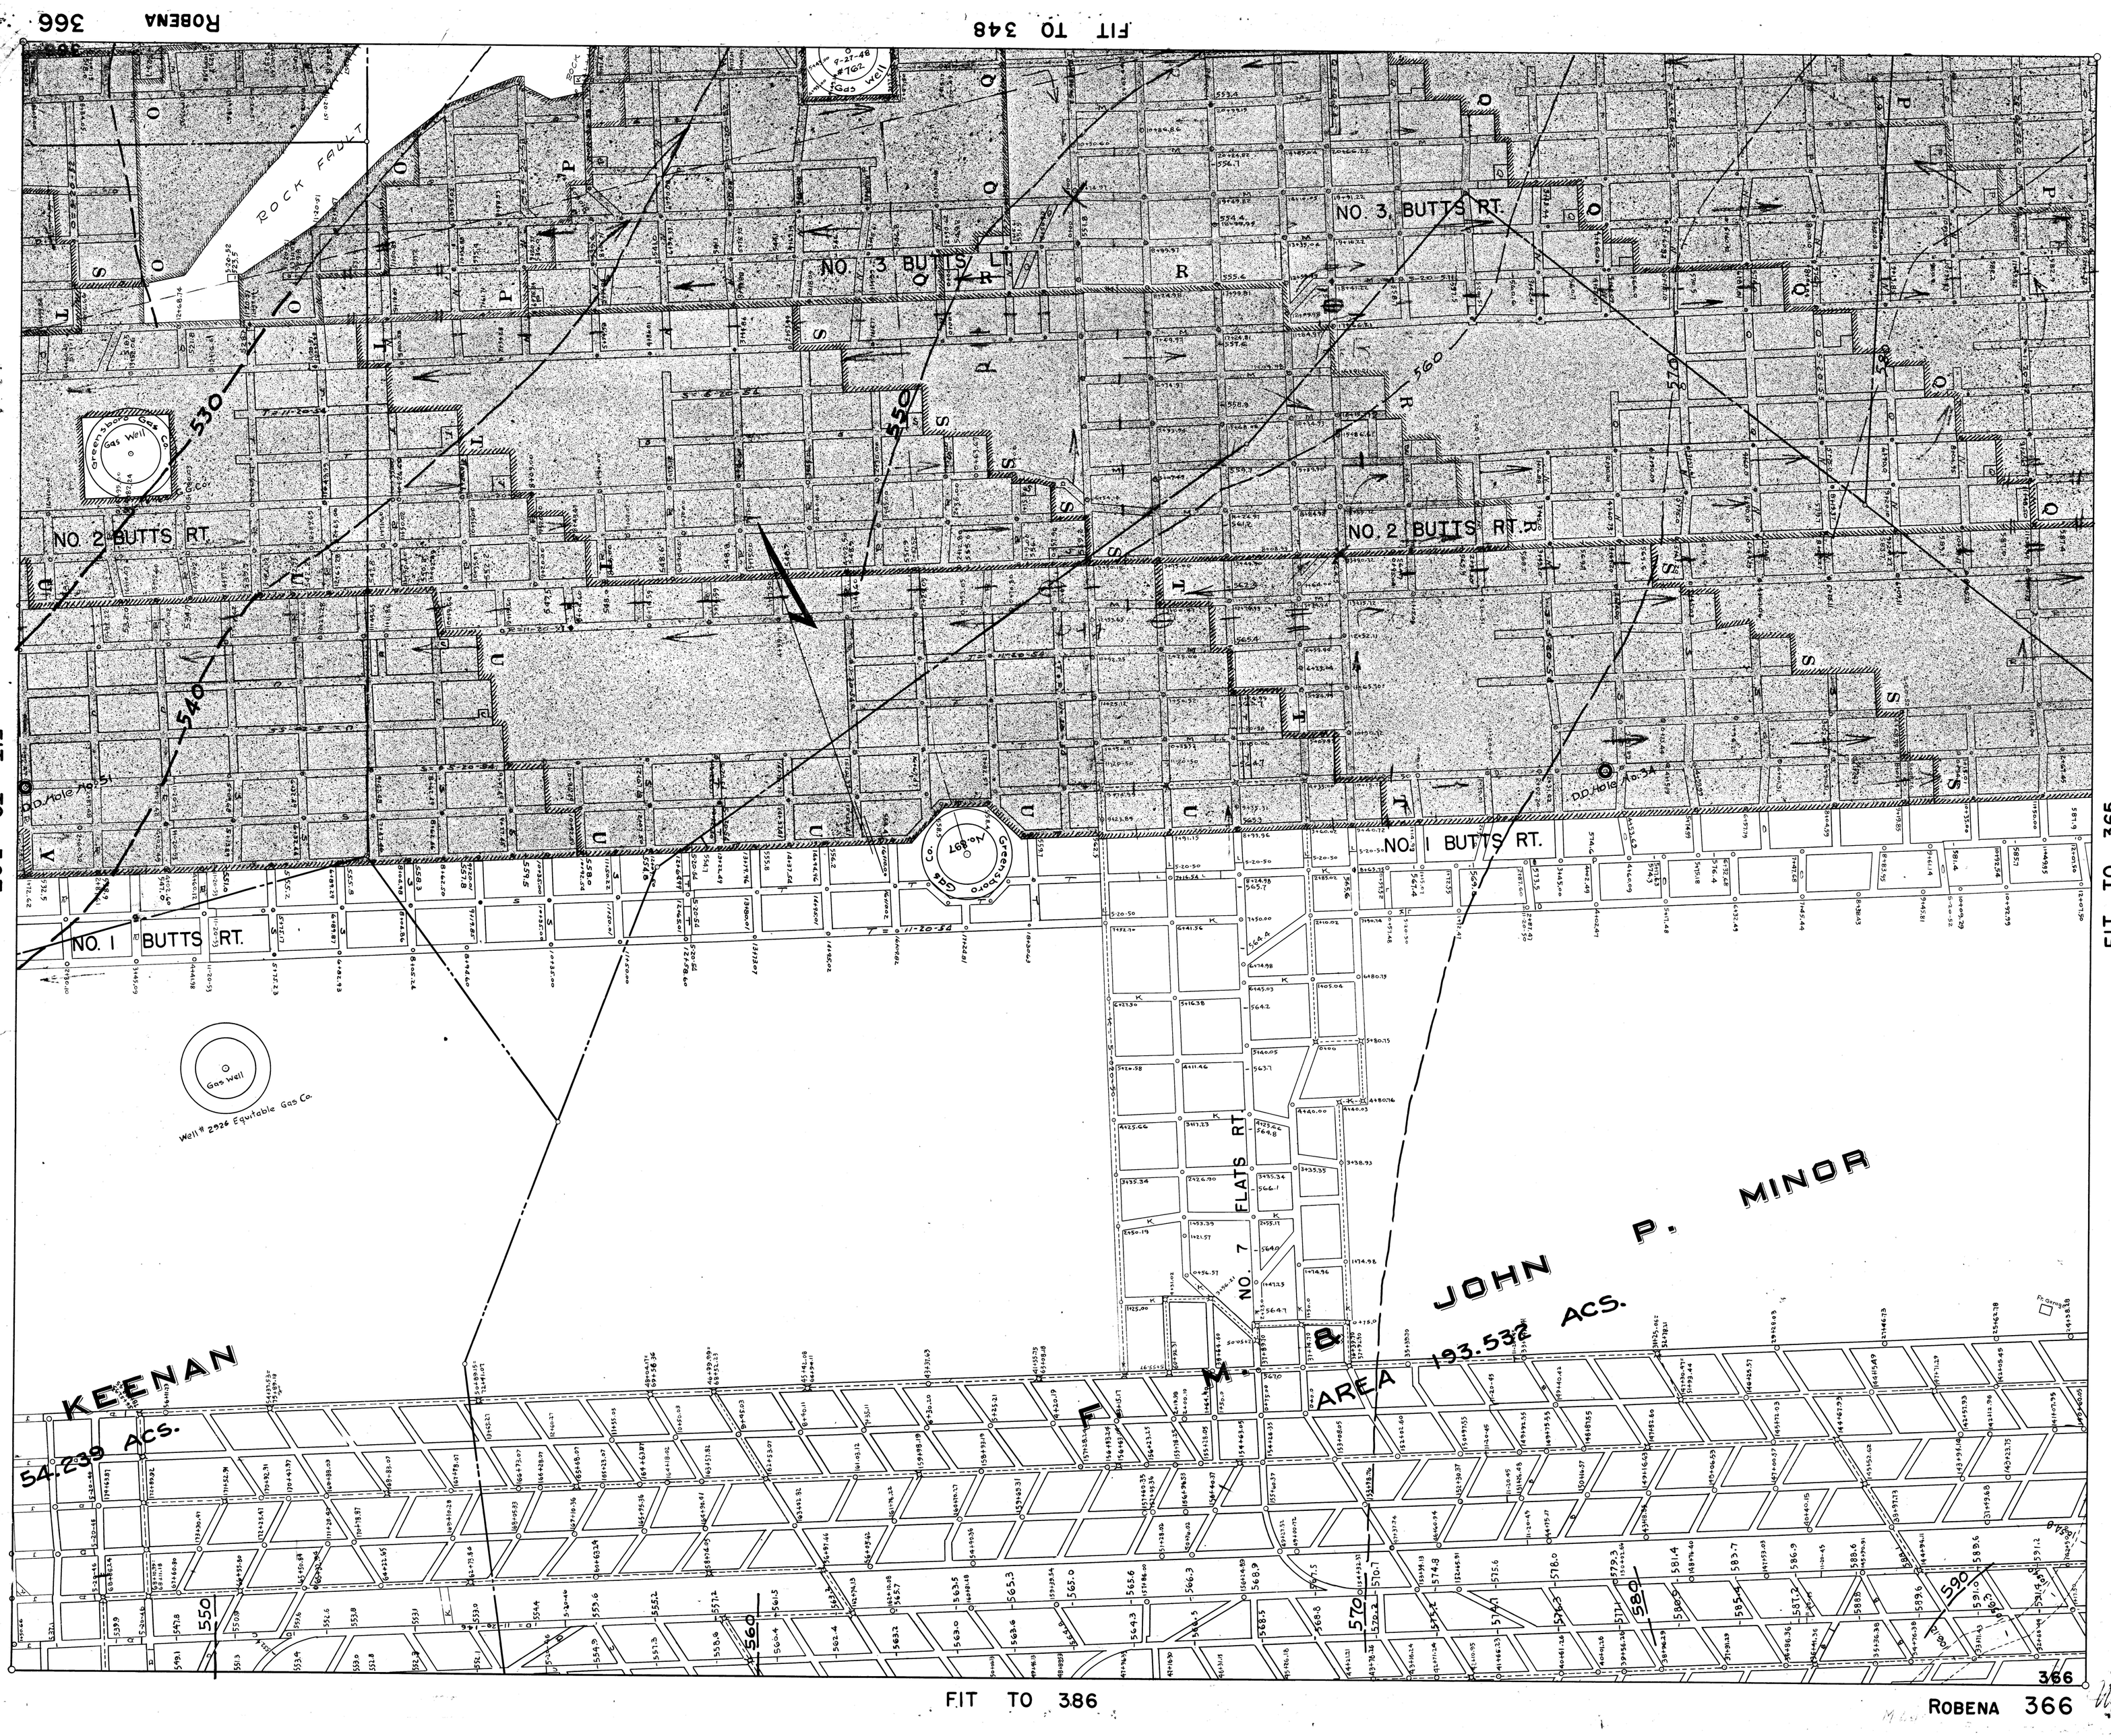

ROBENA 366
FIT TO 348
FIT TO 367
FIT TO 365
FIT TO 386
ROBENA 366
ROCK FAULT
NO. 3 BUTTS LT.
NO. 3 BUTTS RT.
NO. 2 BUTTS RT.
NO. 2 BUTTS RT.
NO. 1 BUTTS RT.
NO. 1 BUTTS RT.
NO. 7 FLATS RT.
Greensboro Gas Co.
Gas Well
Well # 2926 Equitable Gas Co.
D.D. Hole No. 51
D.D. Hole No. 34
KEENAN
54.239 ACS.
F. M. & JOHN P. MINOR
AREA 193.532 ACS.
530
540
550
560
570
580
590