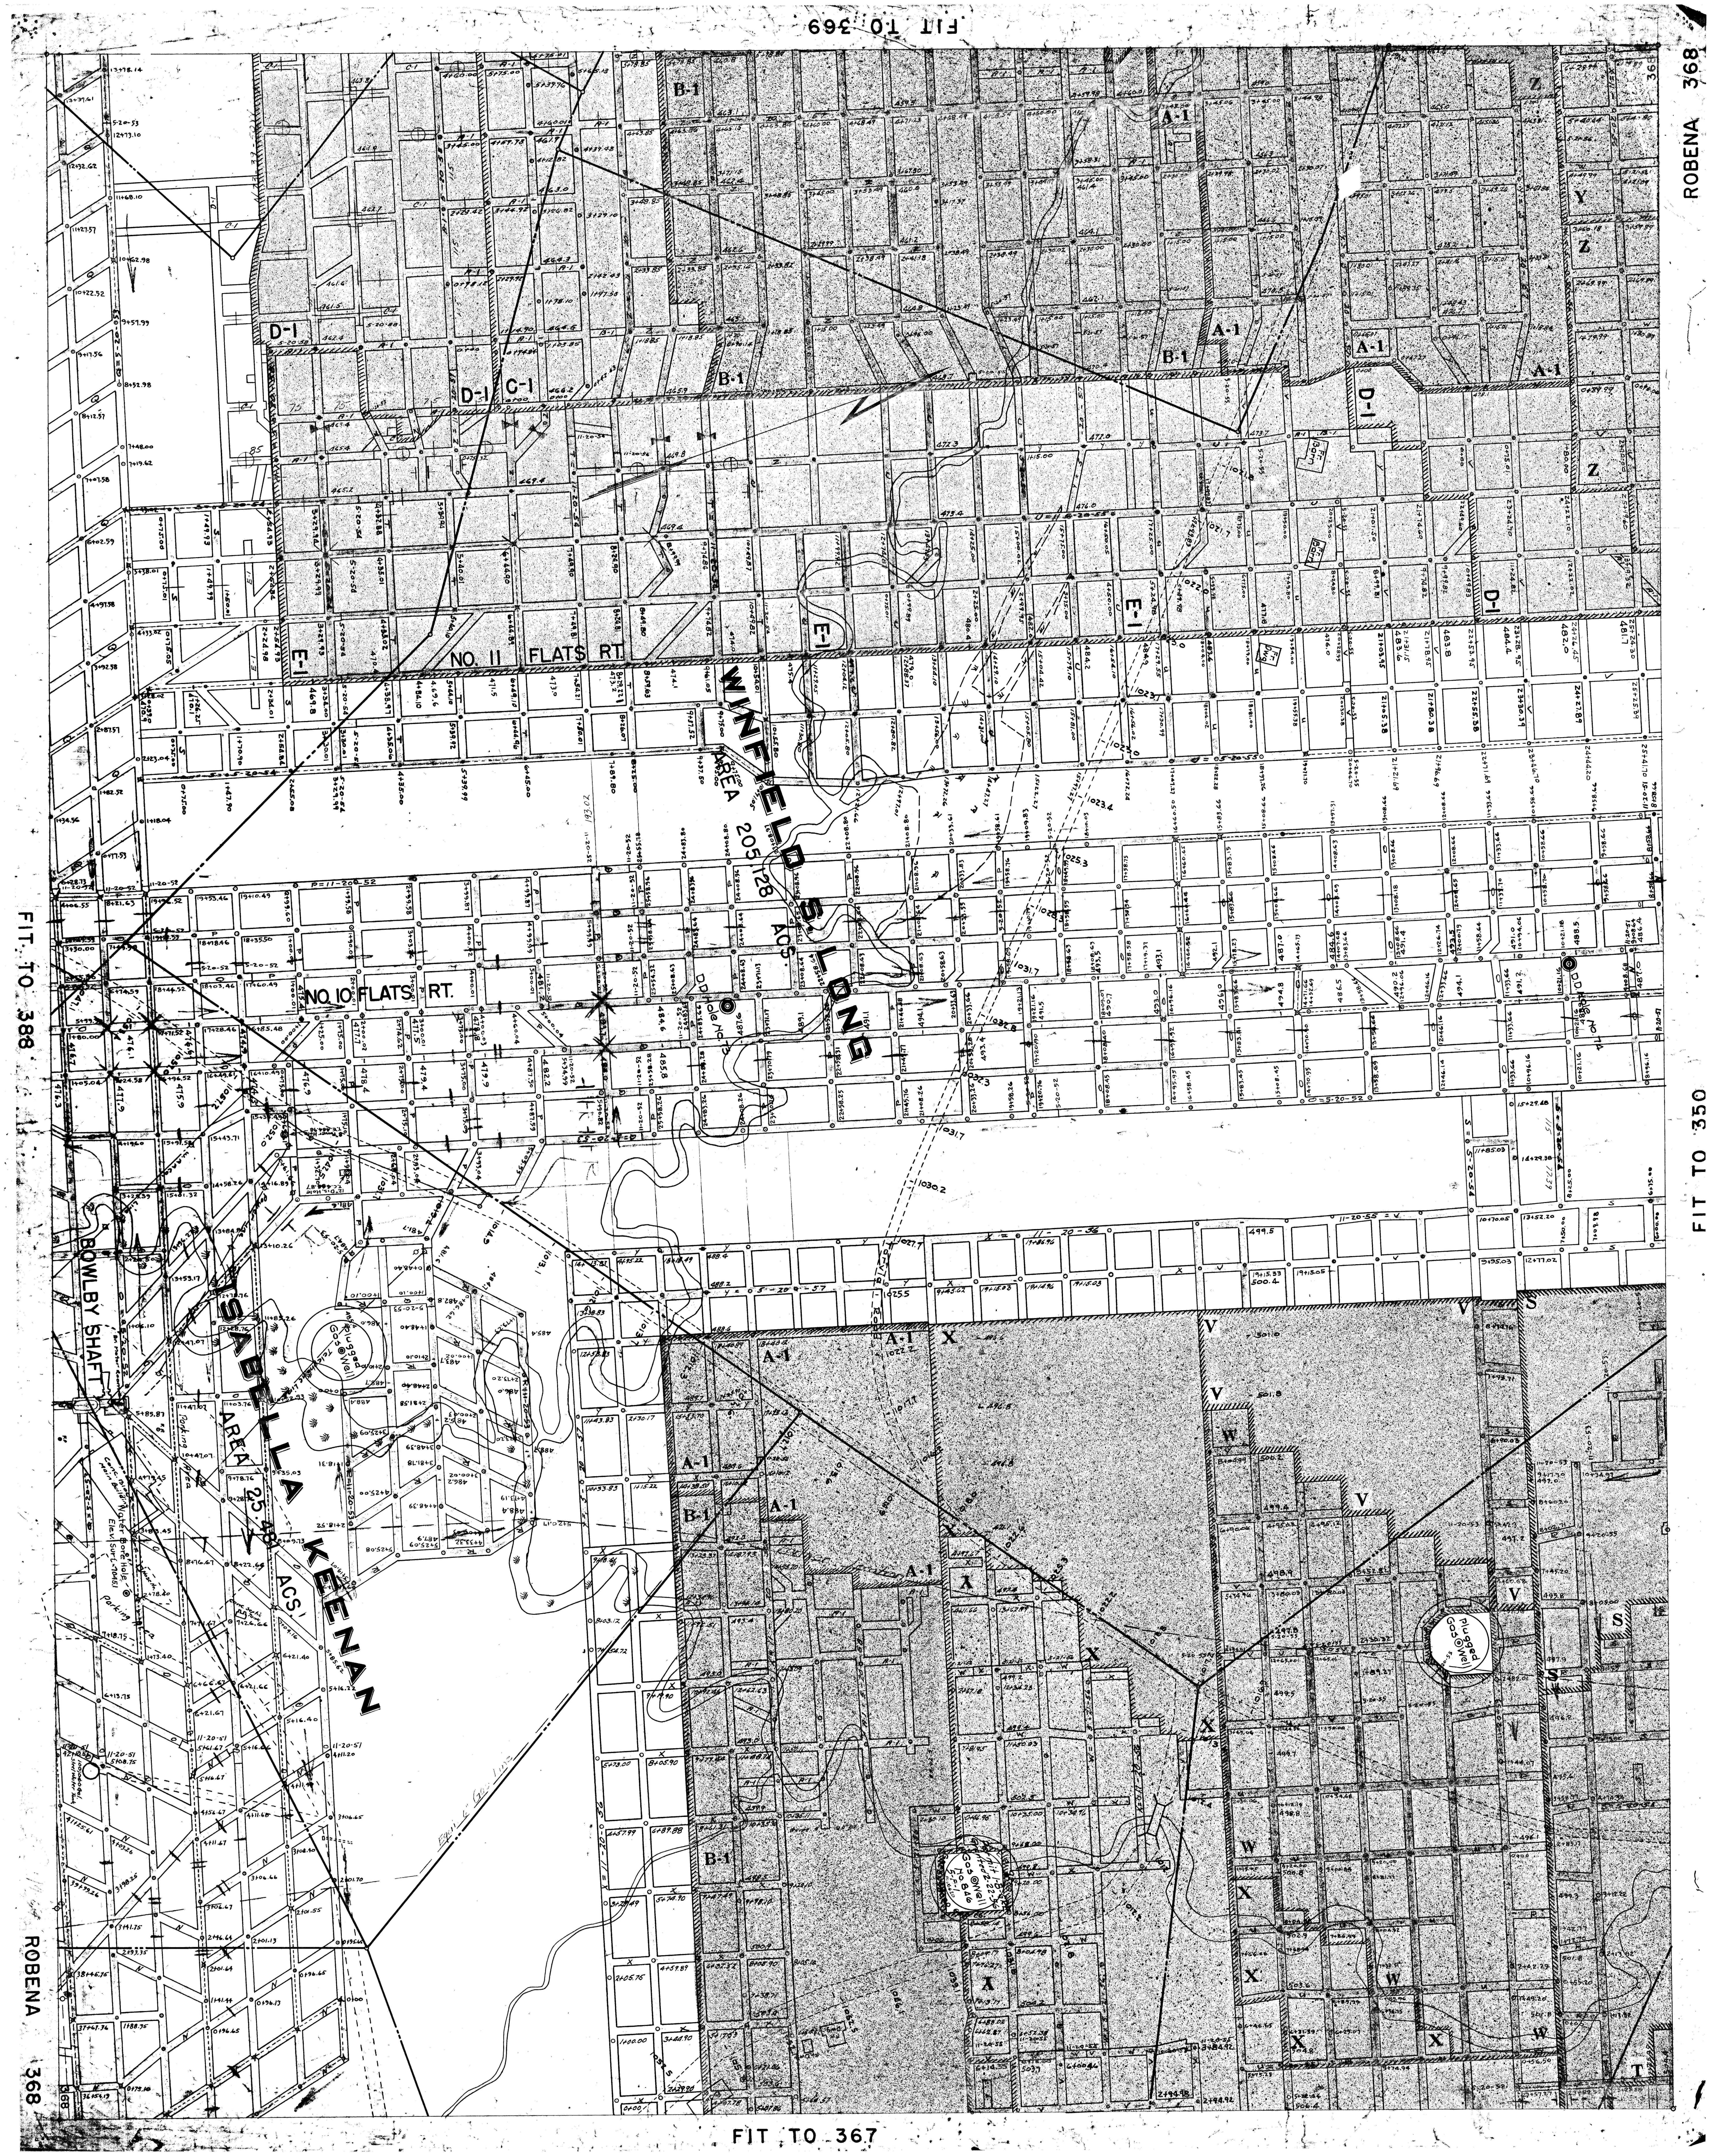
FIT TO 369
ROBENA 368
FIT TO 388
FIT TO 350
ROBENA 368
FIT TO 367
NO. 11 FLATS RT.
NO. 10 FLATS RT.
WINFIELD S. LONG
AREA 205.128 ACS.
ISABELLA KEENAN
AREA 25.481 ACS.
BOWLBY SHAFT
DD Hole No 73
DD Hole No 74
Plugged Gas Well
Plugged Gas Well
Gas Well No. 846
Water Bore Hole
Parking Area
Fr. Barn
Fr. Dwg.
A-1
B-1
C-1
D-1
E-1
S
T
V
W
X
Y
Z