


FIT TO 390

ROBENA 370

THOMAS
INGRAM

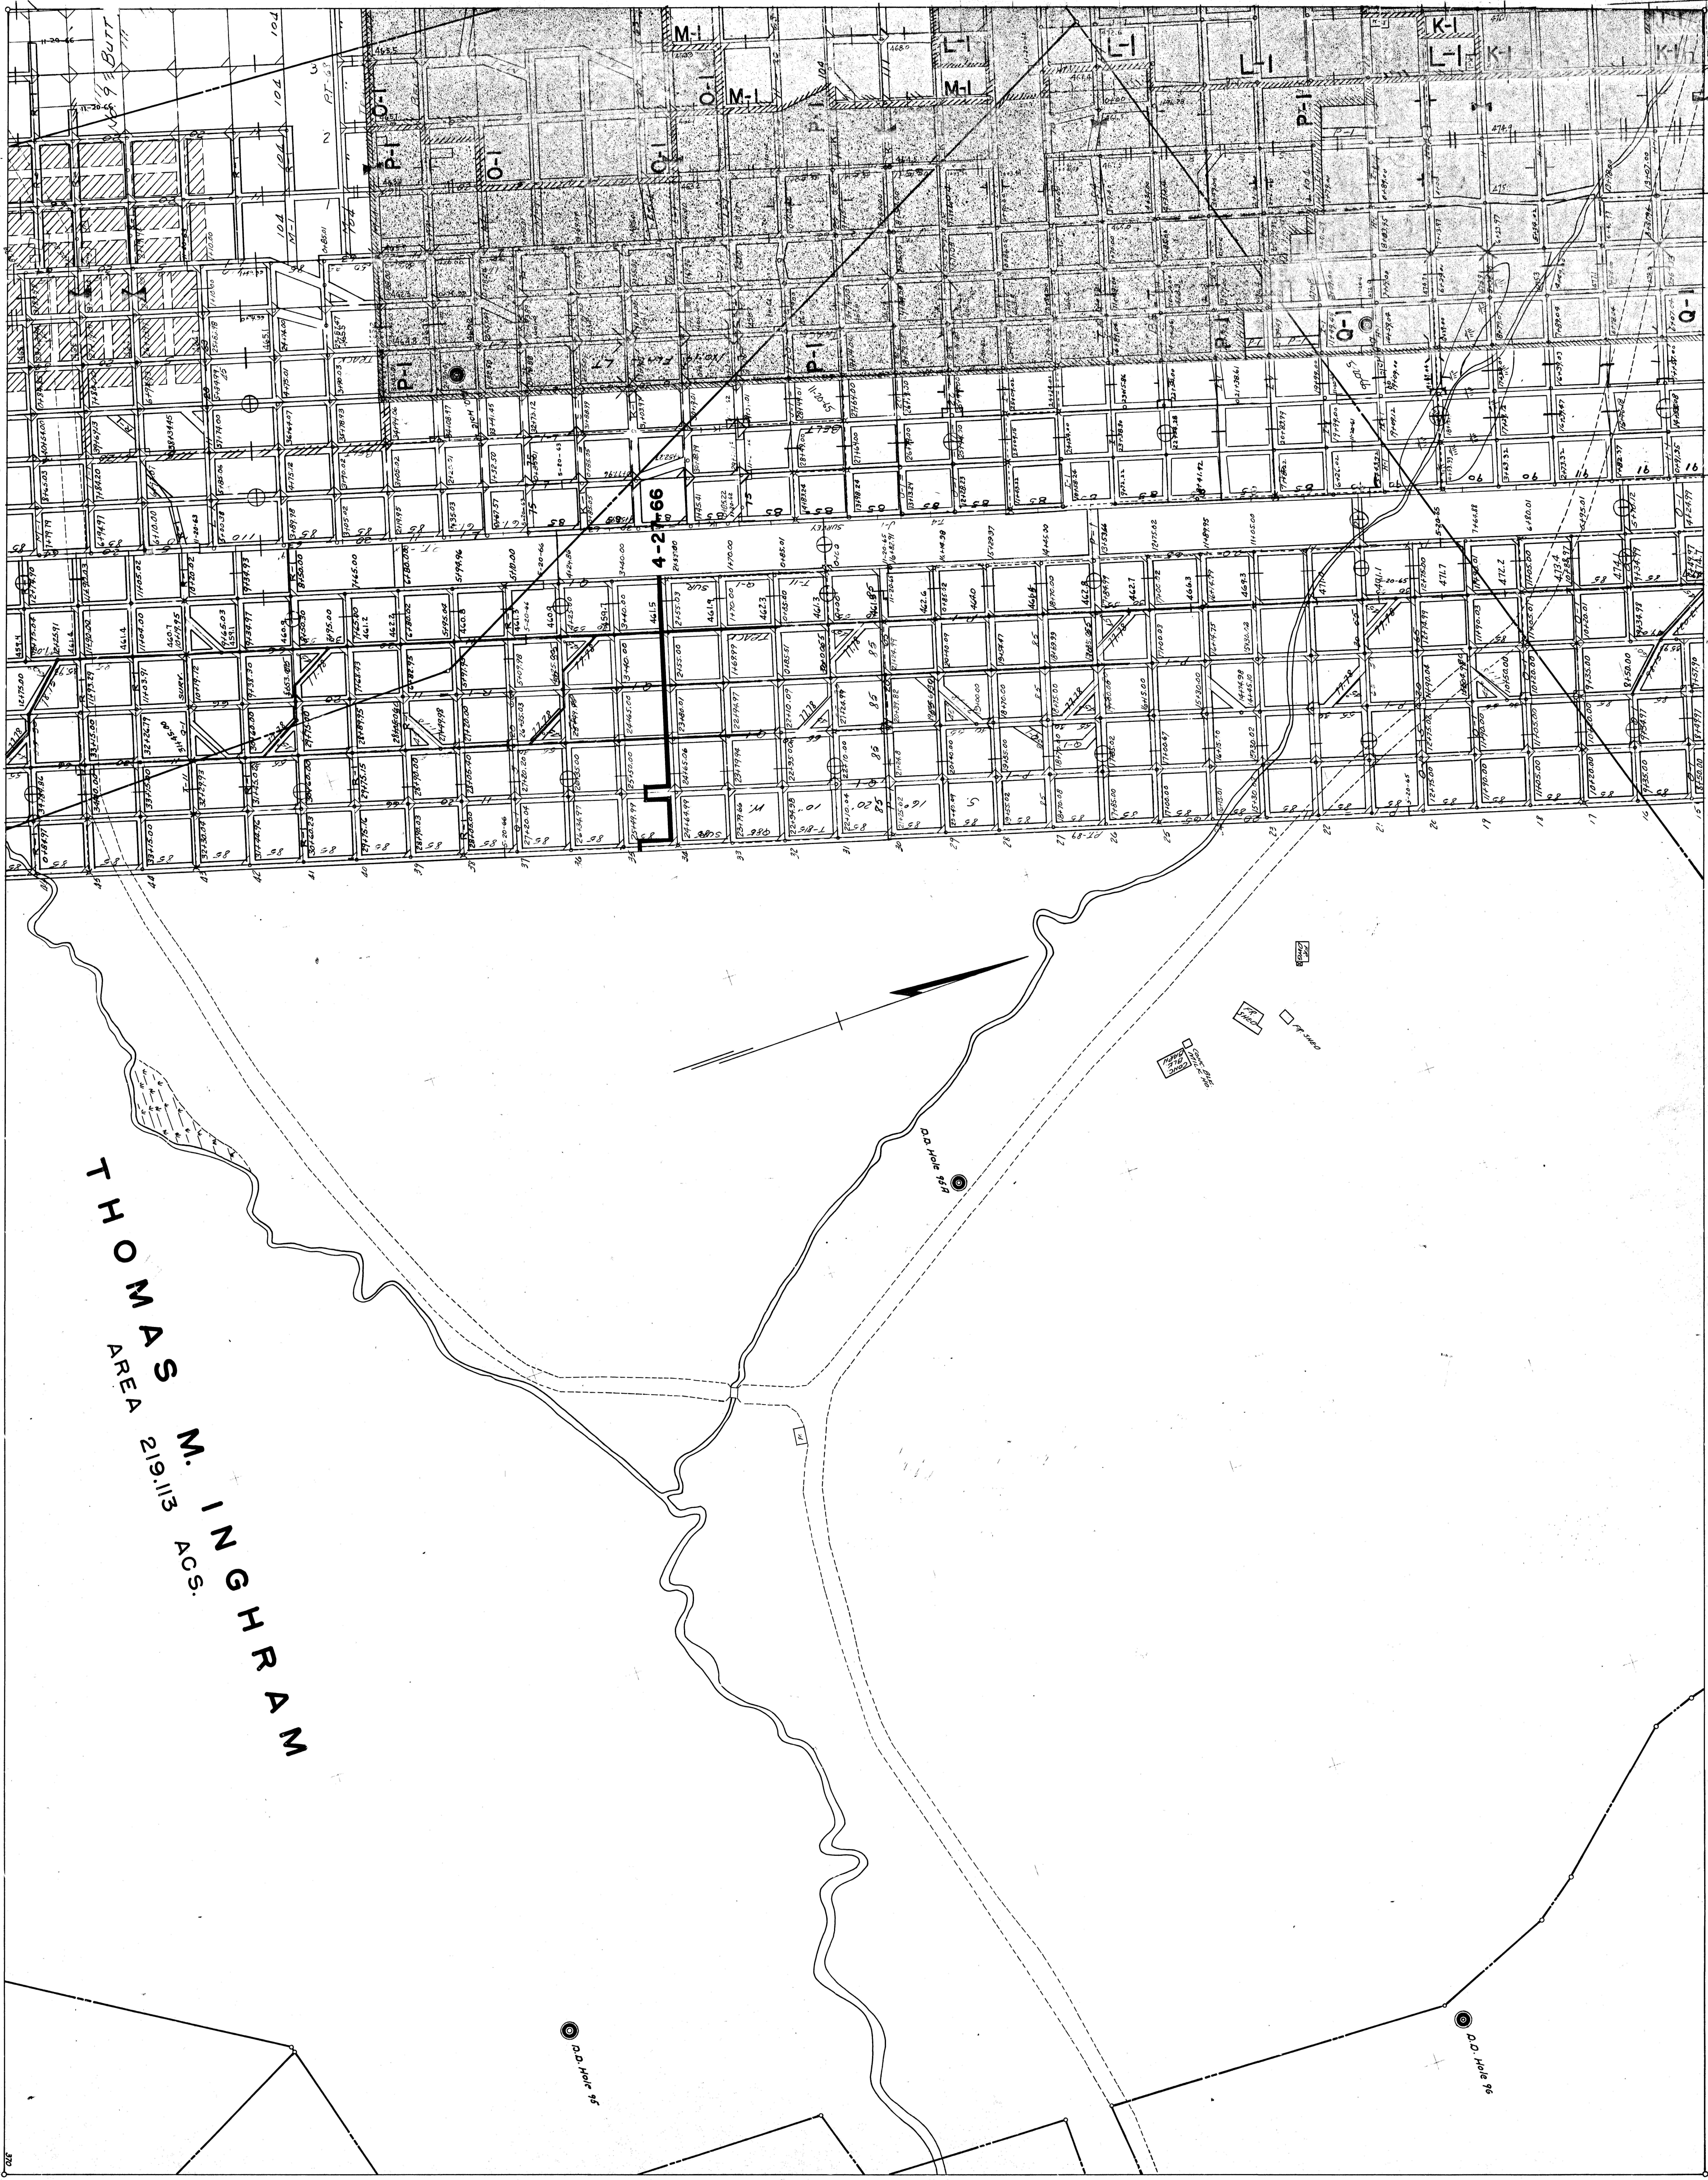

FIT TO 369

FIT TO 352

ROBENA 370