FIT TO 381

CHARLES L

AREA 32.977 ACS.

DULANEY

9.843 ACS

FIT TO 382

UNITED STATES STEEL CORP.

ROBENA MINE

GREENE COUNTY – PENNSYLVANIA

DATUM OF LEVELS
BASED ON U.S. GEOLOGICAL SURVEY

SCALE 1"-100' W.R.C. **MAY 28, 1941**

Note
All previous surveys considered development from Ronco Mine

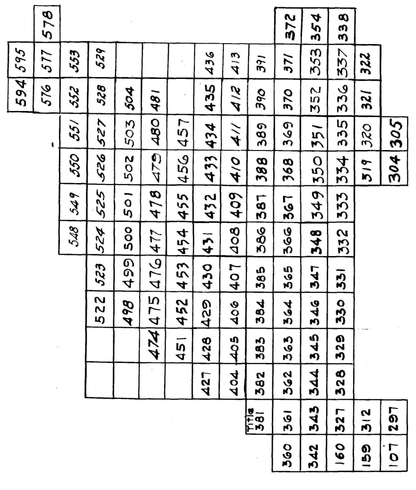

Date Of Last Survey

Date of Survey	Survey Letter	Plotted By	Traced By	Date of Survey	Survey Letter	Plotted By	Traced By	Date of Survey	Survey Letter	Plotted By	Traced By
5-20-45	A	L.R.E.	L.R.E.								
11-20-45	B	L.R.E.	W.R.C.								
5-20-46	C	L.R.E.	L.R.E.								
11-20-46	D	N.H.E.	N.H.E.								
5-20-47	E	N.H.E.	A.M.M.								
11-20-47	F	N.H.E.	W.D.W.								
5-20-48	G	N.H.E.	N.H.E.								
11-20-48	H	N.H.E.	W.D.W.								
5-20-49	I	N.H.E.	N.H.E.								
11-20-49	J	N.H.E.	N.H.E.								
5-20-50	K	N.H.E.	N.H.E.								
11-20-50	L	N.H.E.	N.H.E.								
5-20-51	M	N.H.E.	N.H.E.								
11-20-51	N	N.H.E.	D.L.S.								
5-20-52	O	N.H.E.	N.H.E.								
11-20-52	P	N.H.E.	N.H.E.								
5-20-53	Q	N.H.E.	D.L.S.								
11-20-53	R	NH&E&MM.	NH&E&MM.								
5-20-54	S	NH&E&MM.	NH&E&MM.								
11-20-54	T	NH&E&MM.	NH&E&MM.								
5-20-55	U	NH&E&MM.	NH&E&MM.								
11-20-55	V	NH&E&MM.	MM&J.F.S.								
5-21-56	W	J.F.S&D.L.S	J.A.Y.								
11-20-56	X	J.F.S.	J.A.Y.								
5-20-57	Y	W.C.J.	J.A.Y.								
11-20-57	Z	D.L.S&J.A.Y.	J.A.Y.								
5-20-58	A-1	D.L.S.	D.L.S.								
11-20-58	B-1	D.L.S&J.A.Y.	J.A.Y.								
5-20-59	C-1	D.L.S&J.A.Y.	W.D.W.-J.A.Y.								
11-20-59	D-1	D.L.S&J.A.Y.	J.A.Y.								
5-20-60	E-1	D.L.S&J.A.Y.	J.A.Y.								
11-20-60	F-1	D.L.S-A.M.	D.L.S-A.M.								
5-20-61	G-1	D.L.S. E.L.	E.L. W.L.								
11-20-61	H-1	D.L.S. E.L.	W.L.								
5-20-62	I-1	D.L.S. E.L.	W.L.								
11-20-62	J-1	E.M.L. J.S.	J.S. E.M.L.								
5-20-63	K-1	D.S.E.L.R.M.	E.L. R.M.								
11-20-63	L-1	D.L.S&E.M.L.	A.M.M.&R.T.M.								
5-20-64	M-1	D.L.S&E.M.L.	E.M.L&R.T.M.								
11-20-64	N-1	D.L.S-E.M.L.	D.L.S-E.M.L.								
5-20-65	O-1	D.L.S-E.L.	E.L.-R.M.								
11-20-65	P-1	D.L.S-E.L.	-R.M.								
5-20-66	Q-1	D.L.S-E.L.	R.M.								
11-20-66	R-1	E.L-D.L.S.R.M.	E.L-D.L.S-R.M.								