


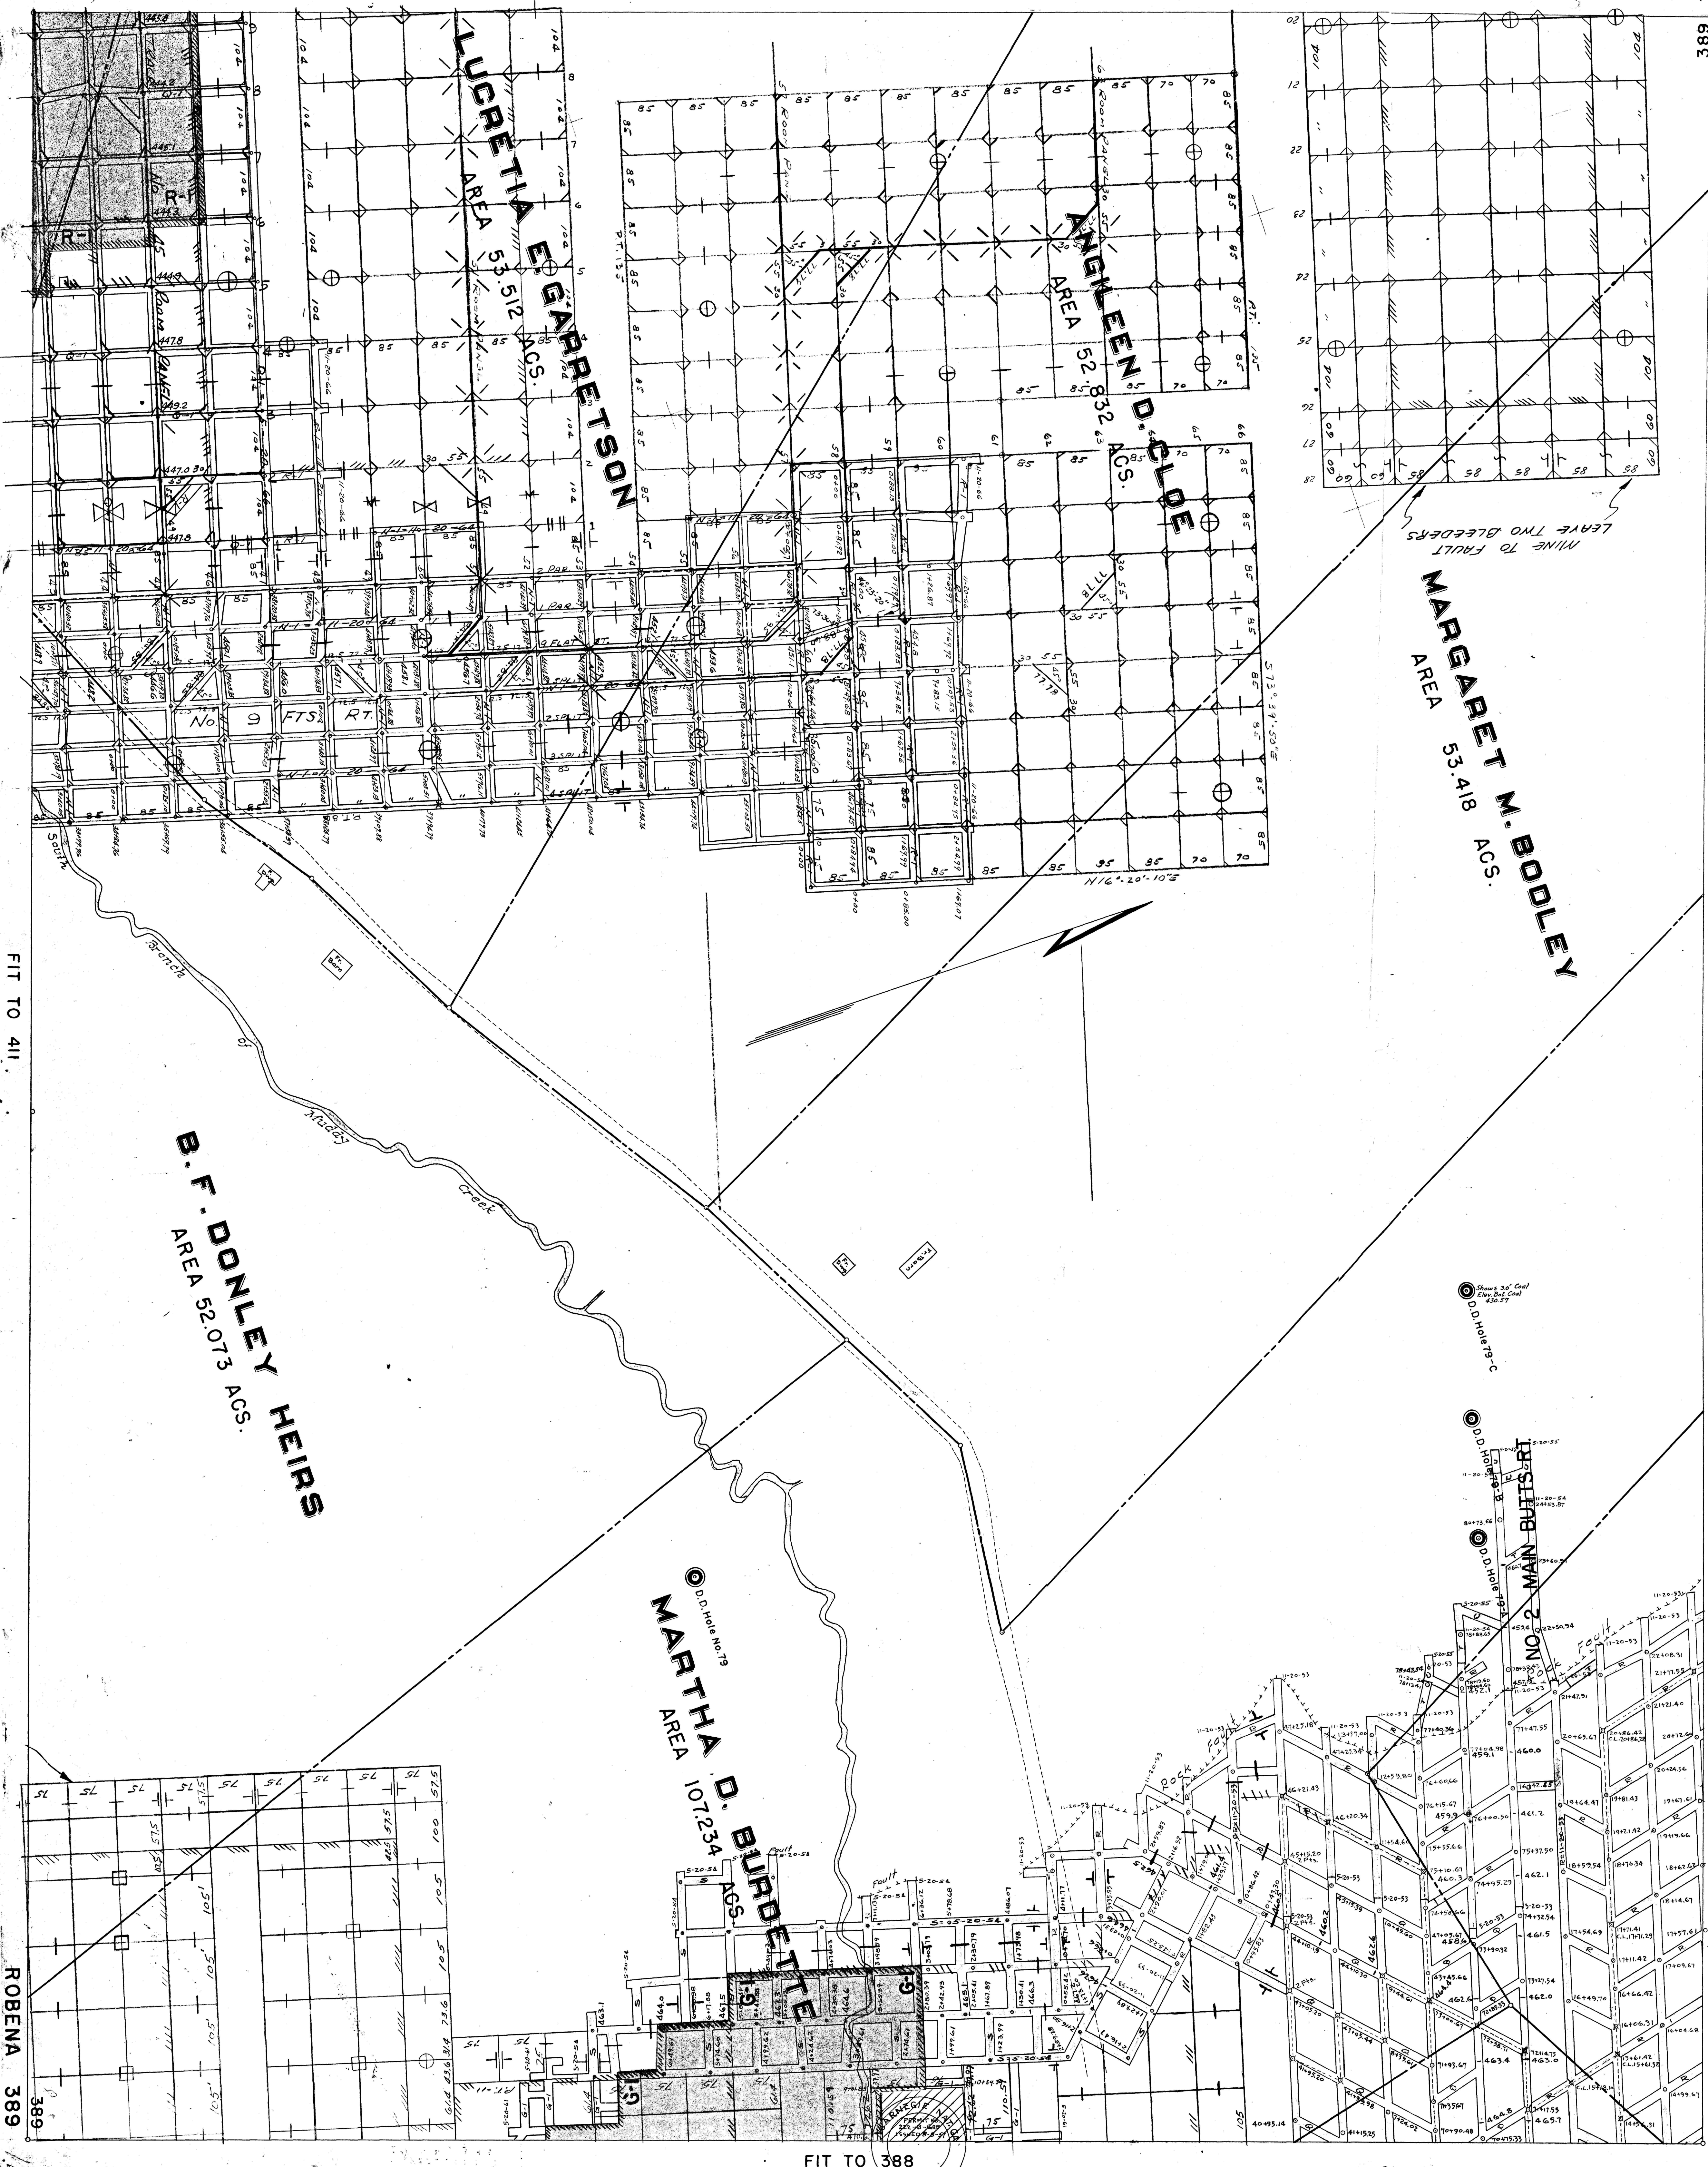

FIT TO 411

ROBENA 389

FIT TO 388

FIT TO 390

FIT TO 369

ROBENA 389

LEAVE TWO BLEEDERS
NINE TO FAULT

Shows 30' Coal
Elev. But. Coal
438.57

DD Hole 19-C

DD Hole 19-B

DD Hole 19-A

DD Hole 19-D

DD Hole 19-E

DD Hole 19-F

DD Hole 19-G

DD Hole 19-H