FIT TO 453

Robena 452

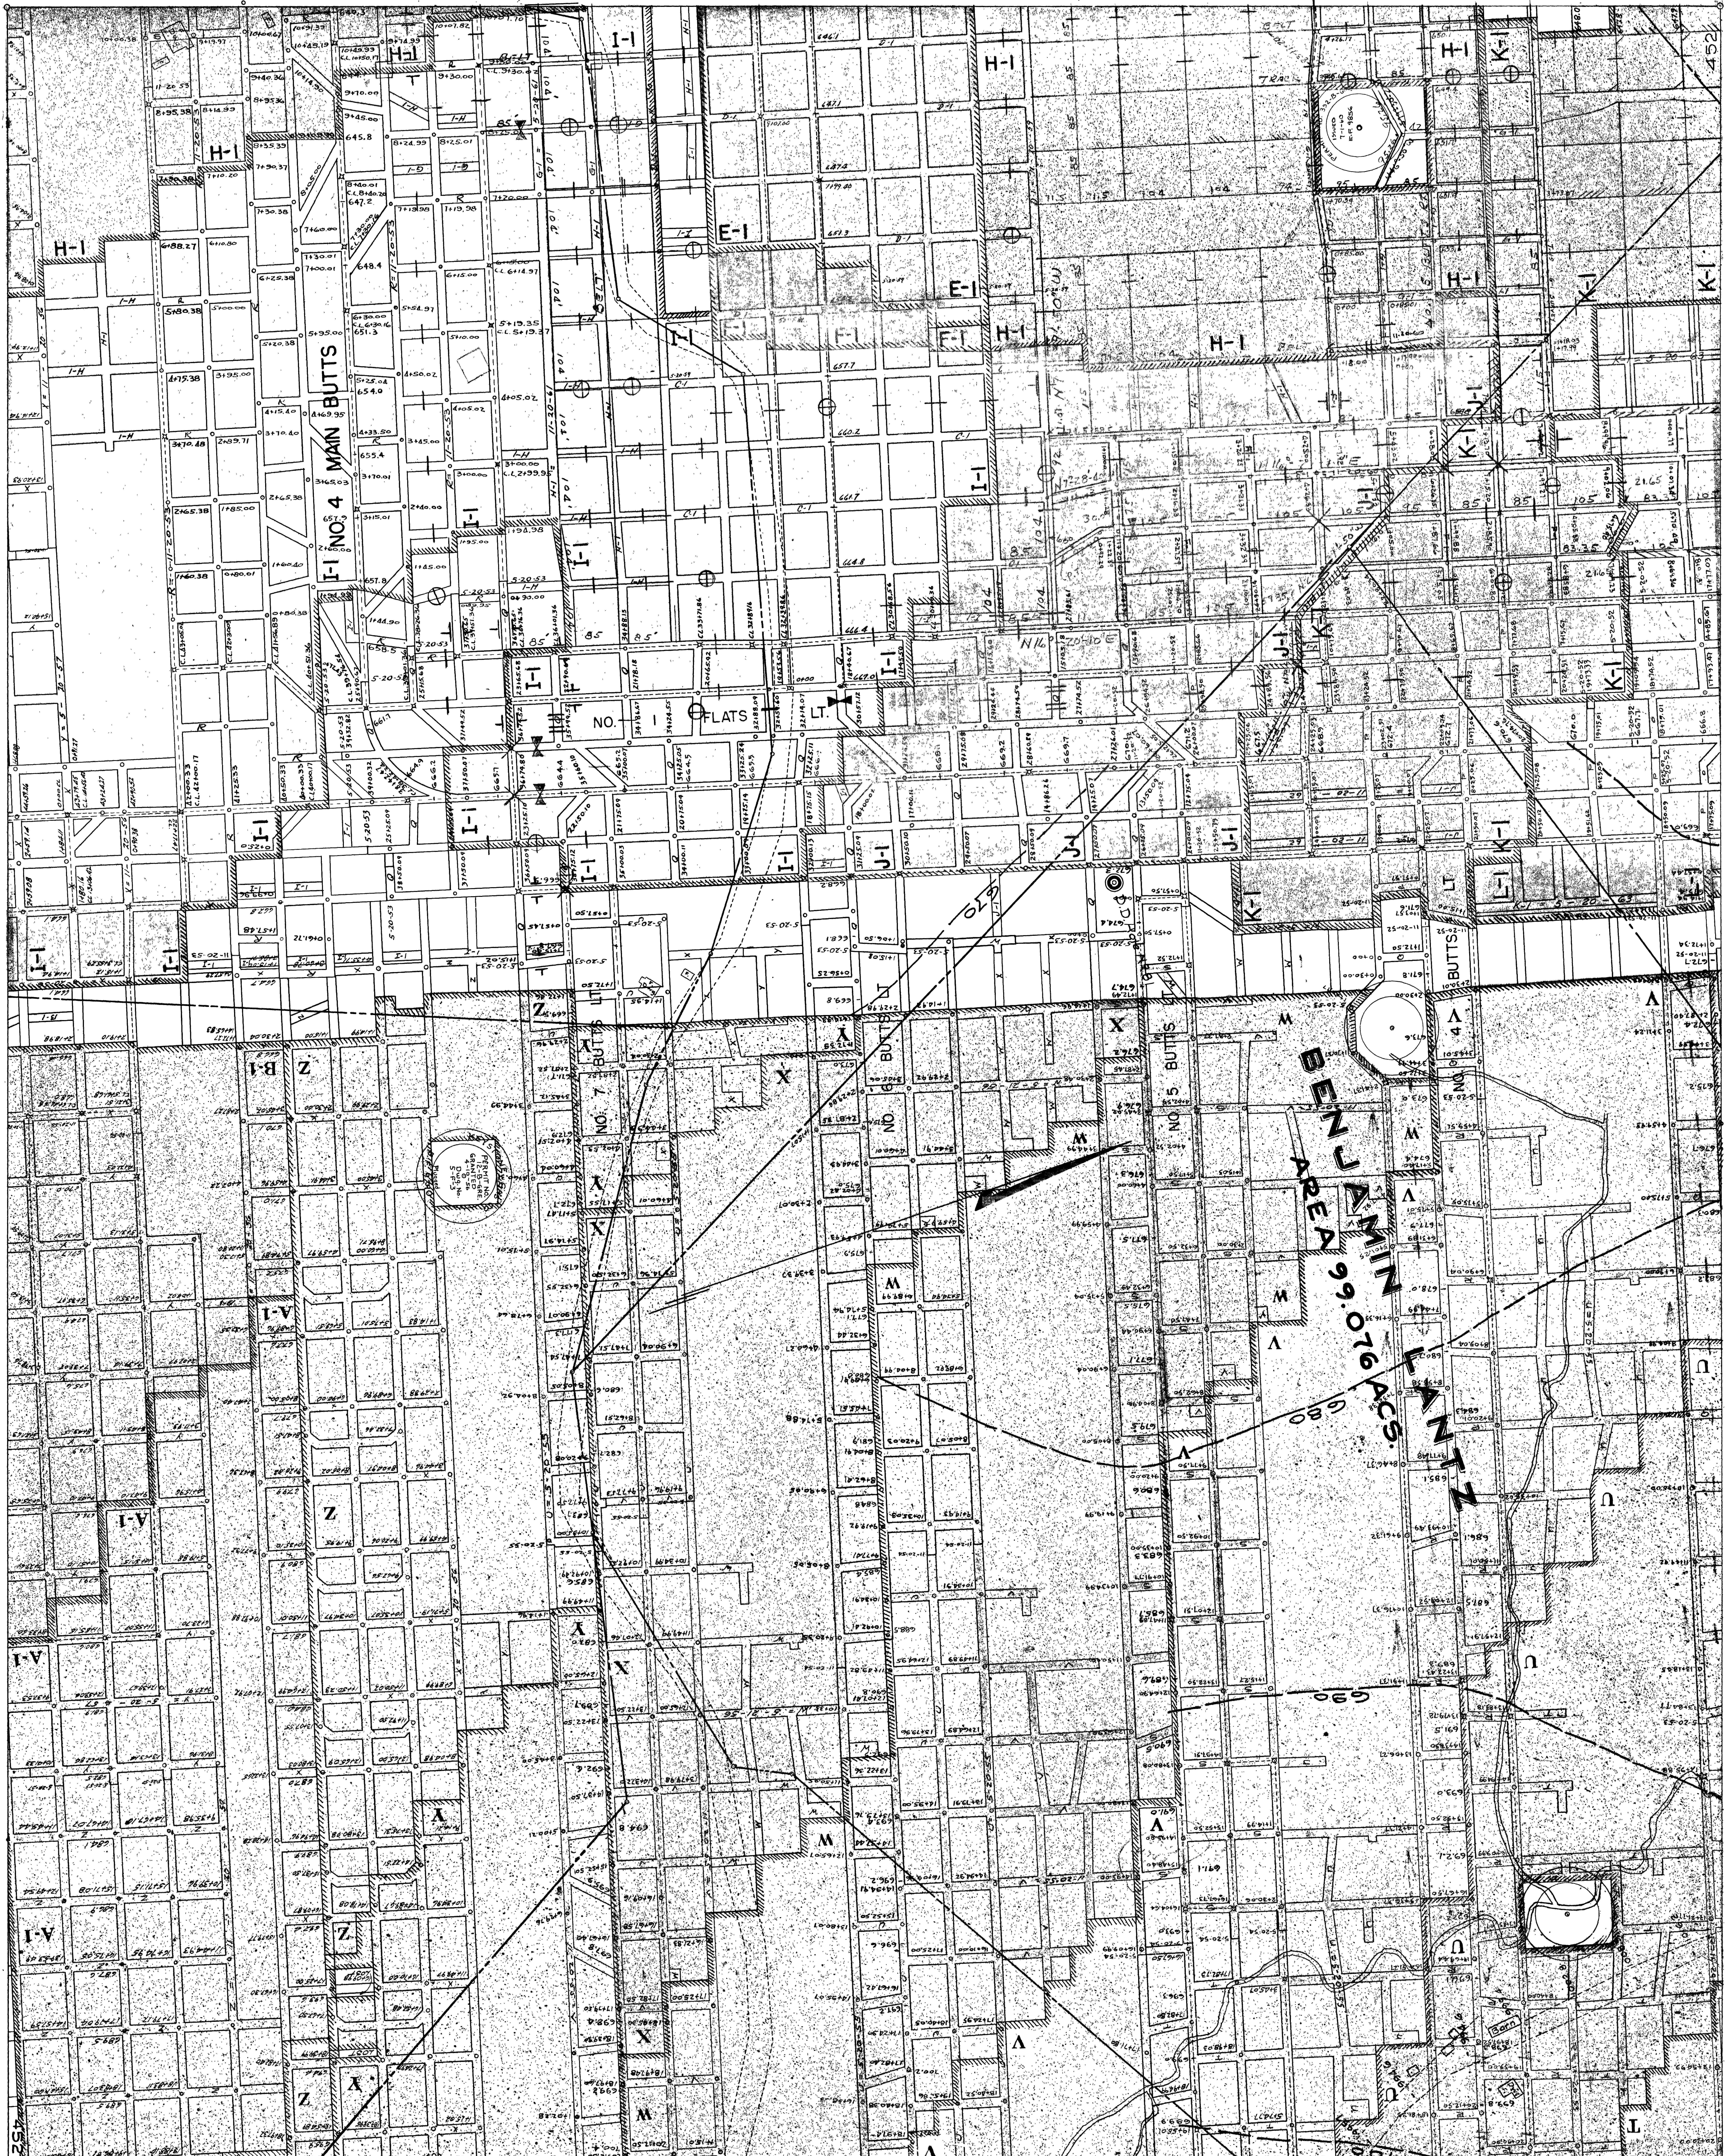
I-1 NO 4 MAIN BUTTS
NO. 1 FLATS LT.
BENJAMIN LANTZ
AREA 99.076 ACS.
NO. 7 BUTTS LT
NO. 6 BUTTS LT
NO. 5 BUTTS LT
NO. 4 BUTTS LT
H-1
E-1
F-1
I-1
J-1
K-1
L-1
A-1
B-1
Z
Y
X
W
V
U
T
PERMIT NO. 12-B-GRE. GRANTED 4-10-56 DWG. No. 5-F-3
ISSUED 7-1-60 E.F. 9856
Barn
670
680
690
700
452

FIT TO 475

FIT TO 429

FIT TO 451

Robena 452