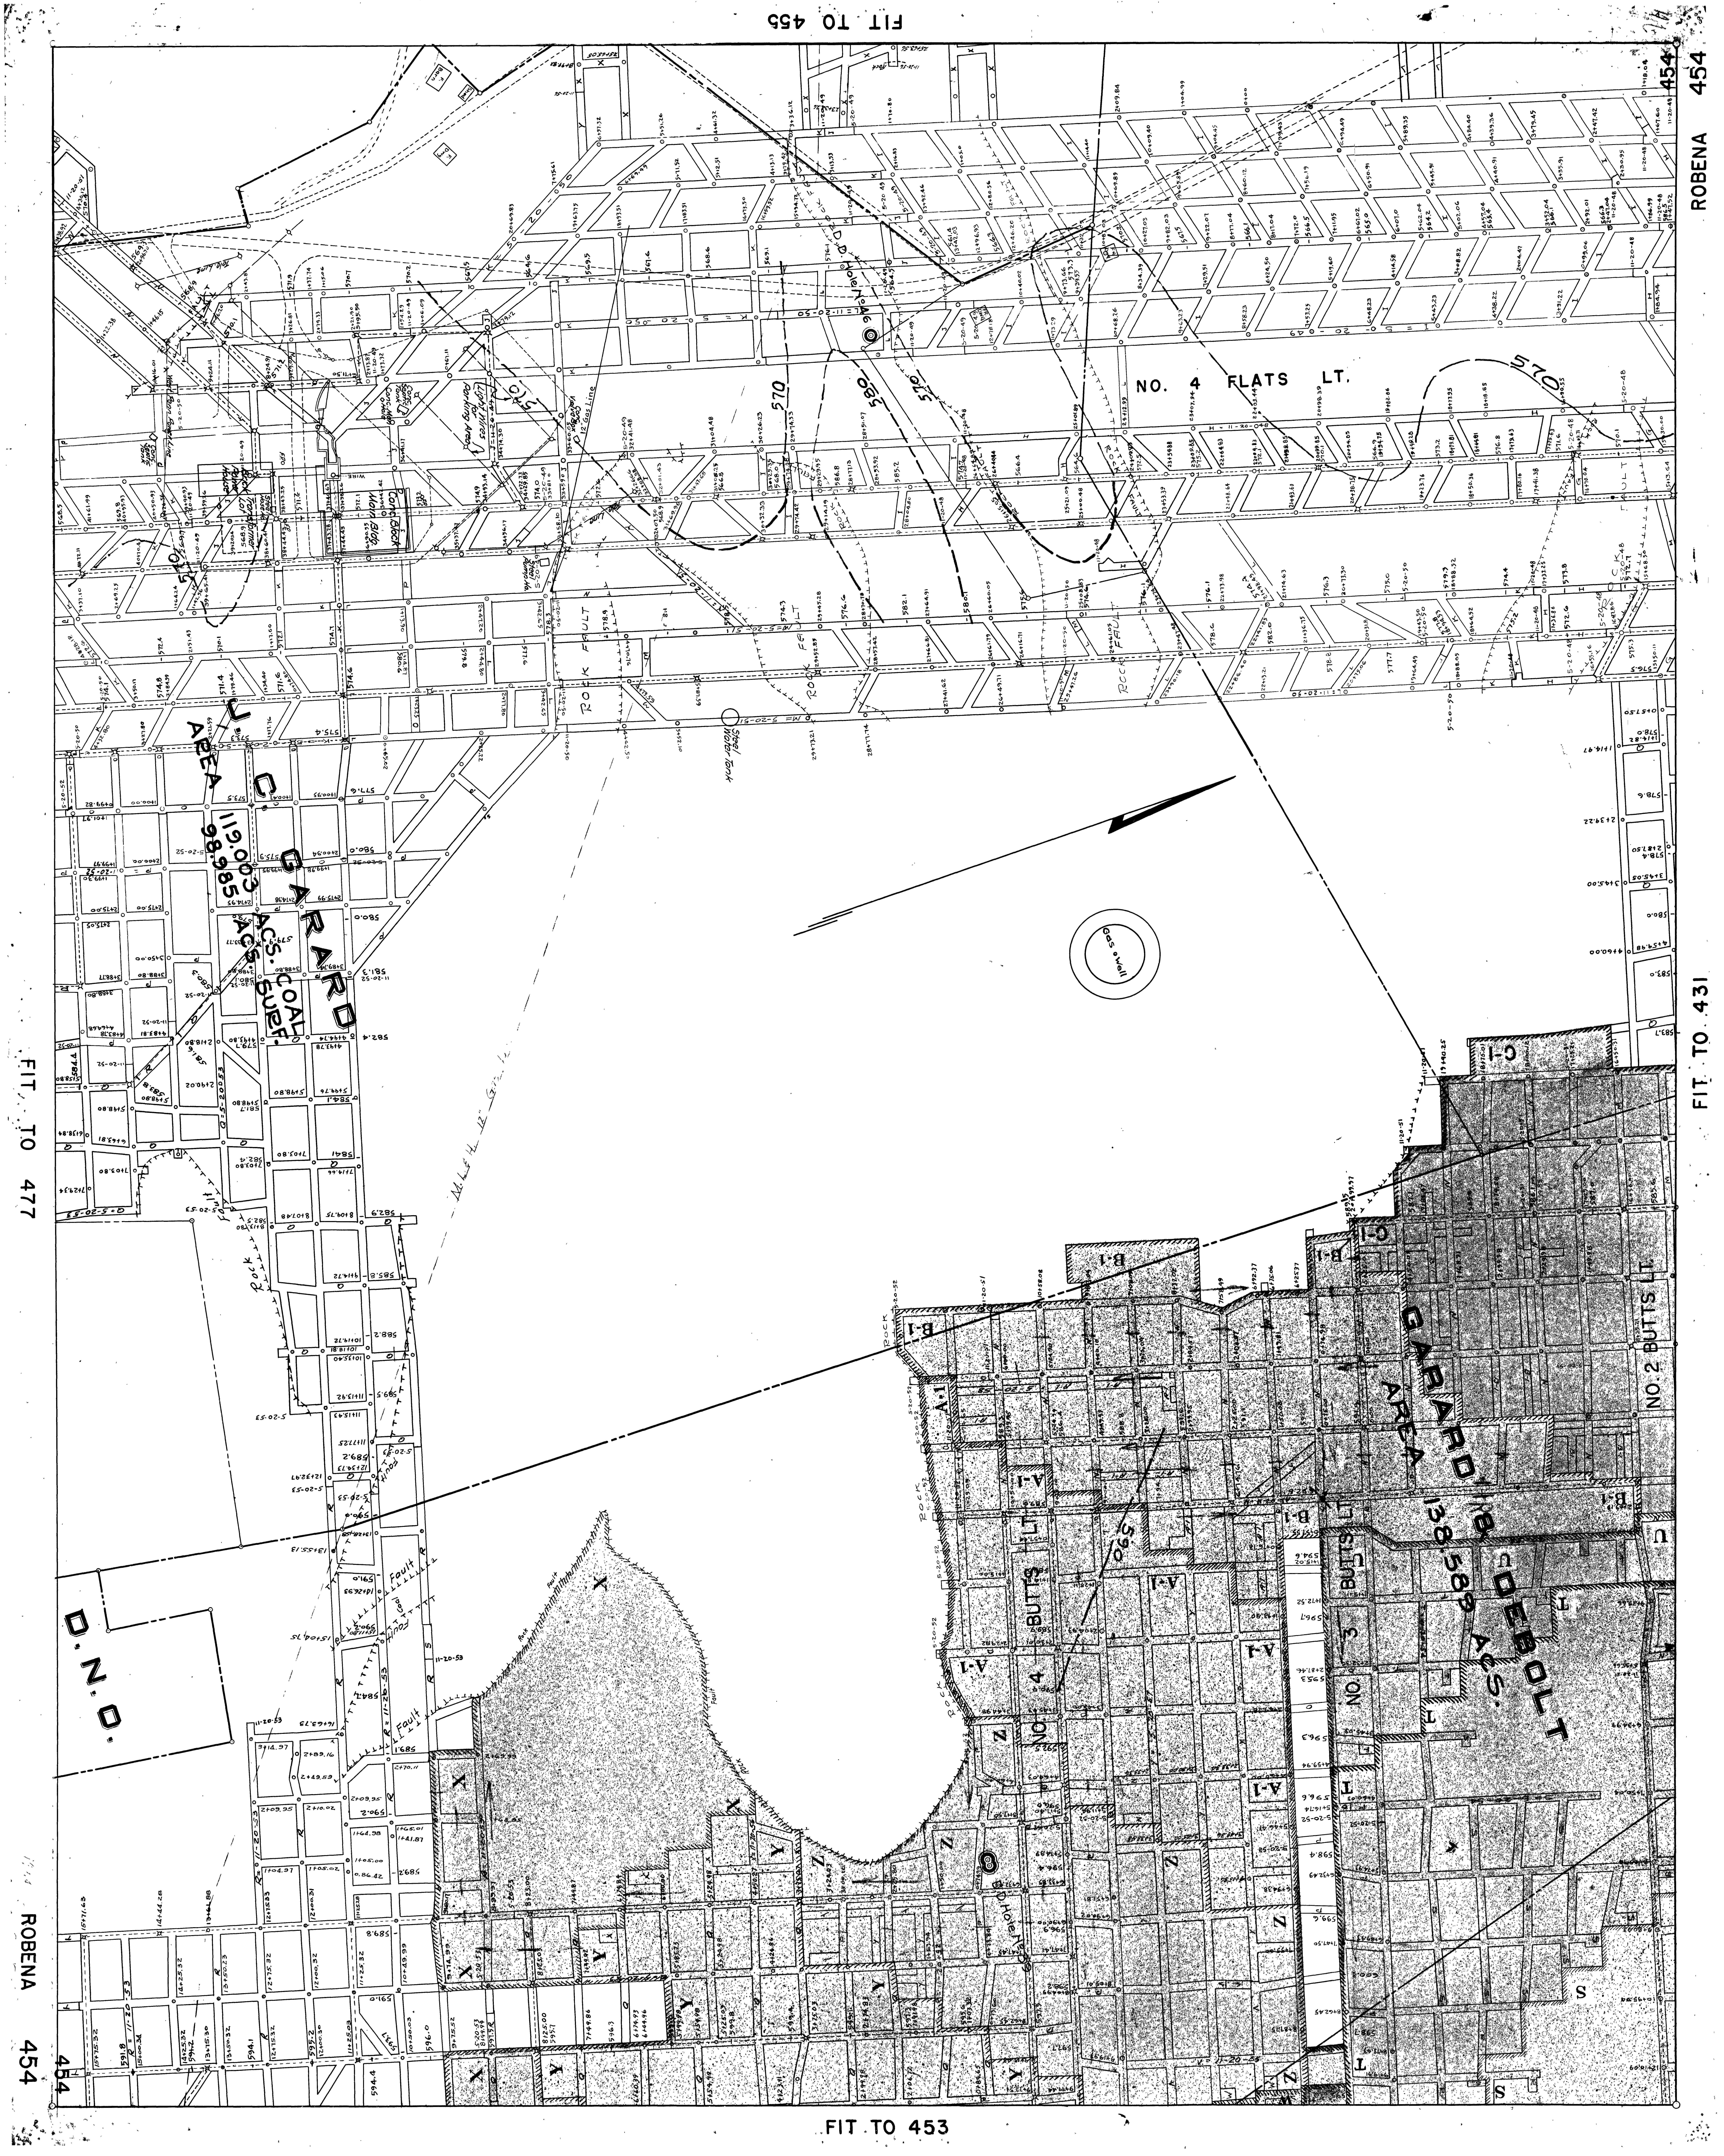
FIT TO 455
ROBENA 454
FIT TO 431
FIT TO 453
FIT TO 477
ROBENA 454
NO. 4 FLATS LT.
D.D. Hole No. 46
12" Gas Line
Light Wires for Parking Area
Conc. Block Main Bldg
Steel Water Tank
ROCK FAULT
570
580
590
J. C. GARARD AREA
119.003 ACS. COAL
98.985 ACS. SURF.
Gas Well
D. N. O.
Fault
Rock
GARARD AREA
118
DEBOLT
138.589 ACS.
NO. 2 BUTTS LT.
NO. 3 BUTTS LT.
NO. 4 BUTTS LT.
A-1
B-1
C-1
X
Y
Z
S
T
U