


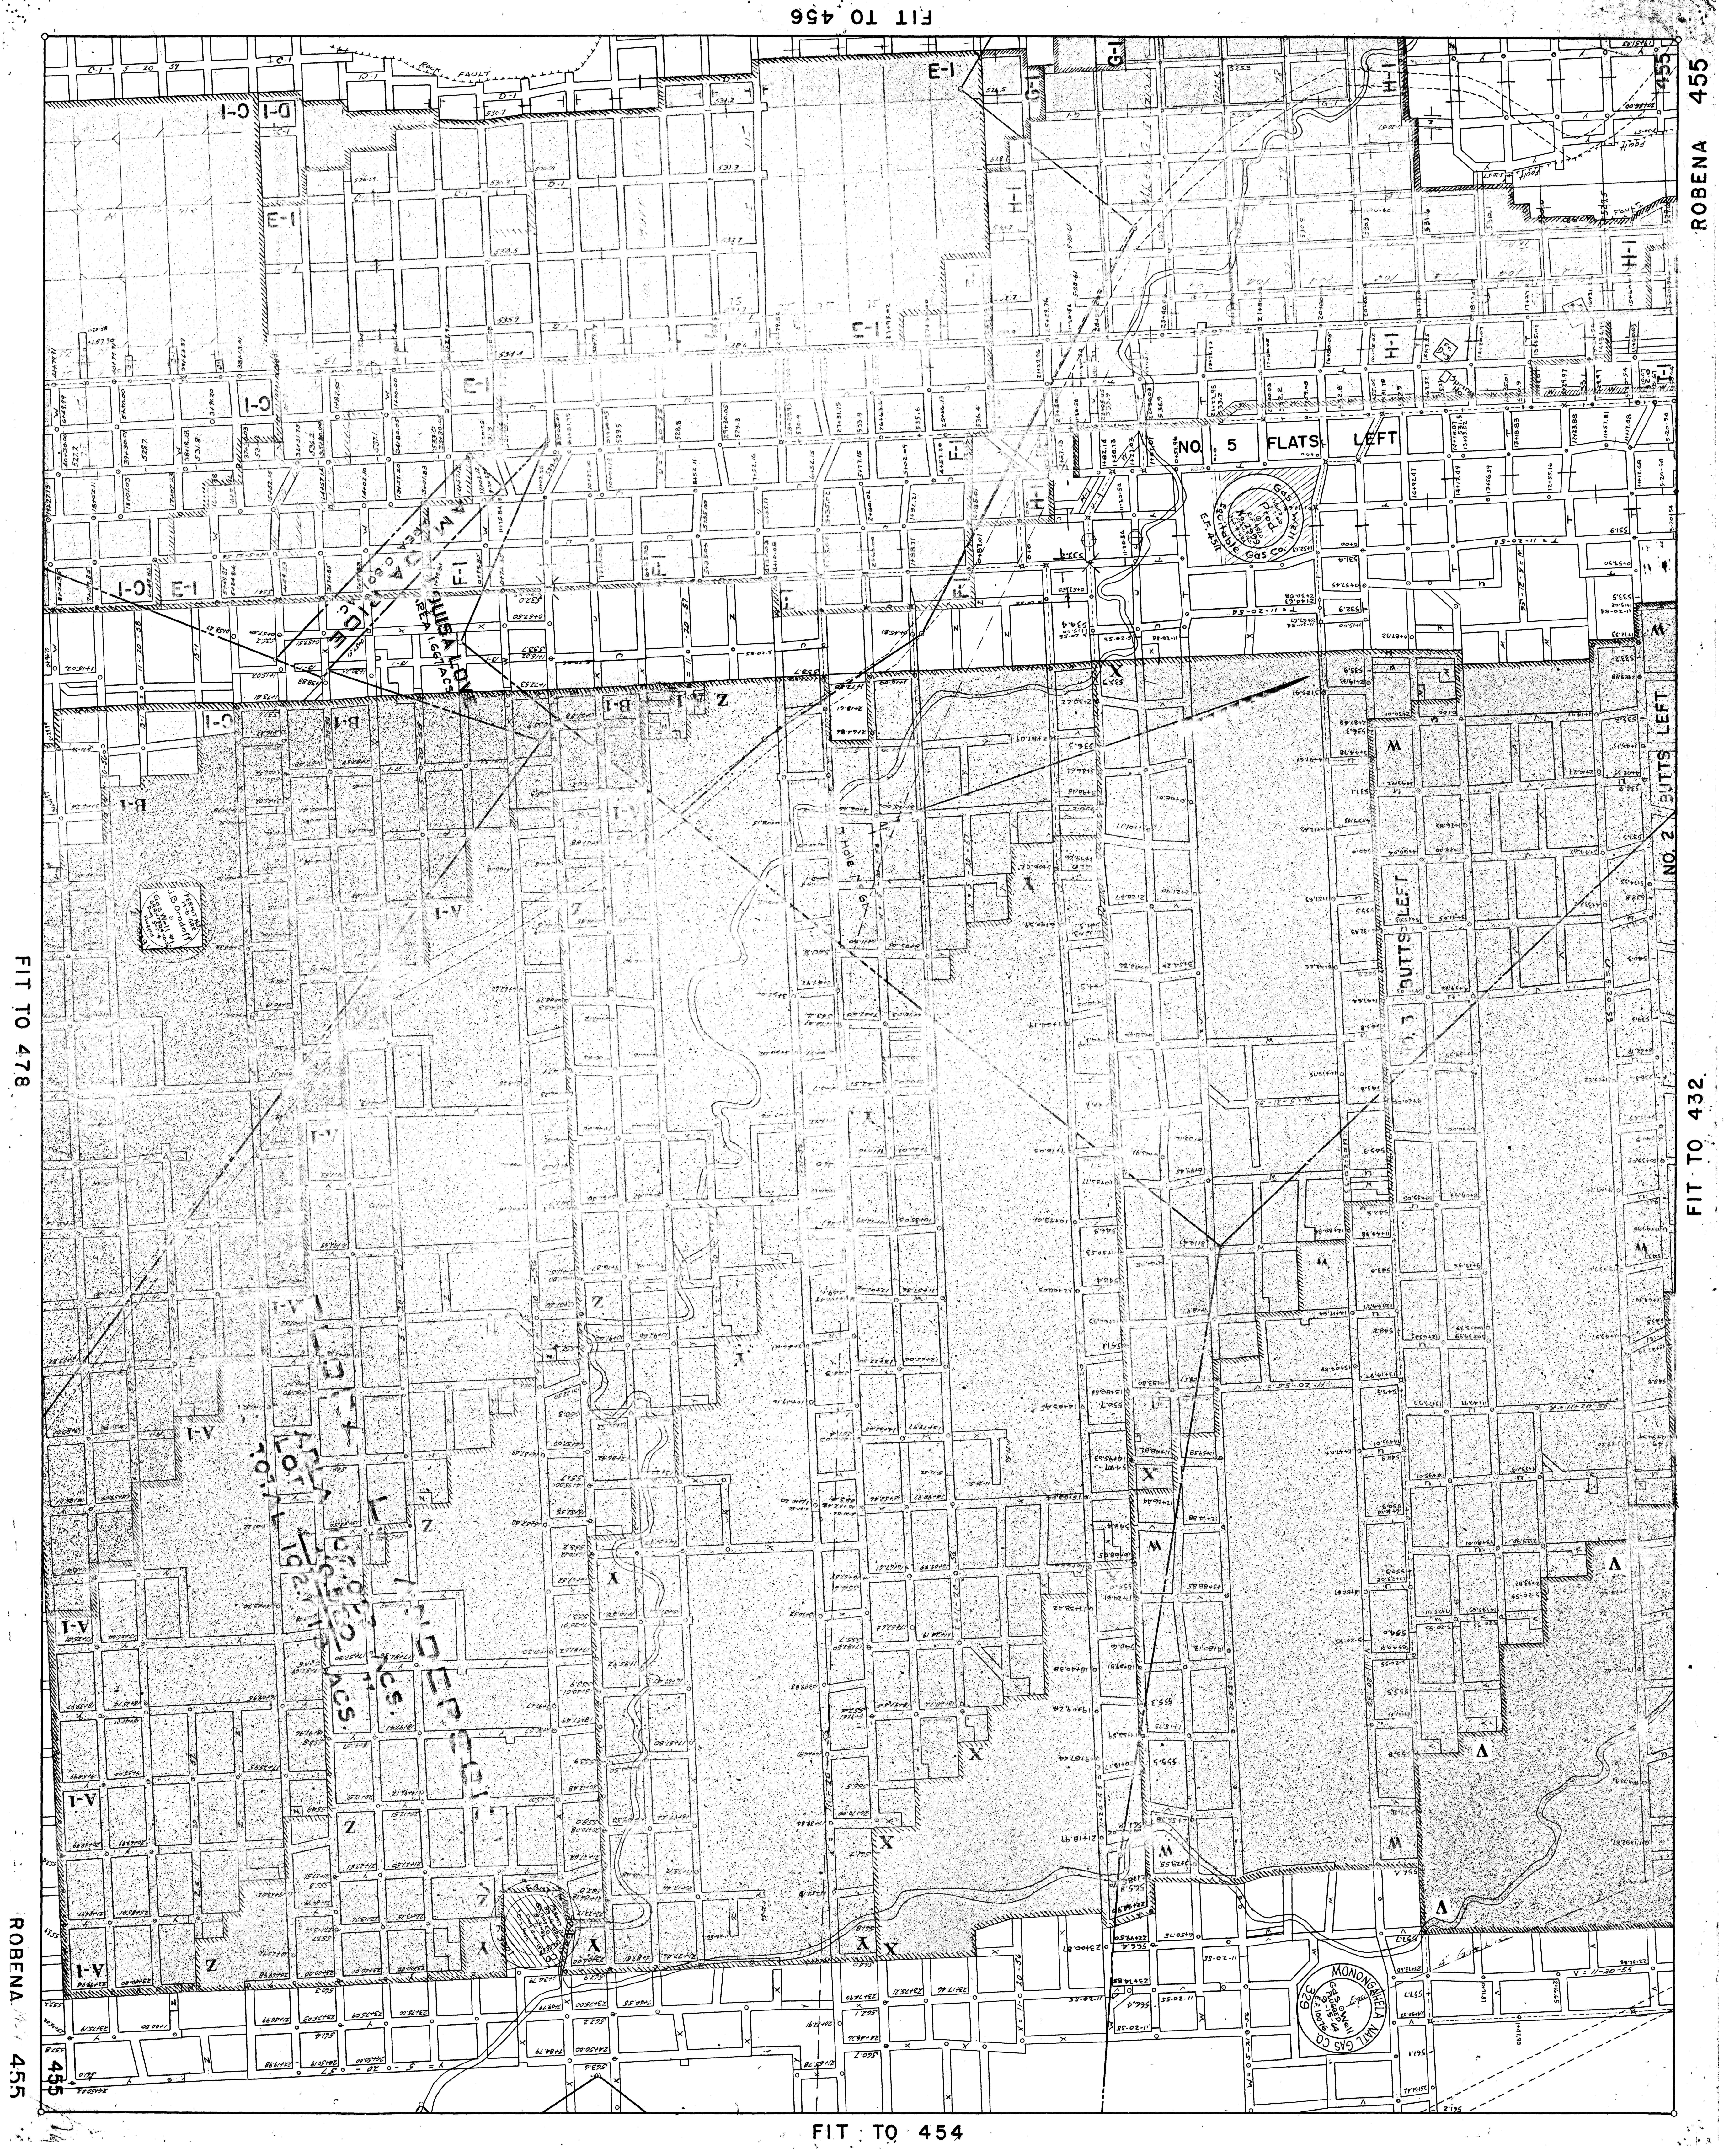

FIT TO 456

ROBENA 455

FIT TO 478

ROBENA 455

FIT TO 454

FIT TO 432