



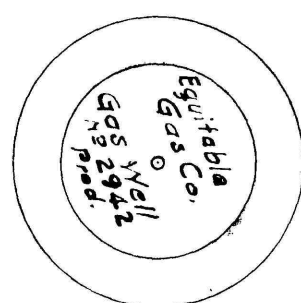


FIT TO 458

DD Hole No 90

HIRAM HATFIELD
21.151 ACS.

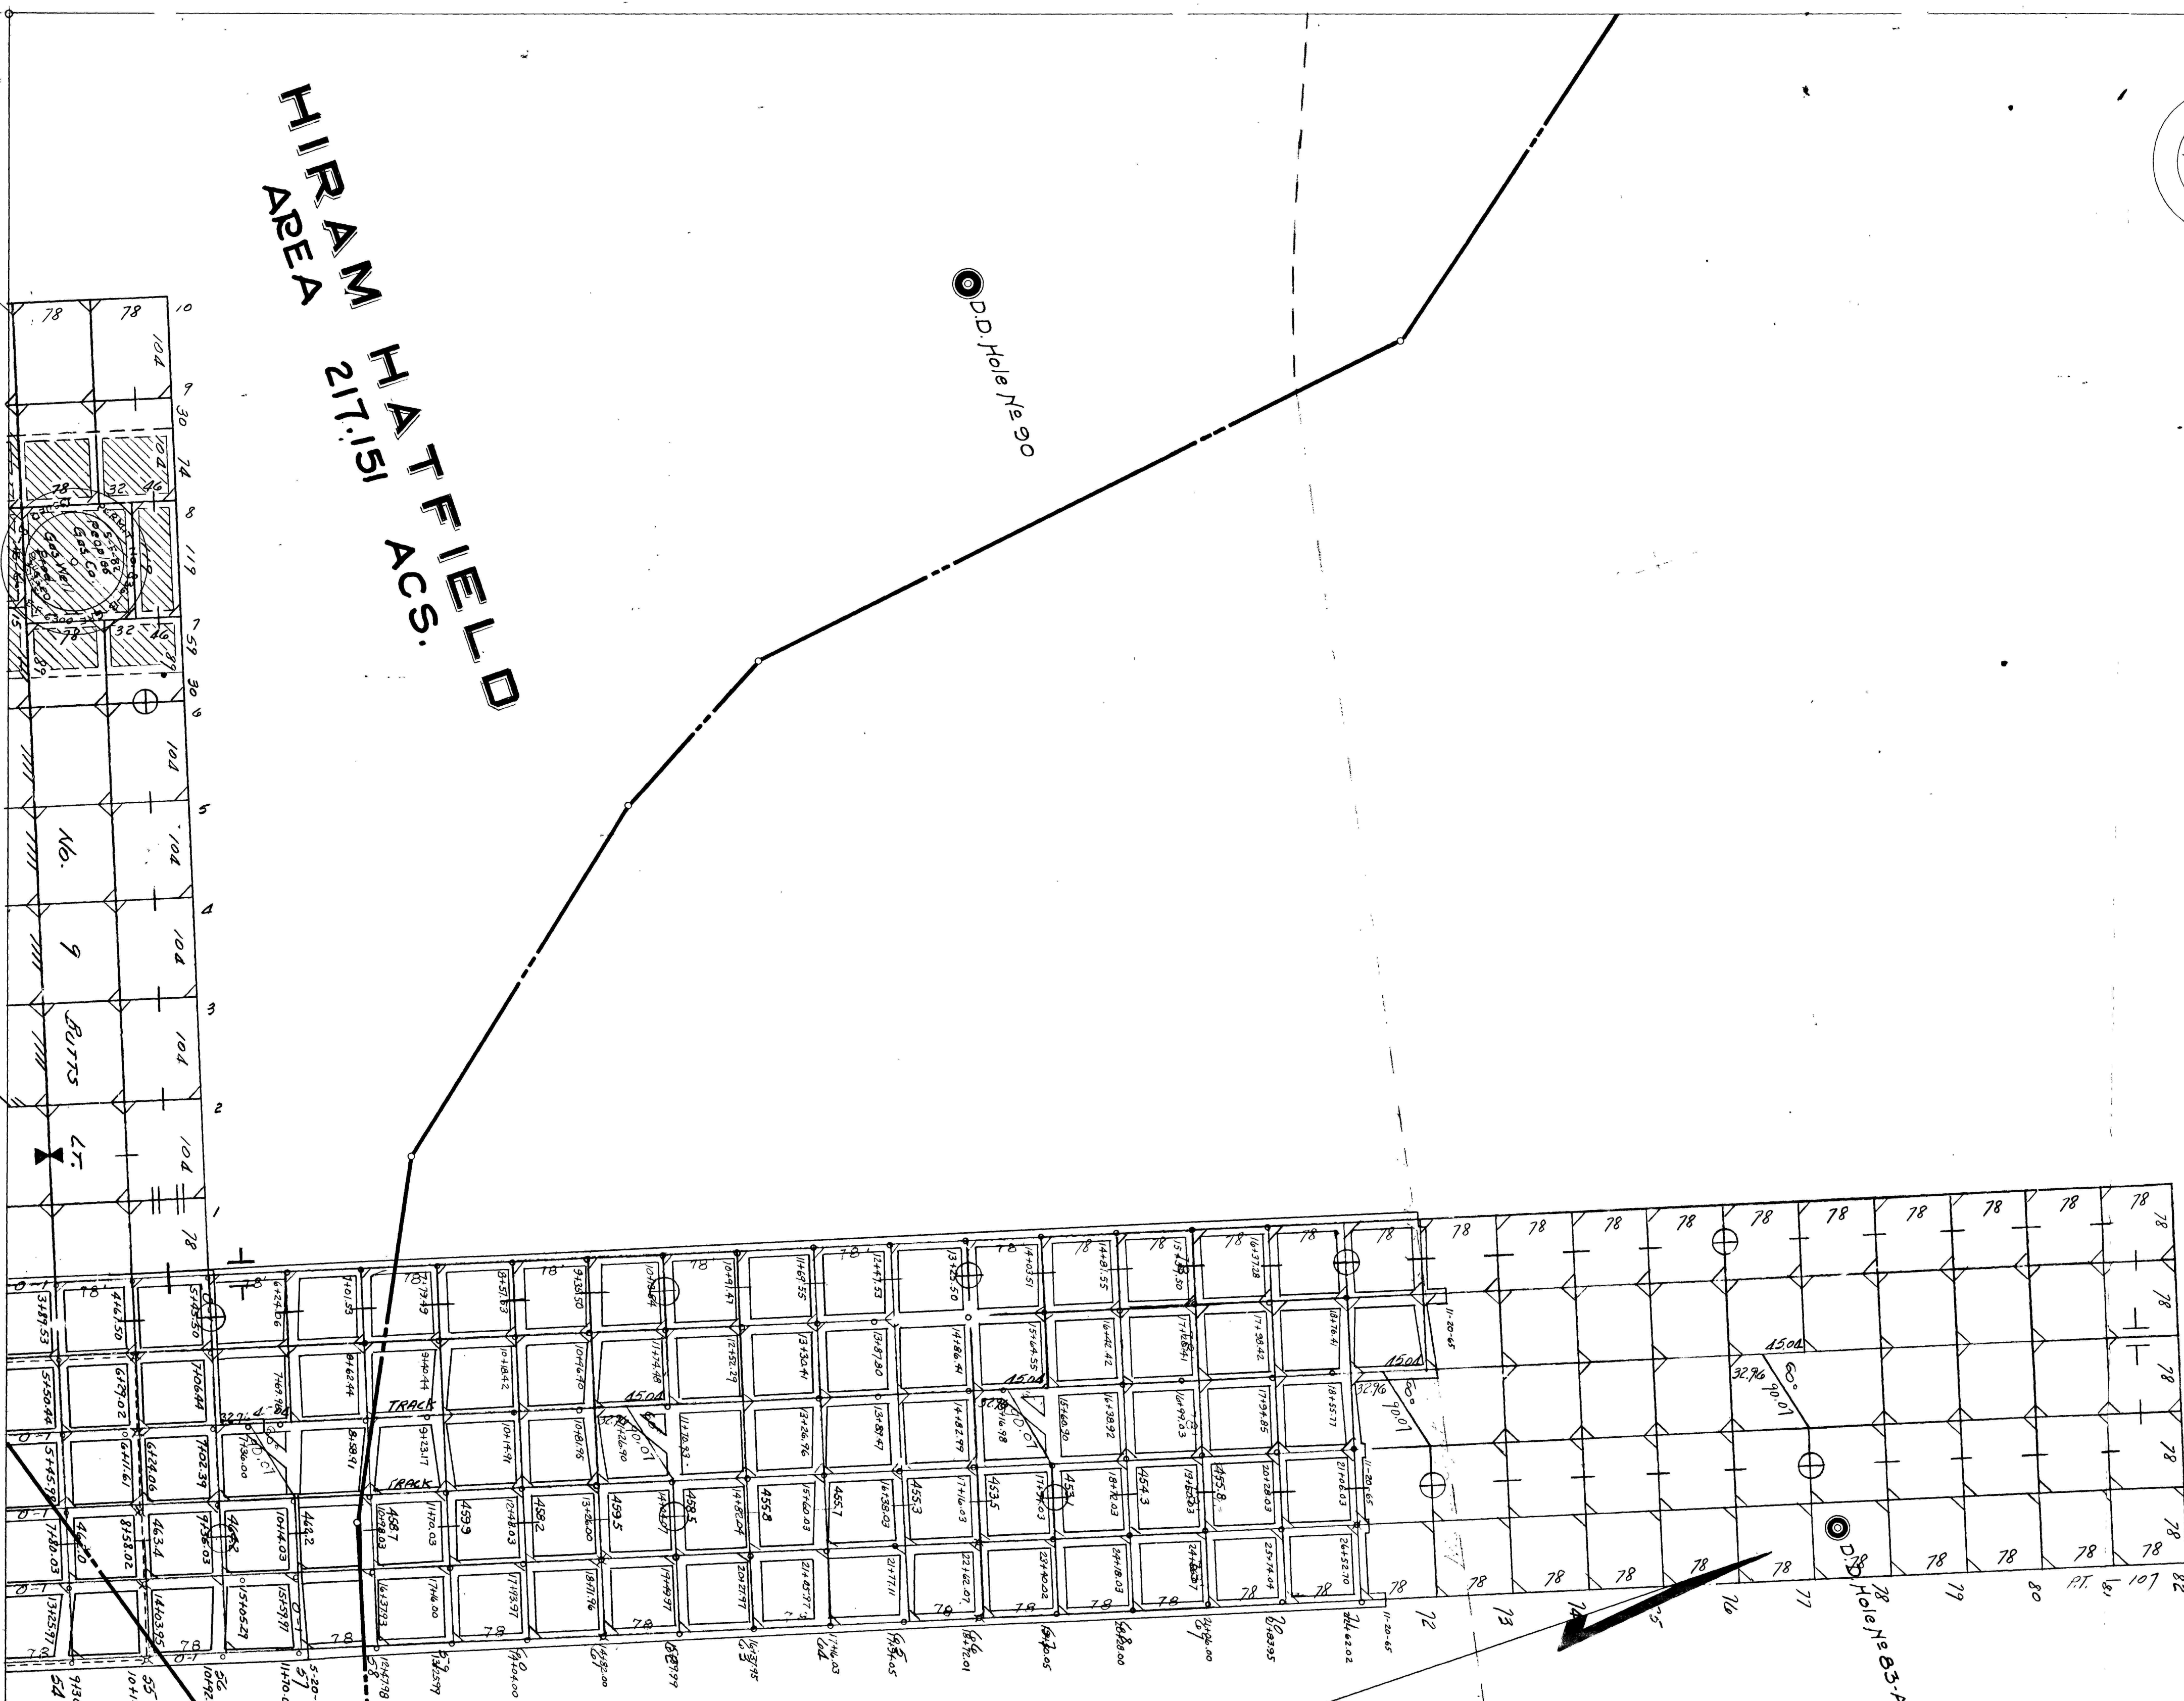

FIT TO 480

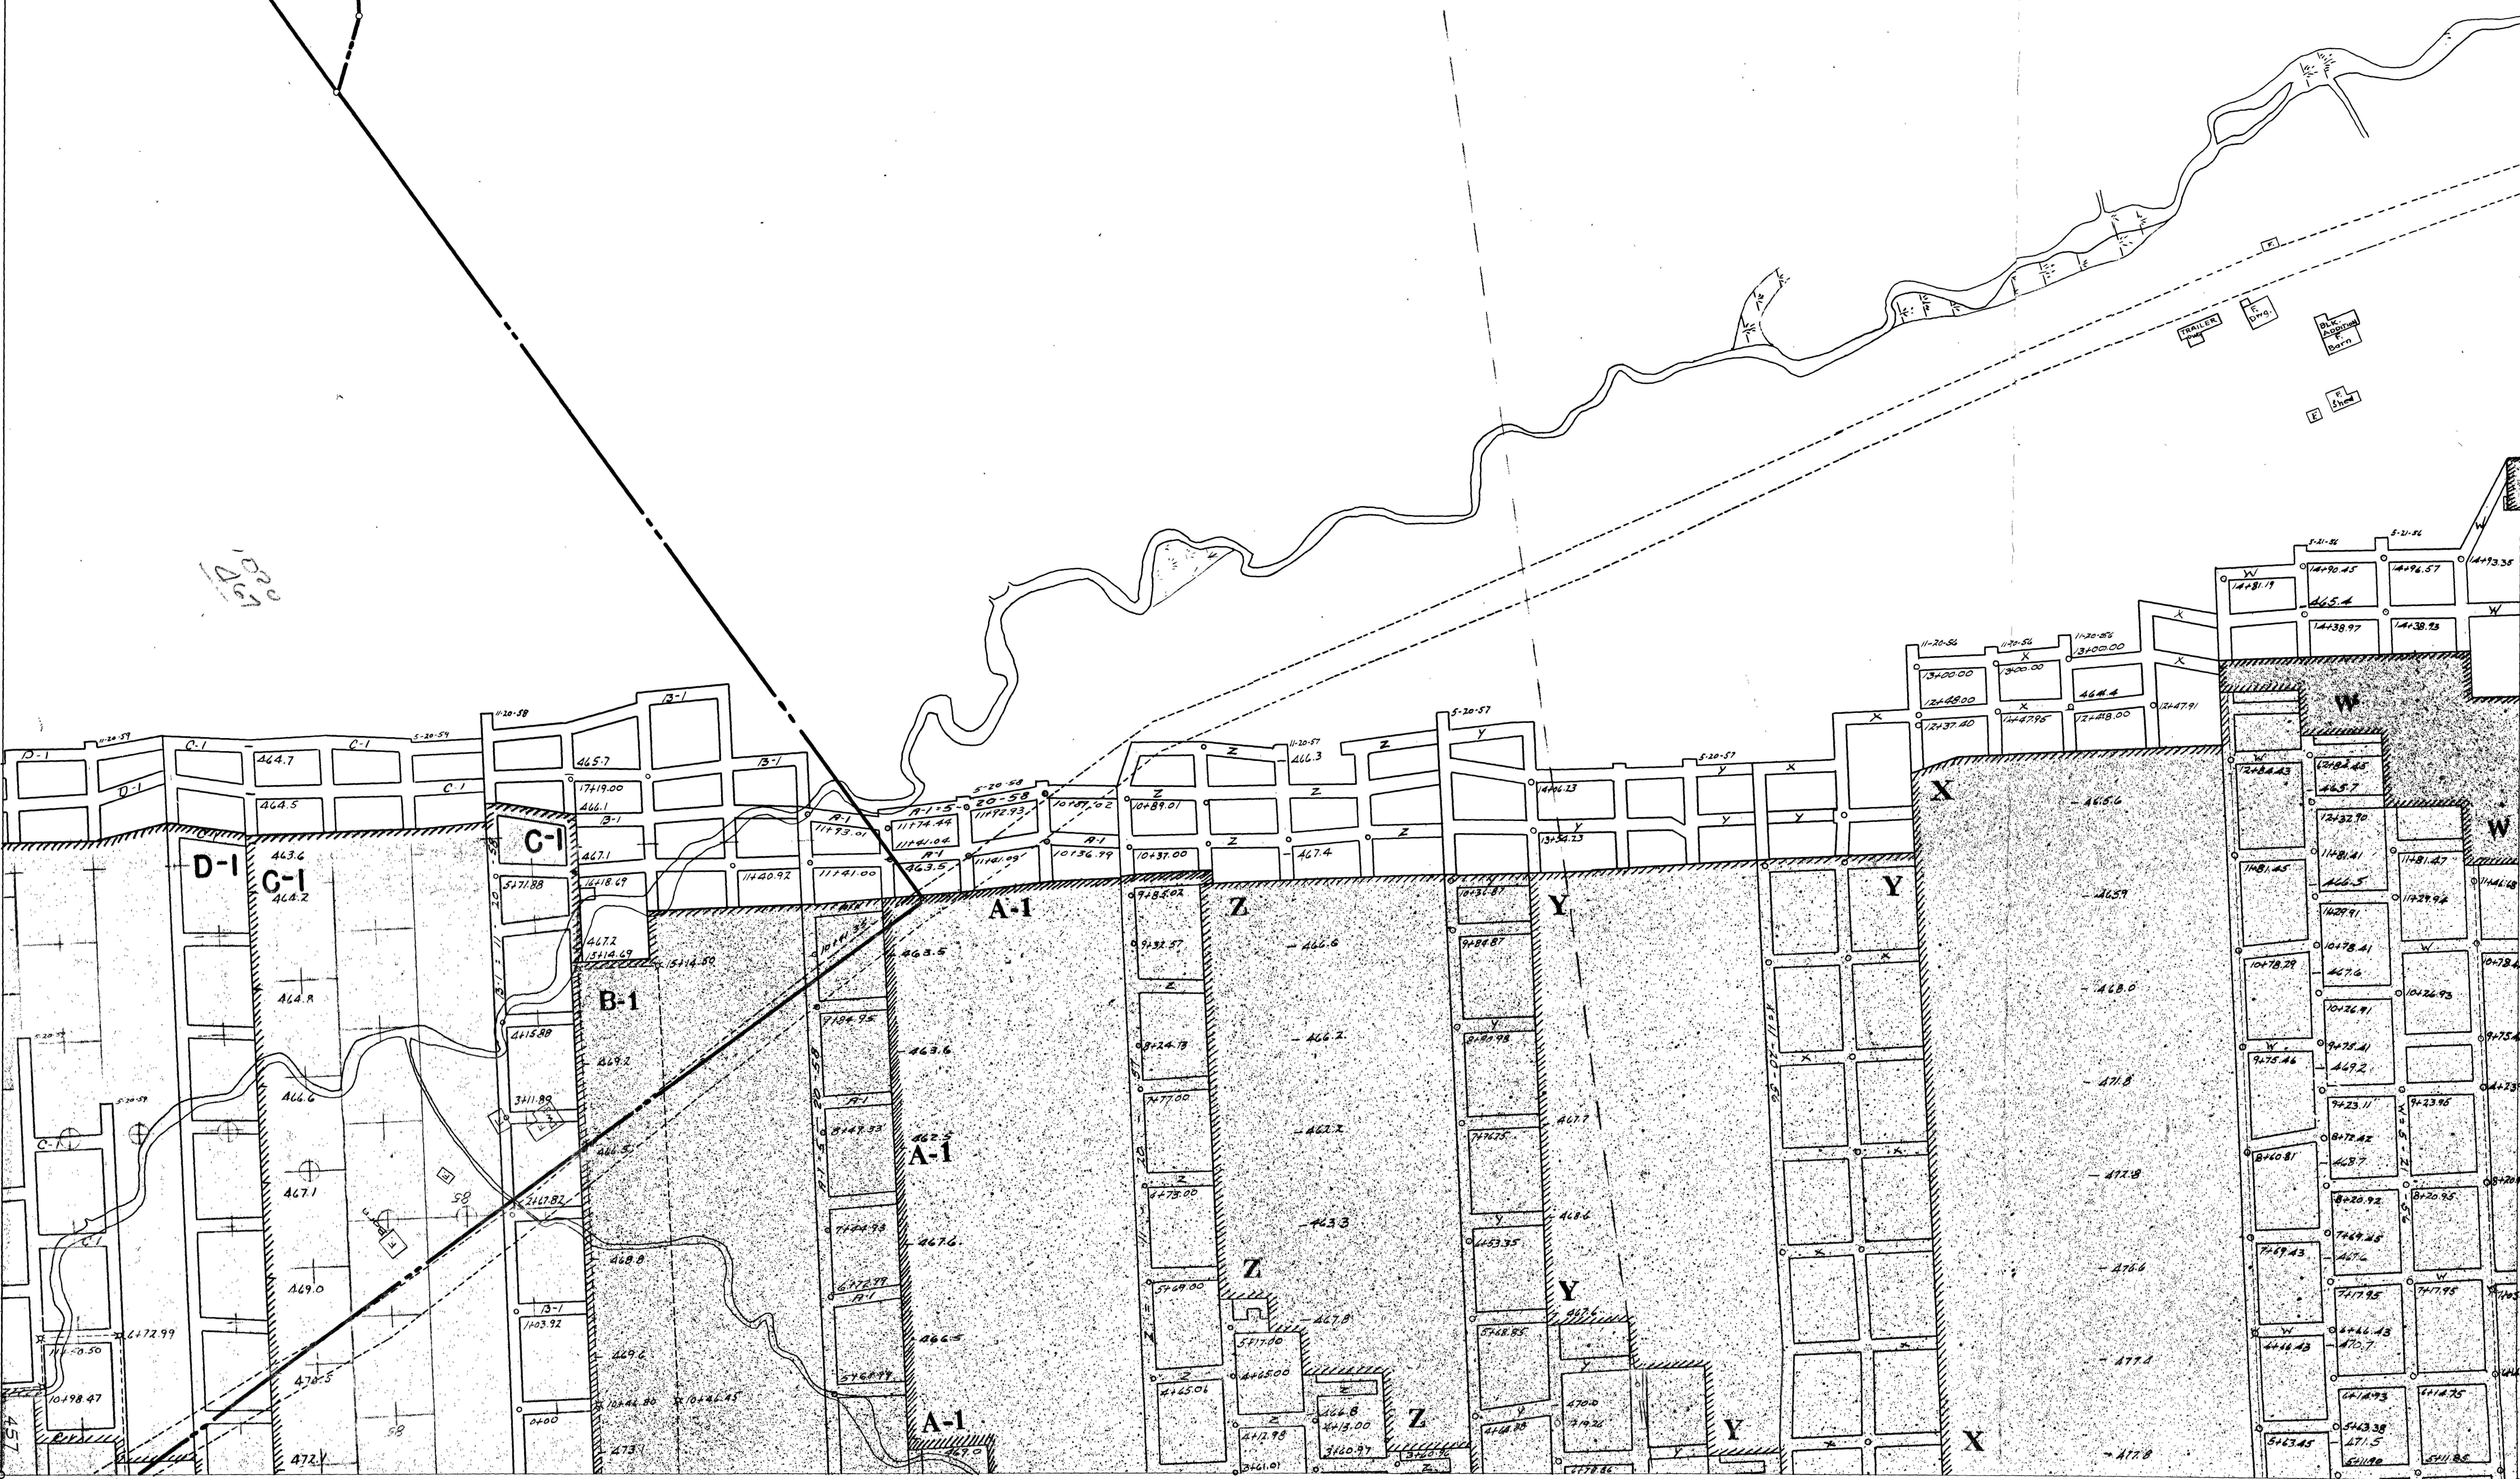

FIT TO 456