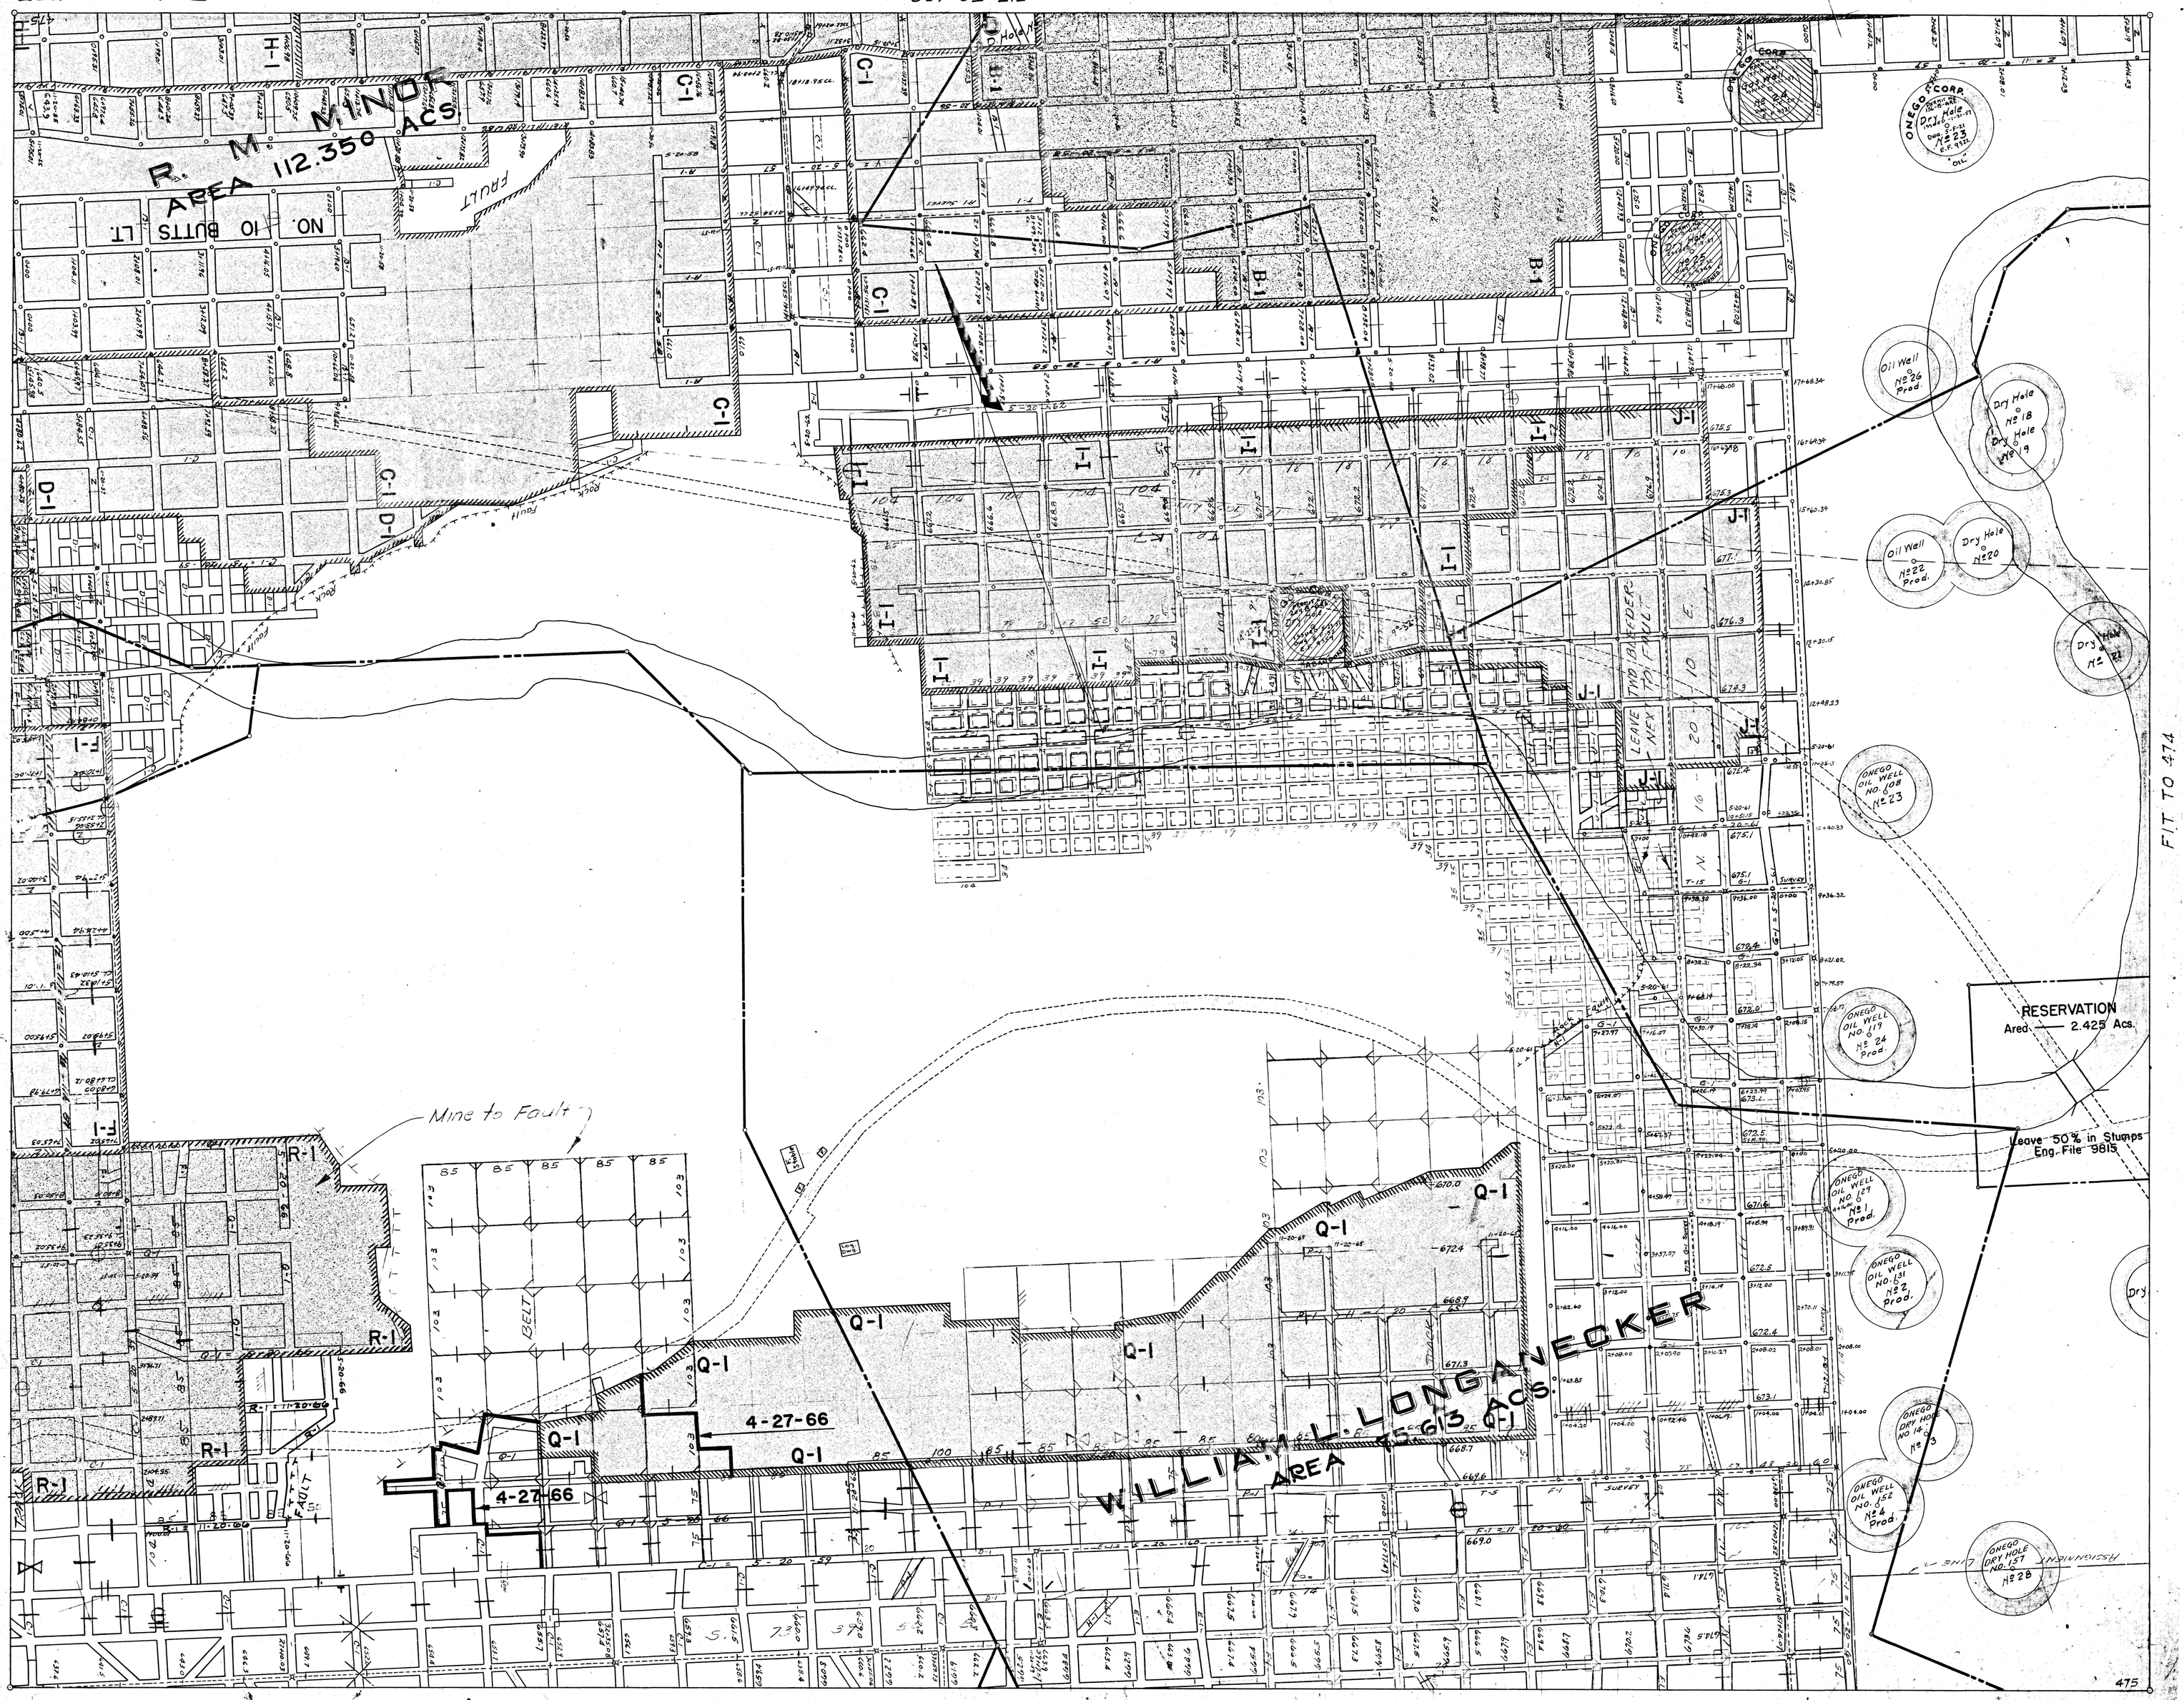
Robena 475
FIT TO 452
R. M. MINOR
AREA 112.350 ACS.
NO. 10 BUTTS LT.
FAULT
Mine to Fault
WILLIAM L. LONGANECKER
AREA 75.613 ACS.
4-27-66
4-27-66
LEAVE TWO BLEEDERS NEXT TO FAULT
RESERVATION
Area 2.425 Acs.
Leave 50% in Stumps
Eng. File 9815
ONEGO CORP.
Dry Hole No 23
Oil Well No 26 Prod.
Dry Hole No 18
Dry Hole No 19
Oil Well No 22 Prod.
Dry Hole No 20
Dry Hole No 21
ONEGO OIL WELL NO. 108 No 23
ONEGO OIL WELL NO. 119 No 24 Prod.
ONEGO OIL WELL NO. 129 No 1 Prod.
ONEGO OIL WELL NO. 131 No 2 Prod.
ONEGO DRY HOLE NO 14 No 3
ONEGO OIL WELL NO. 152 No 4 Prod.
ONEGO DRY HOLE NO. 157 No 28
FIT TO 474
FIT TO 476
FIT TO 498
475
Robena 475