


FIT TO 499.

ROBENA 476

ANDREW LANTZ
AREA 57.518 ACS.

FIT TO 477

LEAVE BLEEDER HENDING

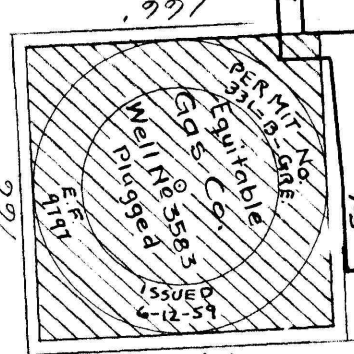

FIT TO 475

BENSON JOHNSON
AREA 63.601 ACS.

OUTLINE ROCK FAULT
LEAVE BLEEDER HENDING

FIT TO 453

ROBENA 476