


D.D.HOLE 106-A

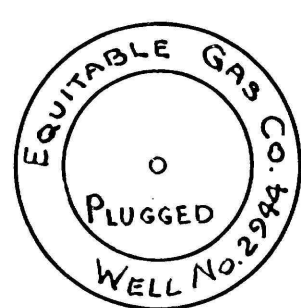

D.D.HOLE NO. III

TRACT NO. 606
E M E L I N E H A R T L E Y
AREA 147.574 ACRES



D.D.HOLE 107-A

D.D.HOLE 110-R