


Fit To 522

Robena 498

Fit To 499

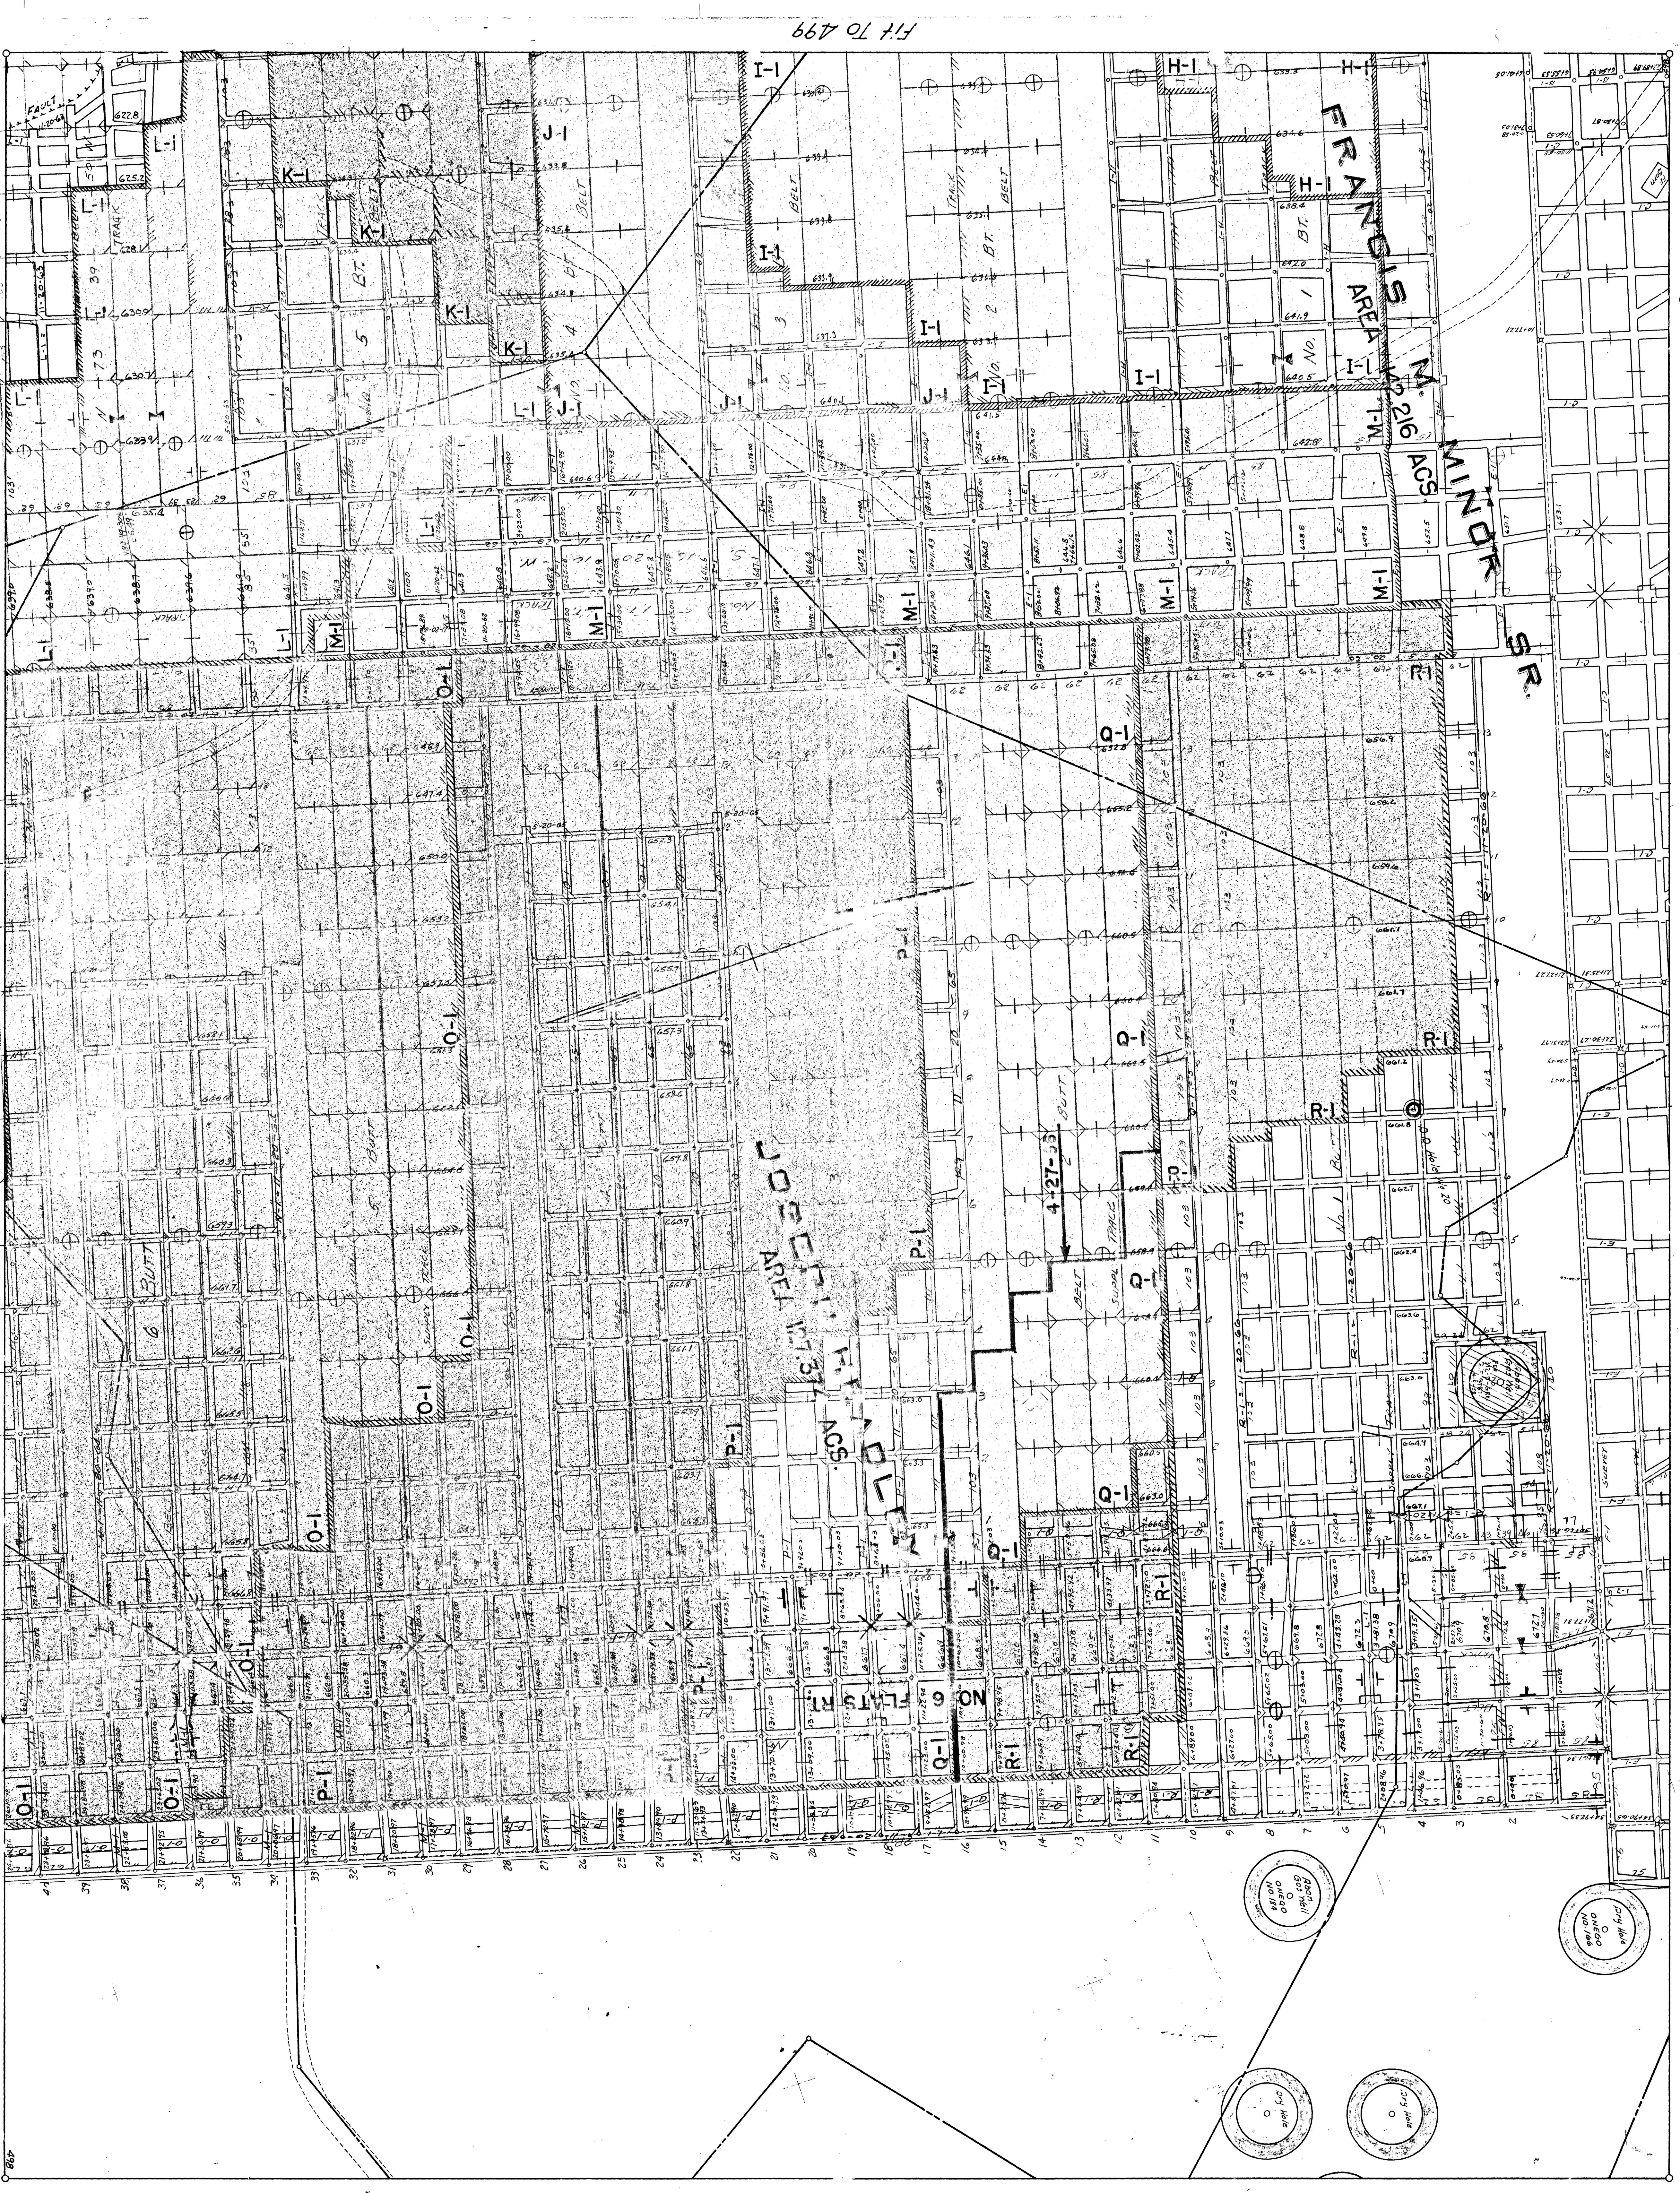

Robena 498

Fit To 475

Fit To 497