


FIT TO 524

ROBENA 500

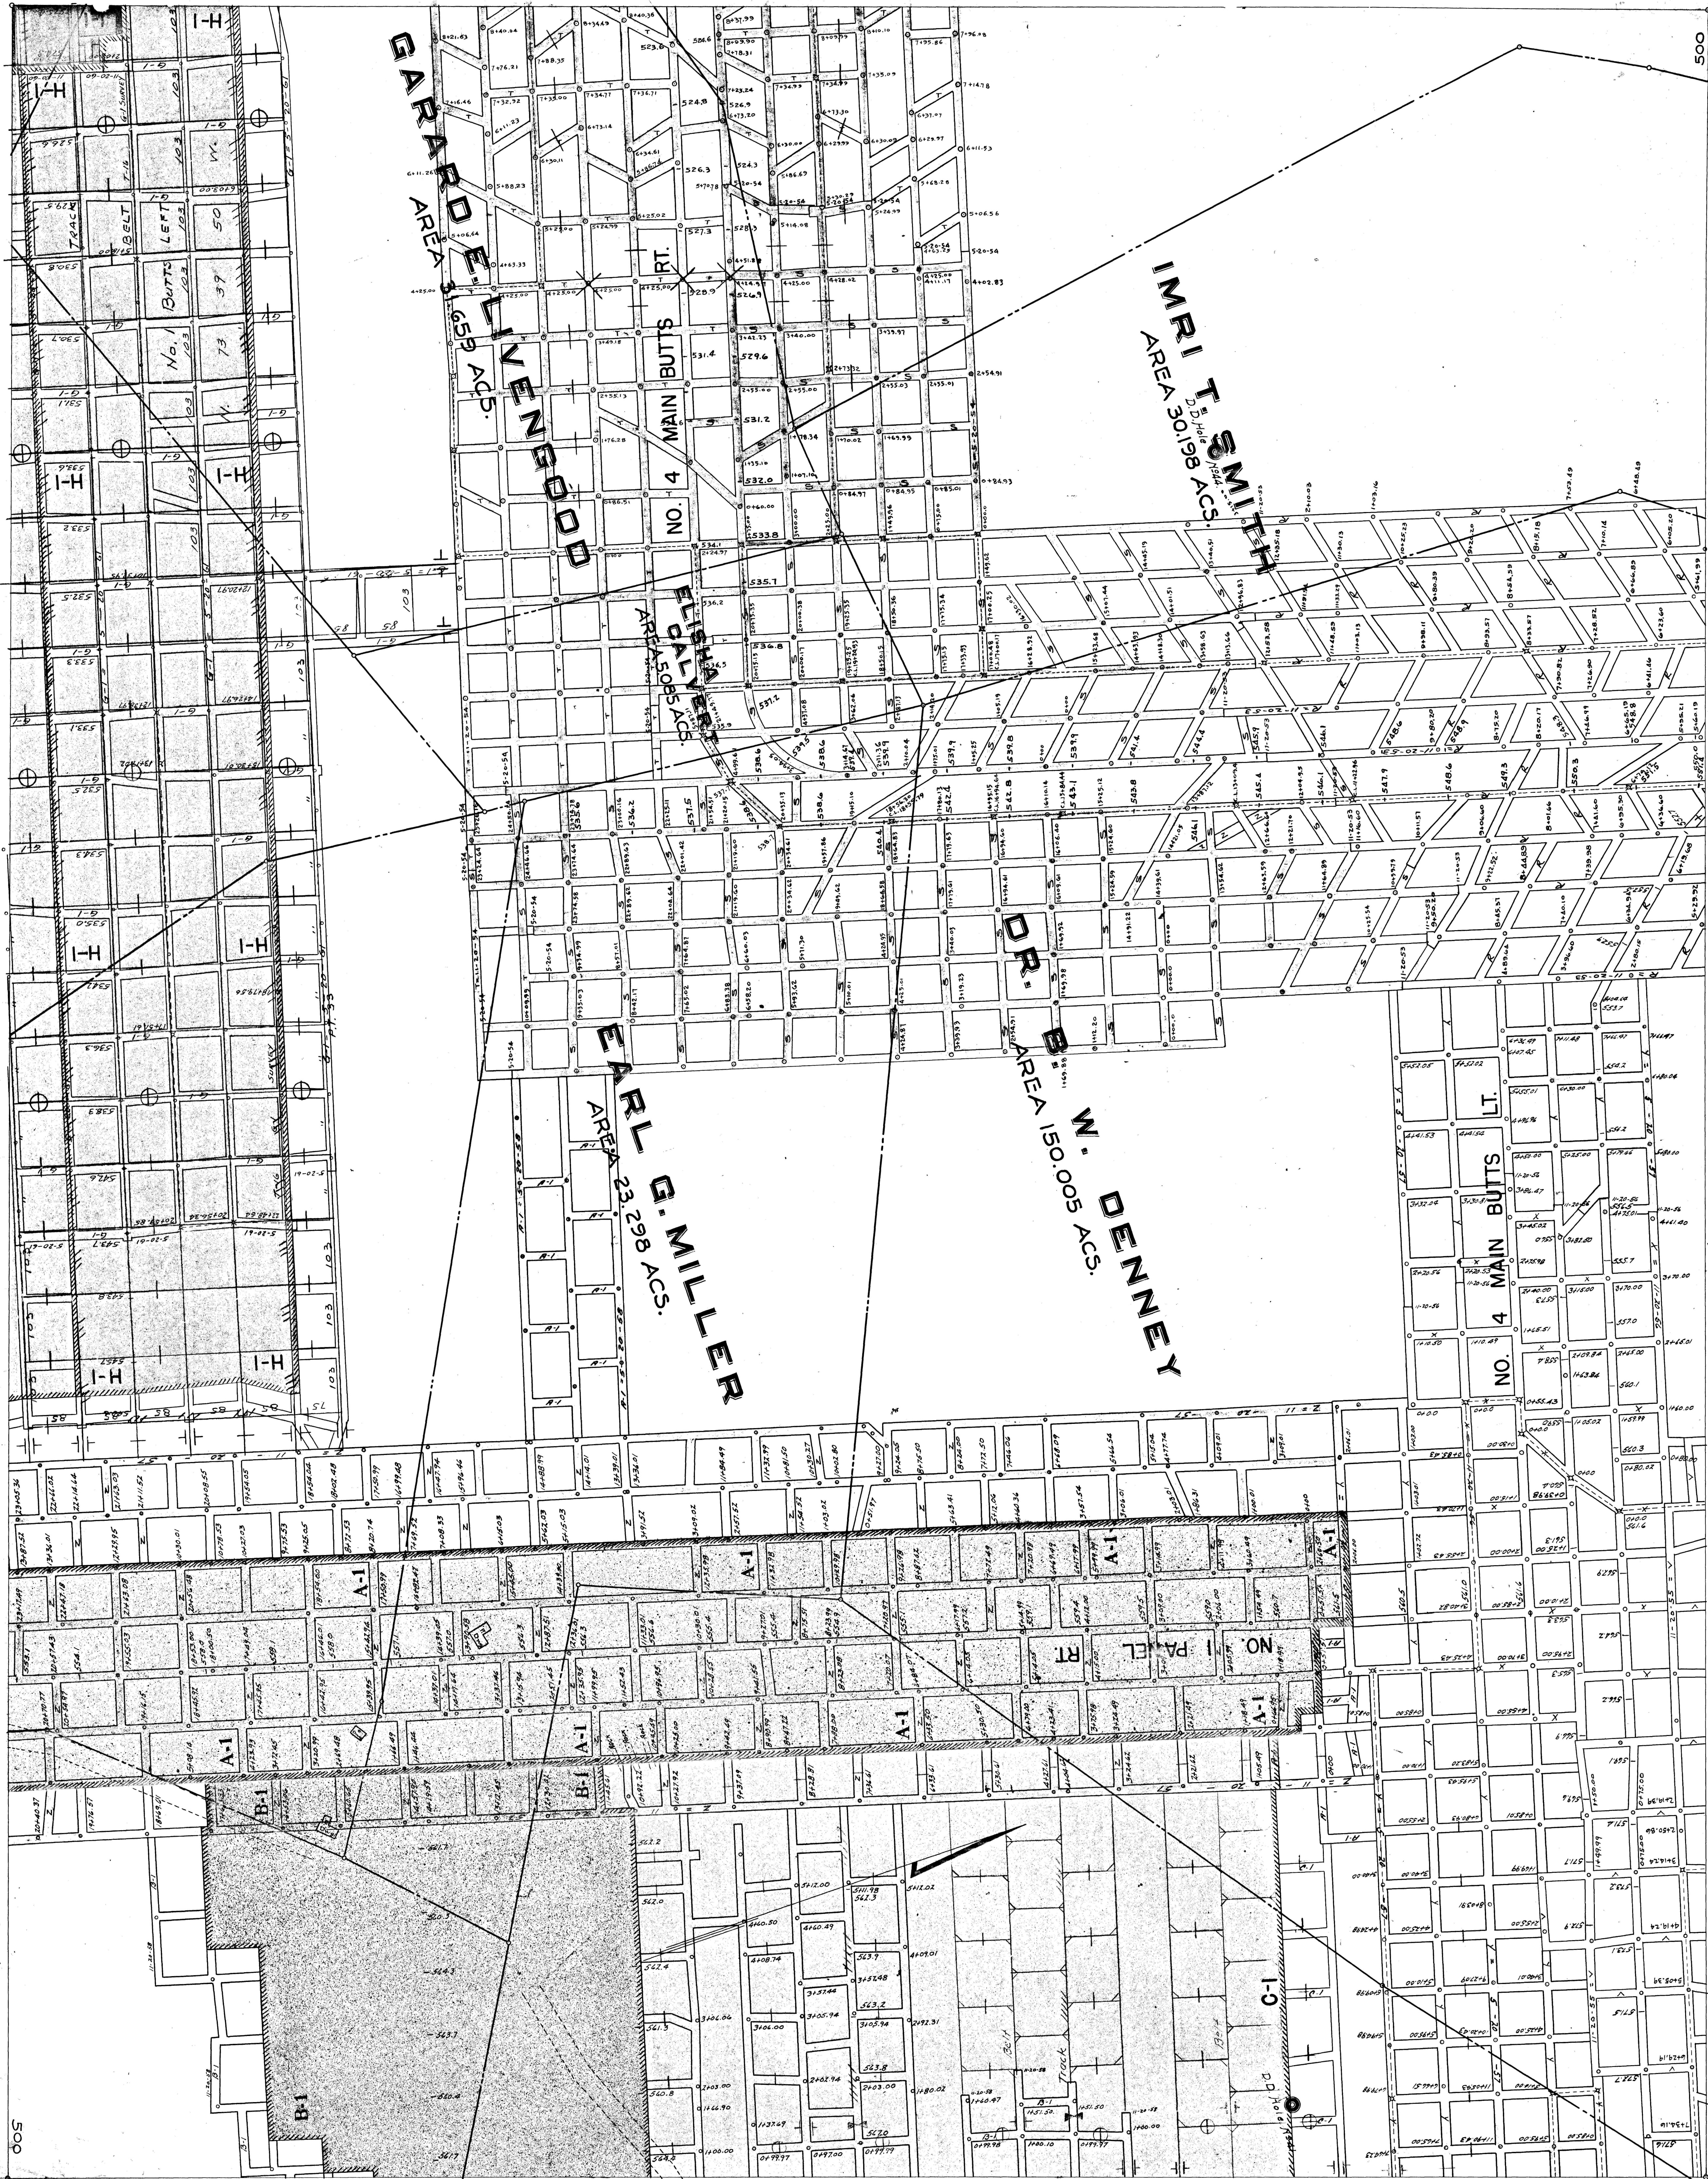

FIT TO 499

FIT TO 477

ROBENA 500