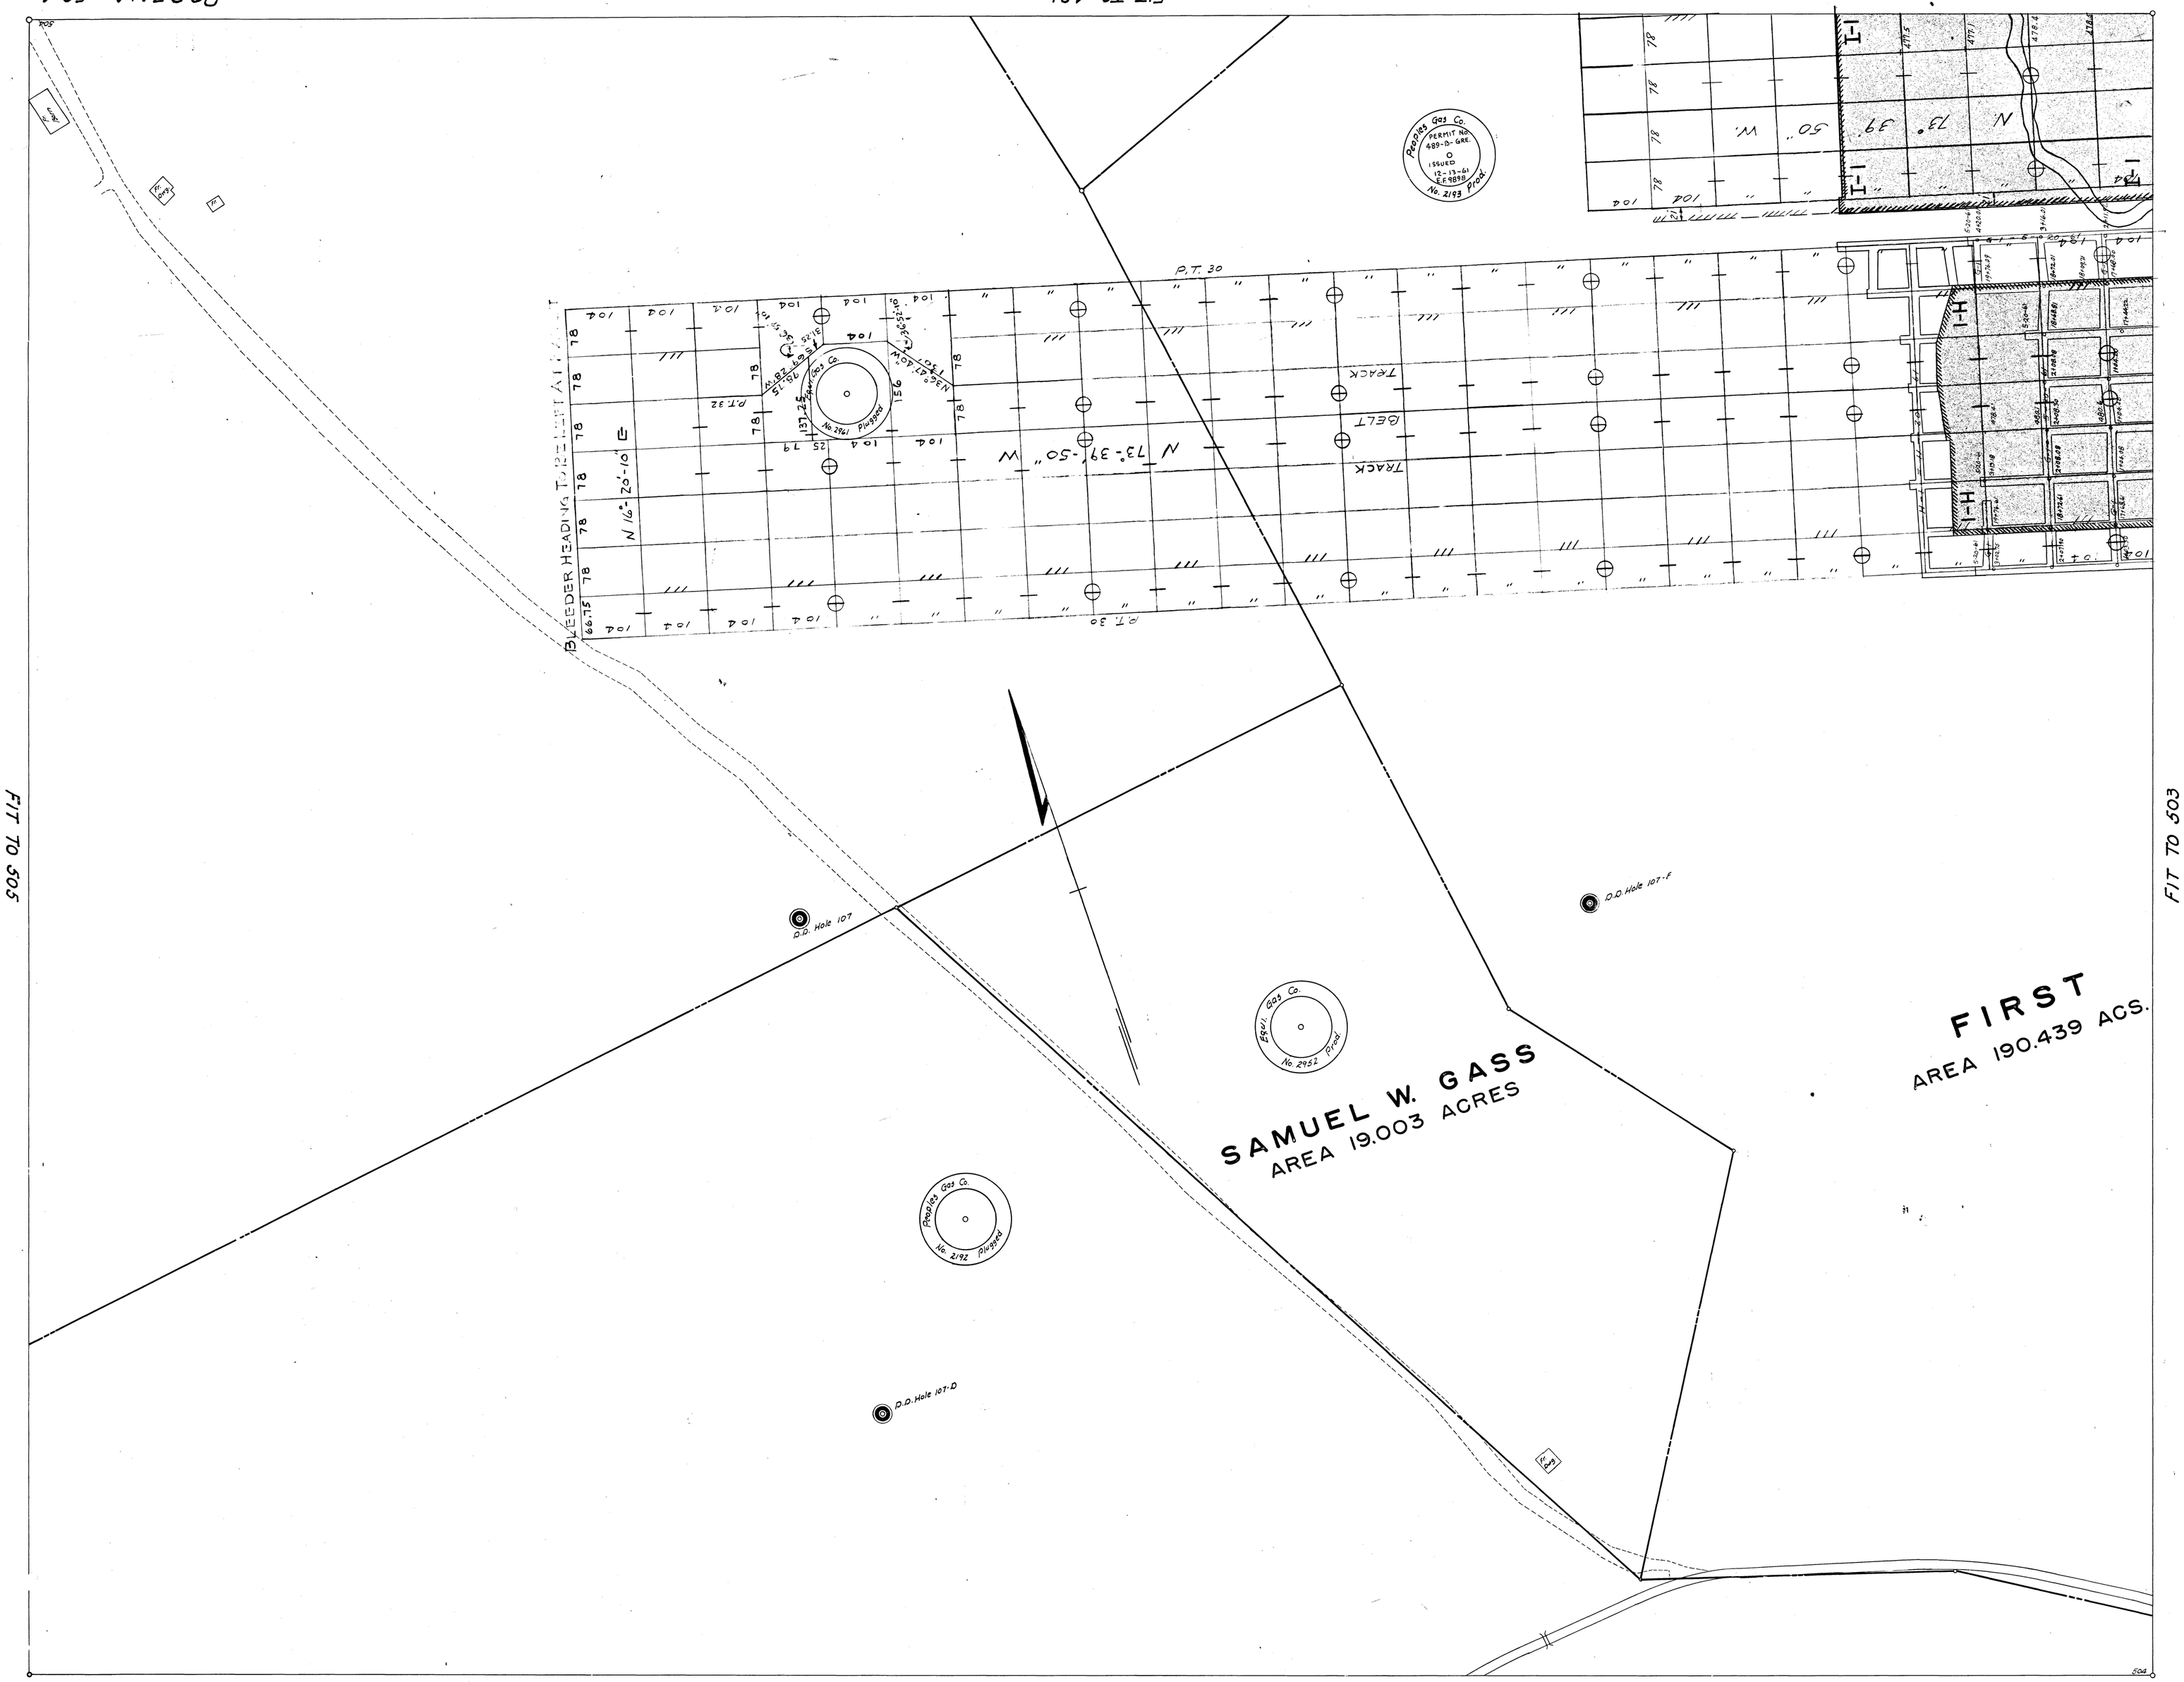
FIT TO 481
ROBENA 504
FIT TO 505
FIT TO 503
FIT TO 528
ROBENA 504
BLEEDER HEADING TURNOUT
P.T. 30
N 16°-20'-10" E
N 73°-39'-50" W
TRACK
BELT
TRACK
P.T. 30
P.T. 32
Peoples Gas Co.
No. 2962 Plugged
Peoples Gas Co.
PERMIT No.
489-D-GRE.
ISSUED
12-13-61
E.E. 9838
No. 2193 Prod.
Equi. Gas Co.
No. 2952 Prod.
Peoples Gas Co.
No. 2192 Plugged
D.D. Hole 107
D.D. Hole 107-D
D.D. Hole 107-F
SAMUEL W. GASS
AREA 19.003 ACRES
FIRST
AREA 190.439 ACS.
N 73° 39' 50" W.
I-I
H-I