


J. S. BOWERS
AREA 202.313 ACS.

Pr. Barn


Pr. Log

Pr. Pump

Long Run

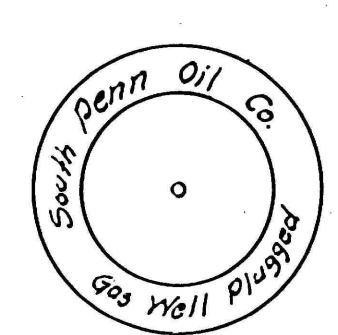

O.D. Hole No. 109

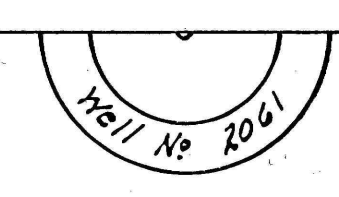

Grange & Co. Line

JAMES HATFIELD
AREA 330.643 ACS.

