


9 Right

FIT TO 4

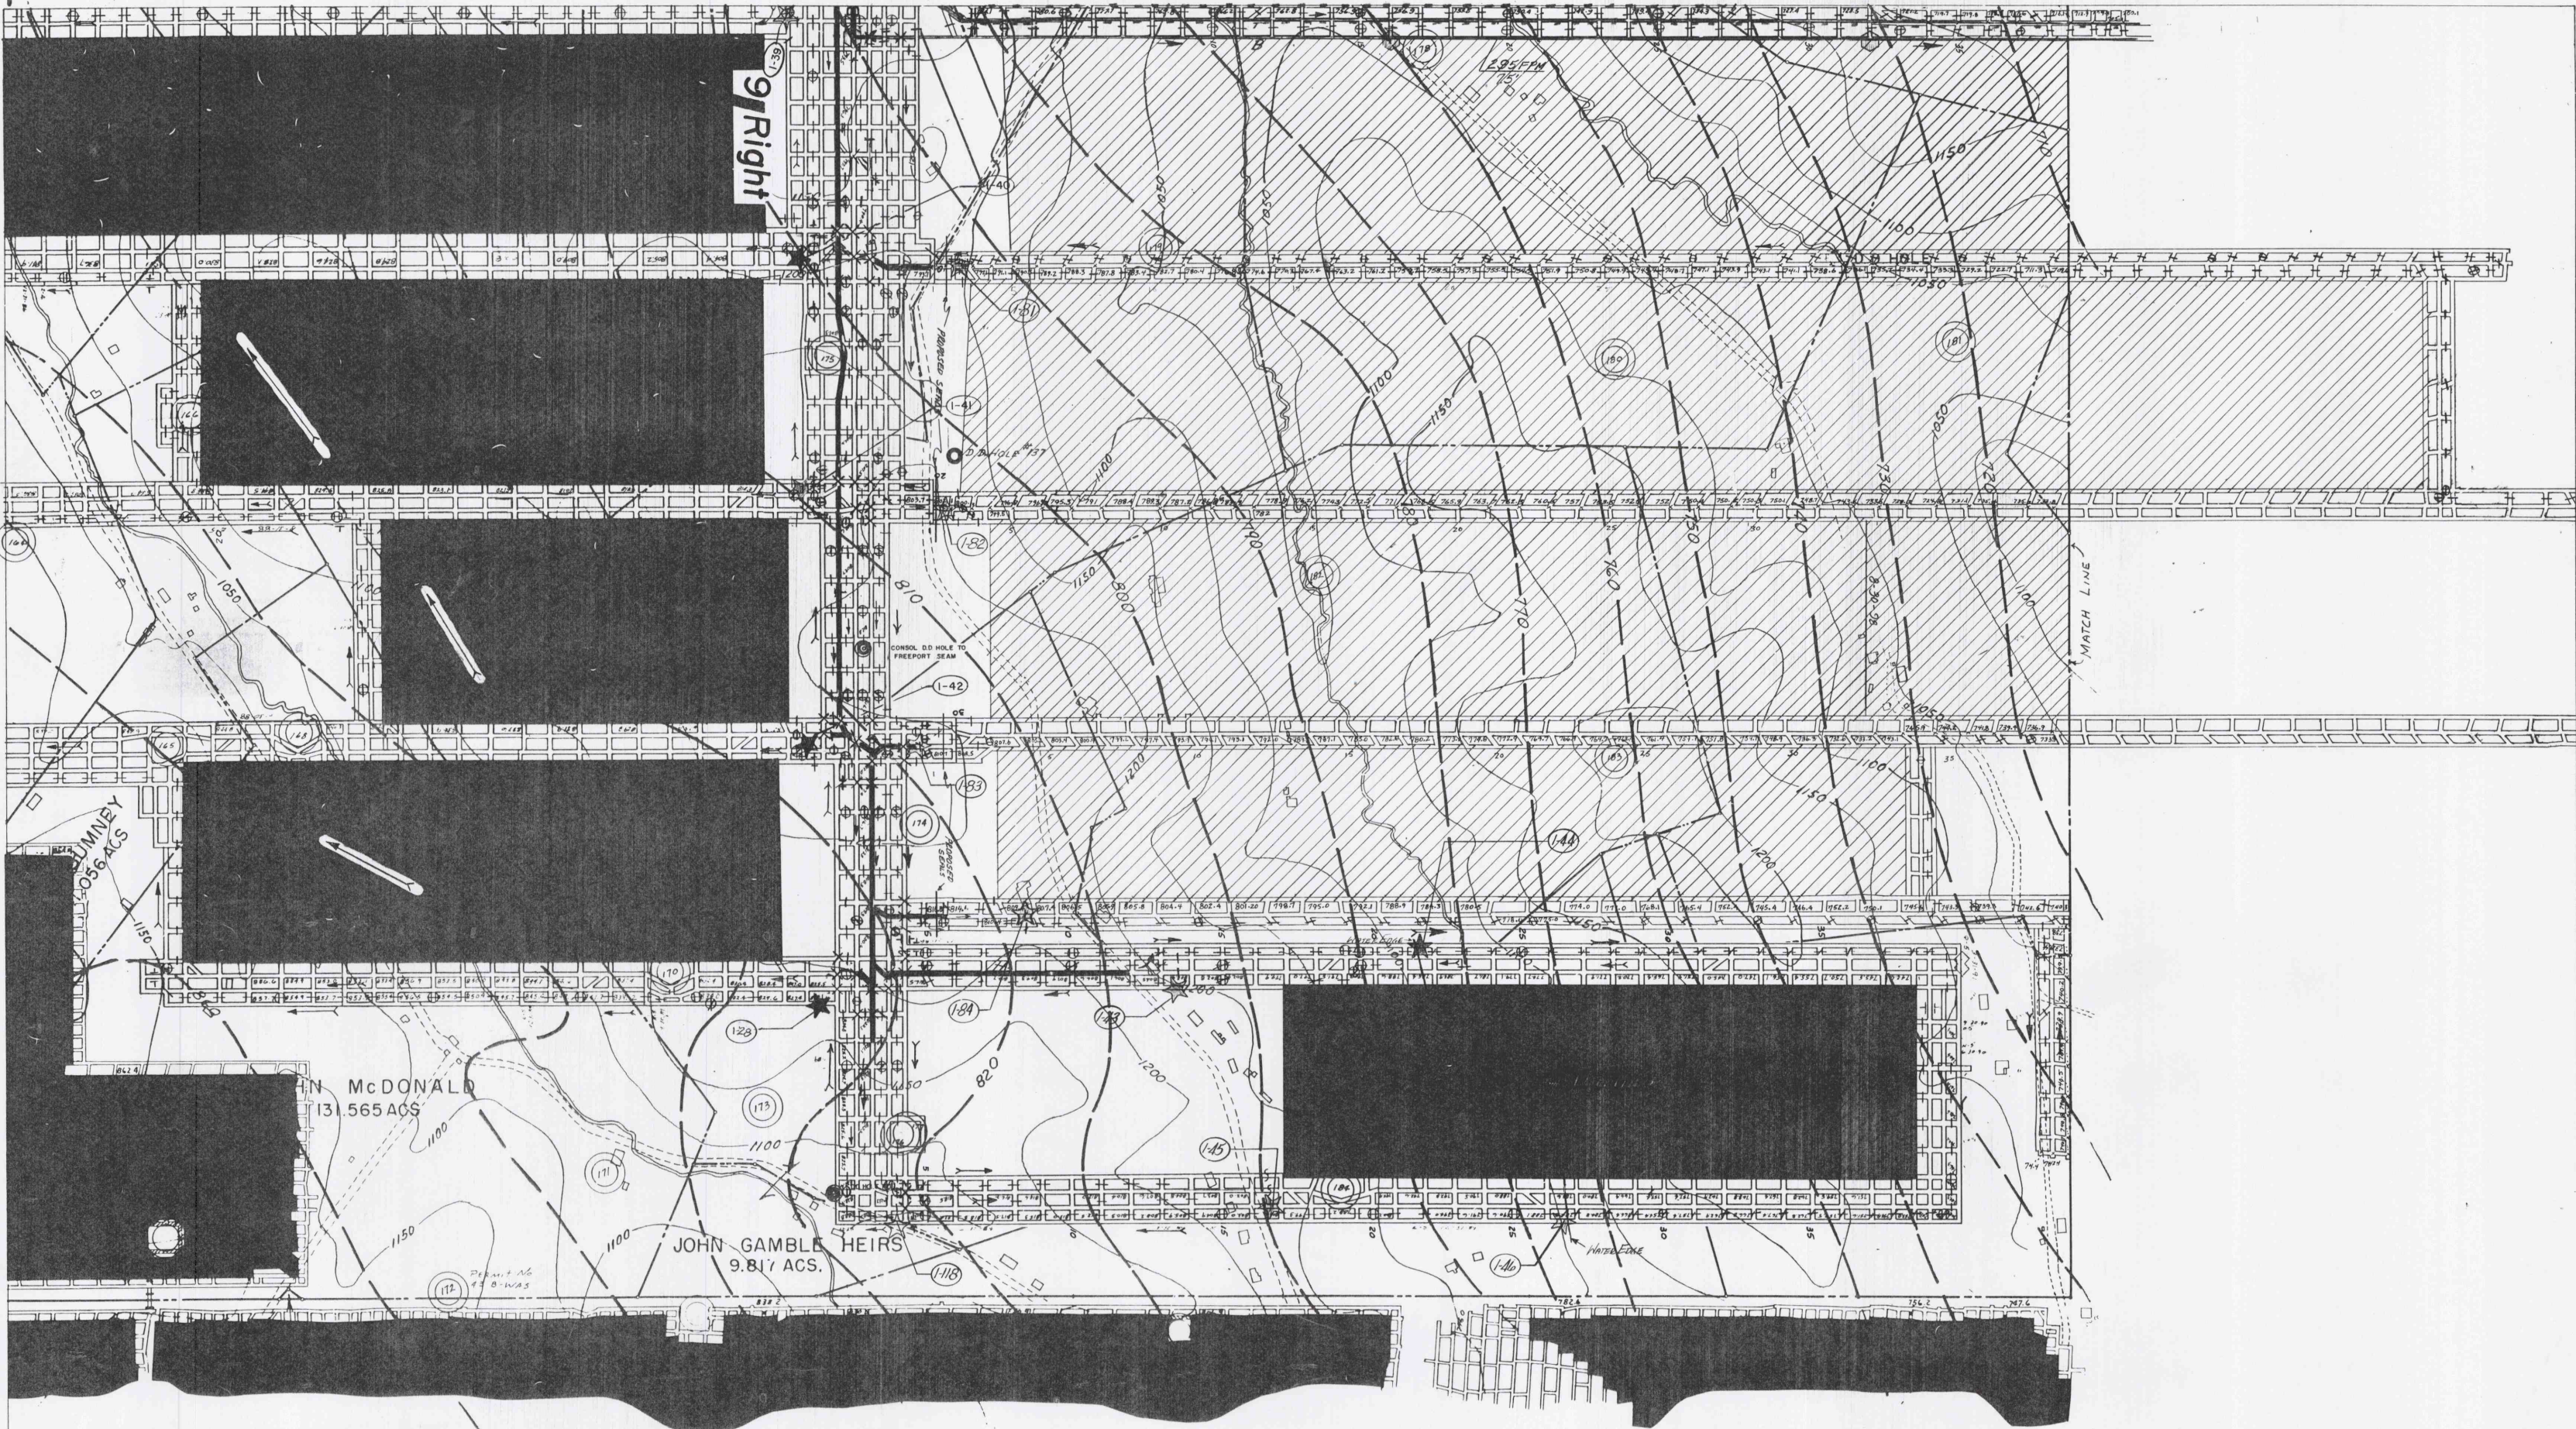

FIT TO A