


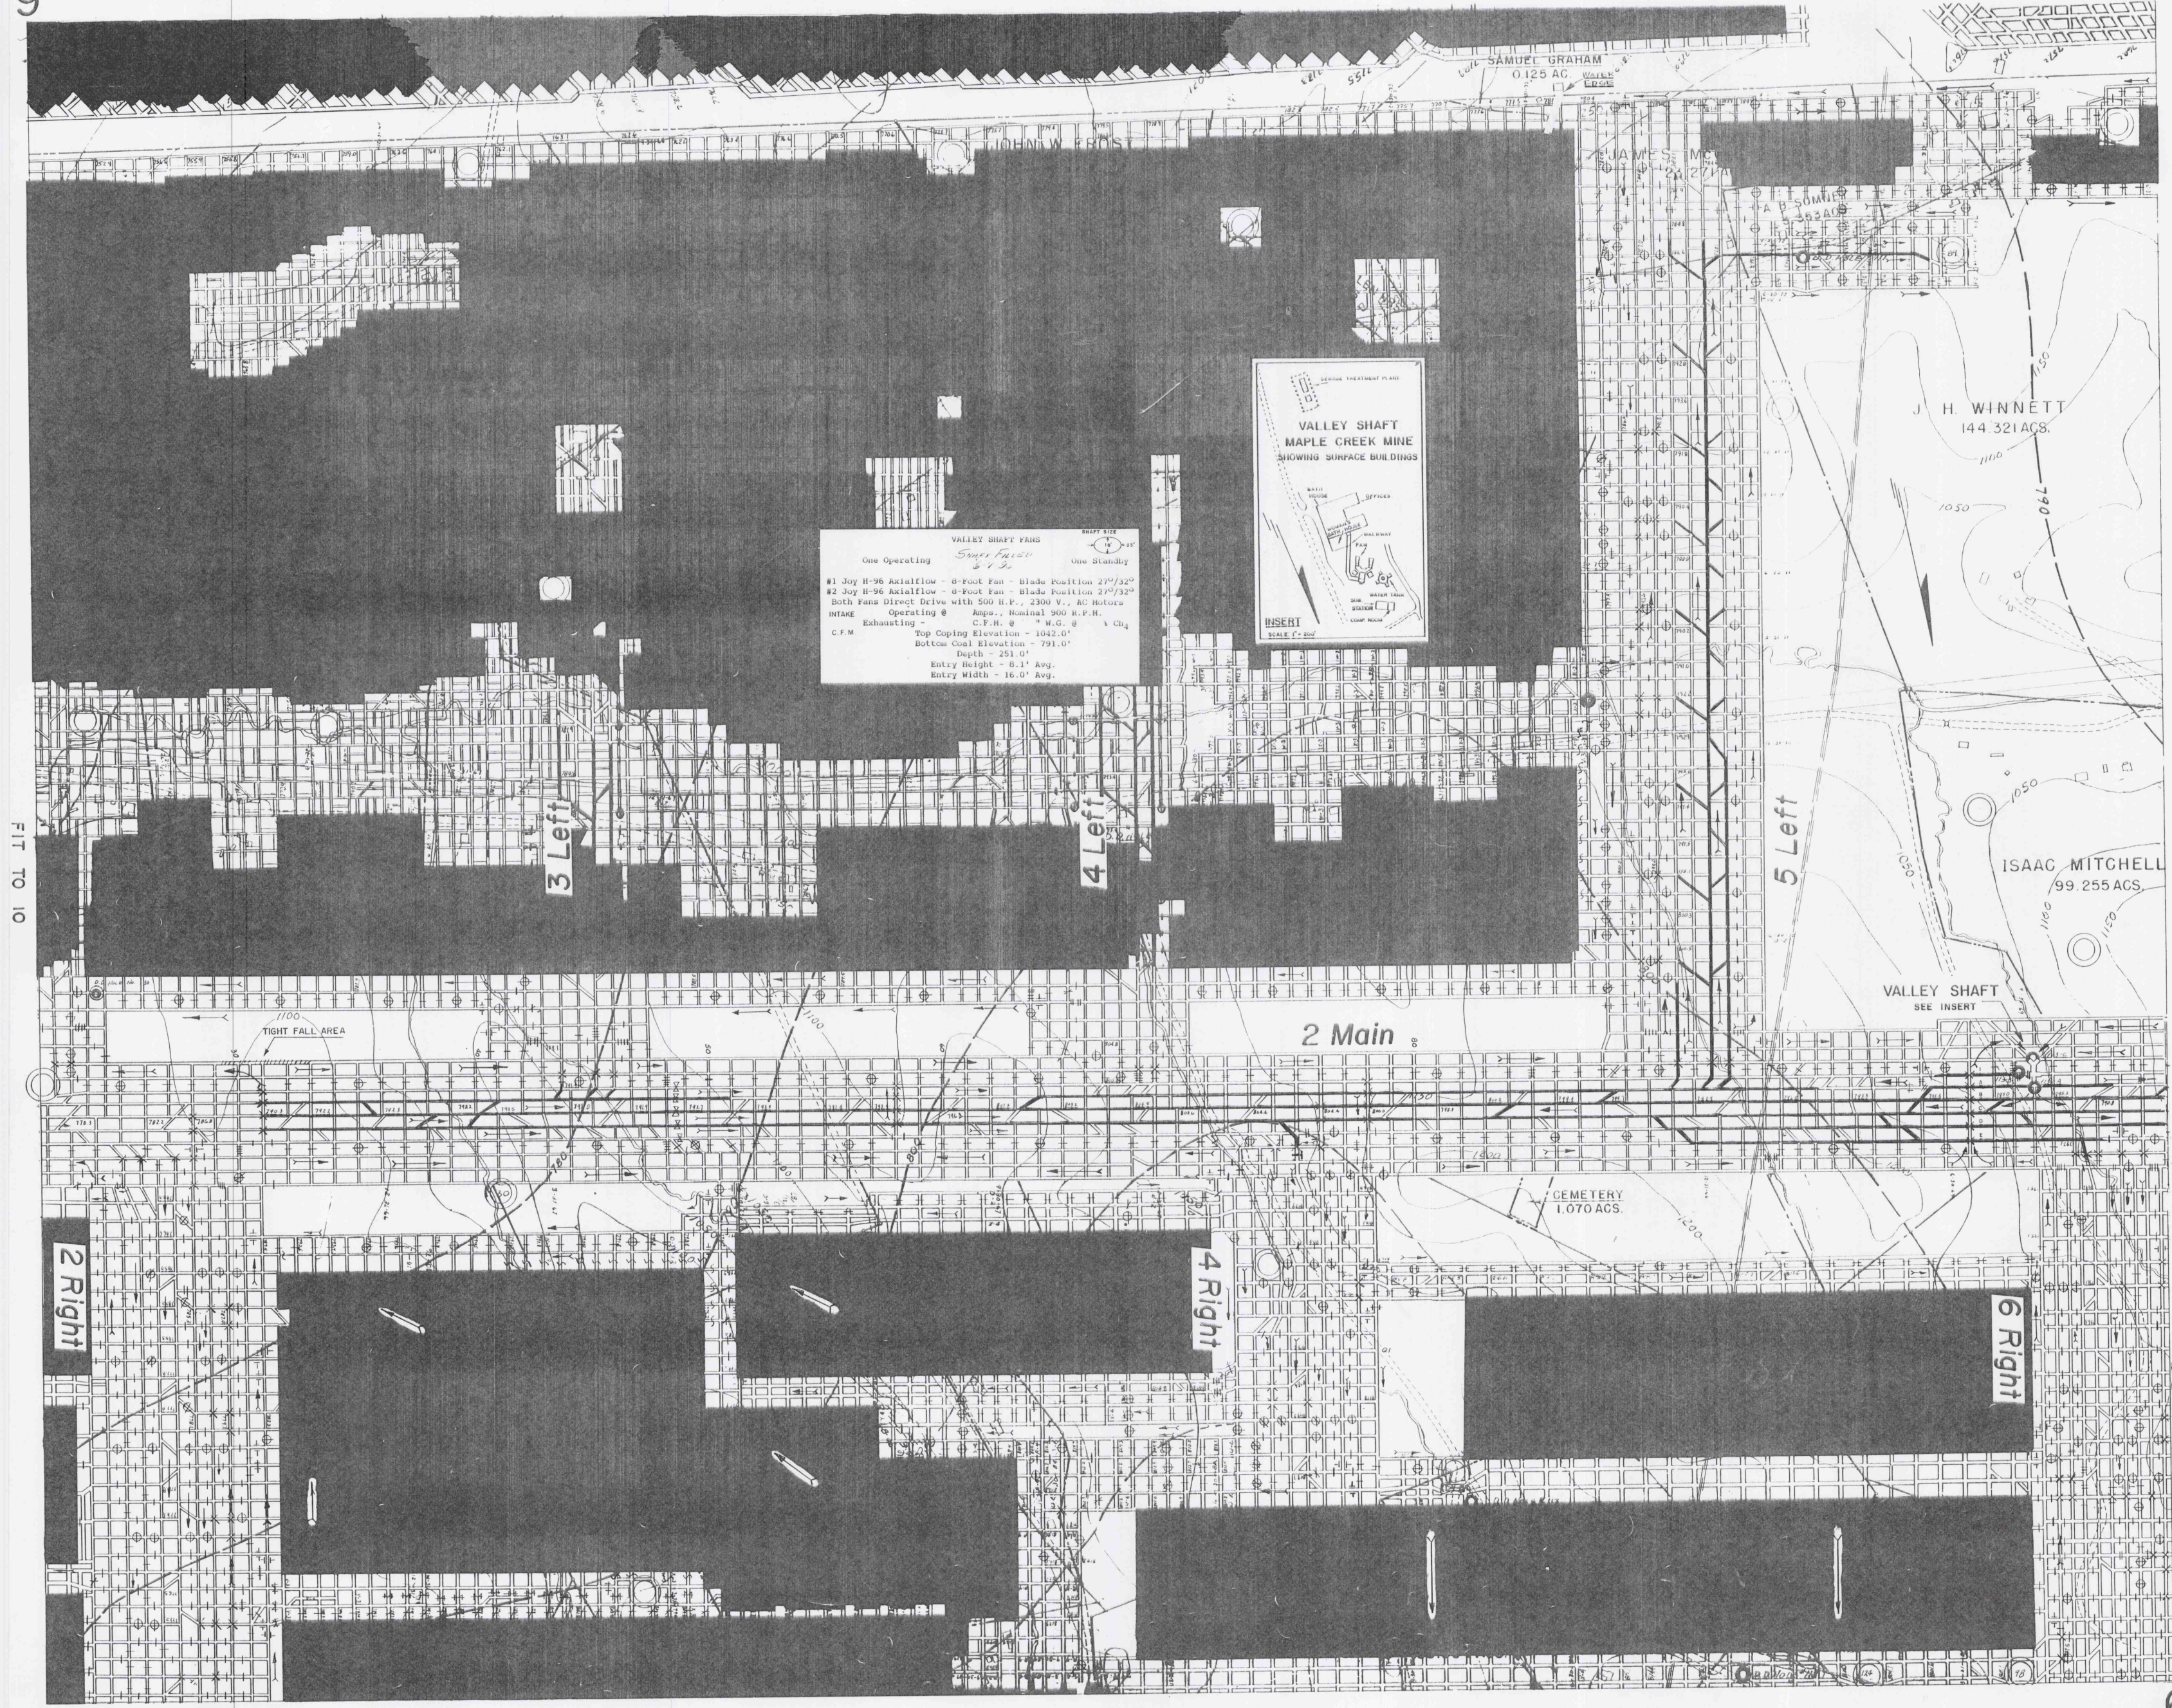

FIT TO 10

FIT TO 3