
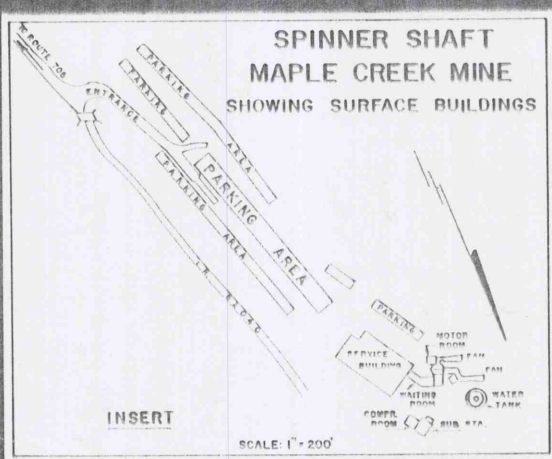


FIT TO 13

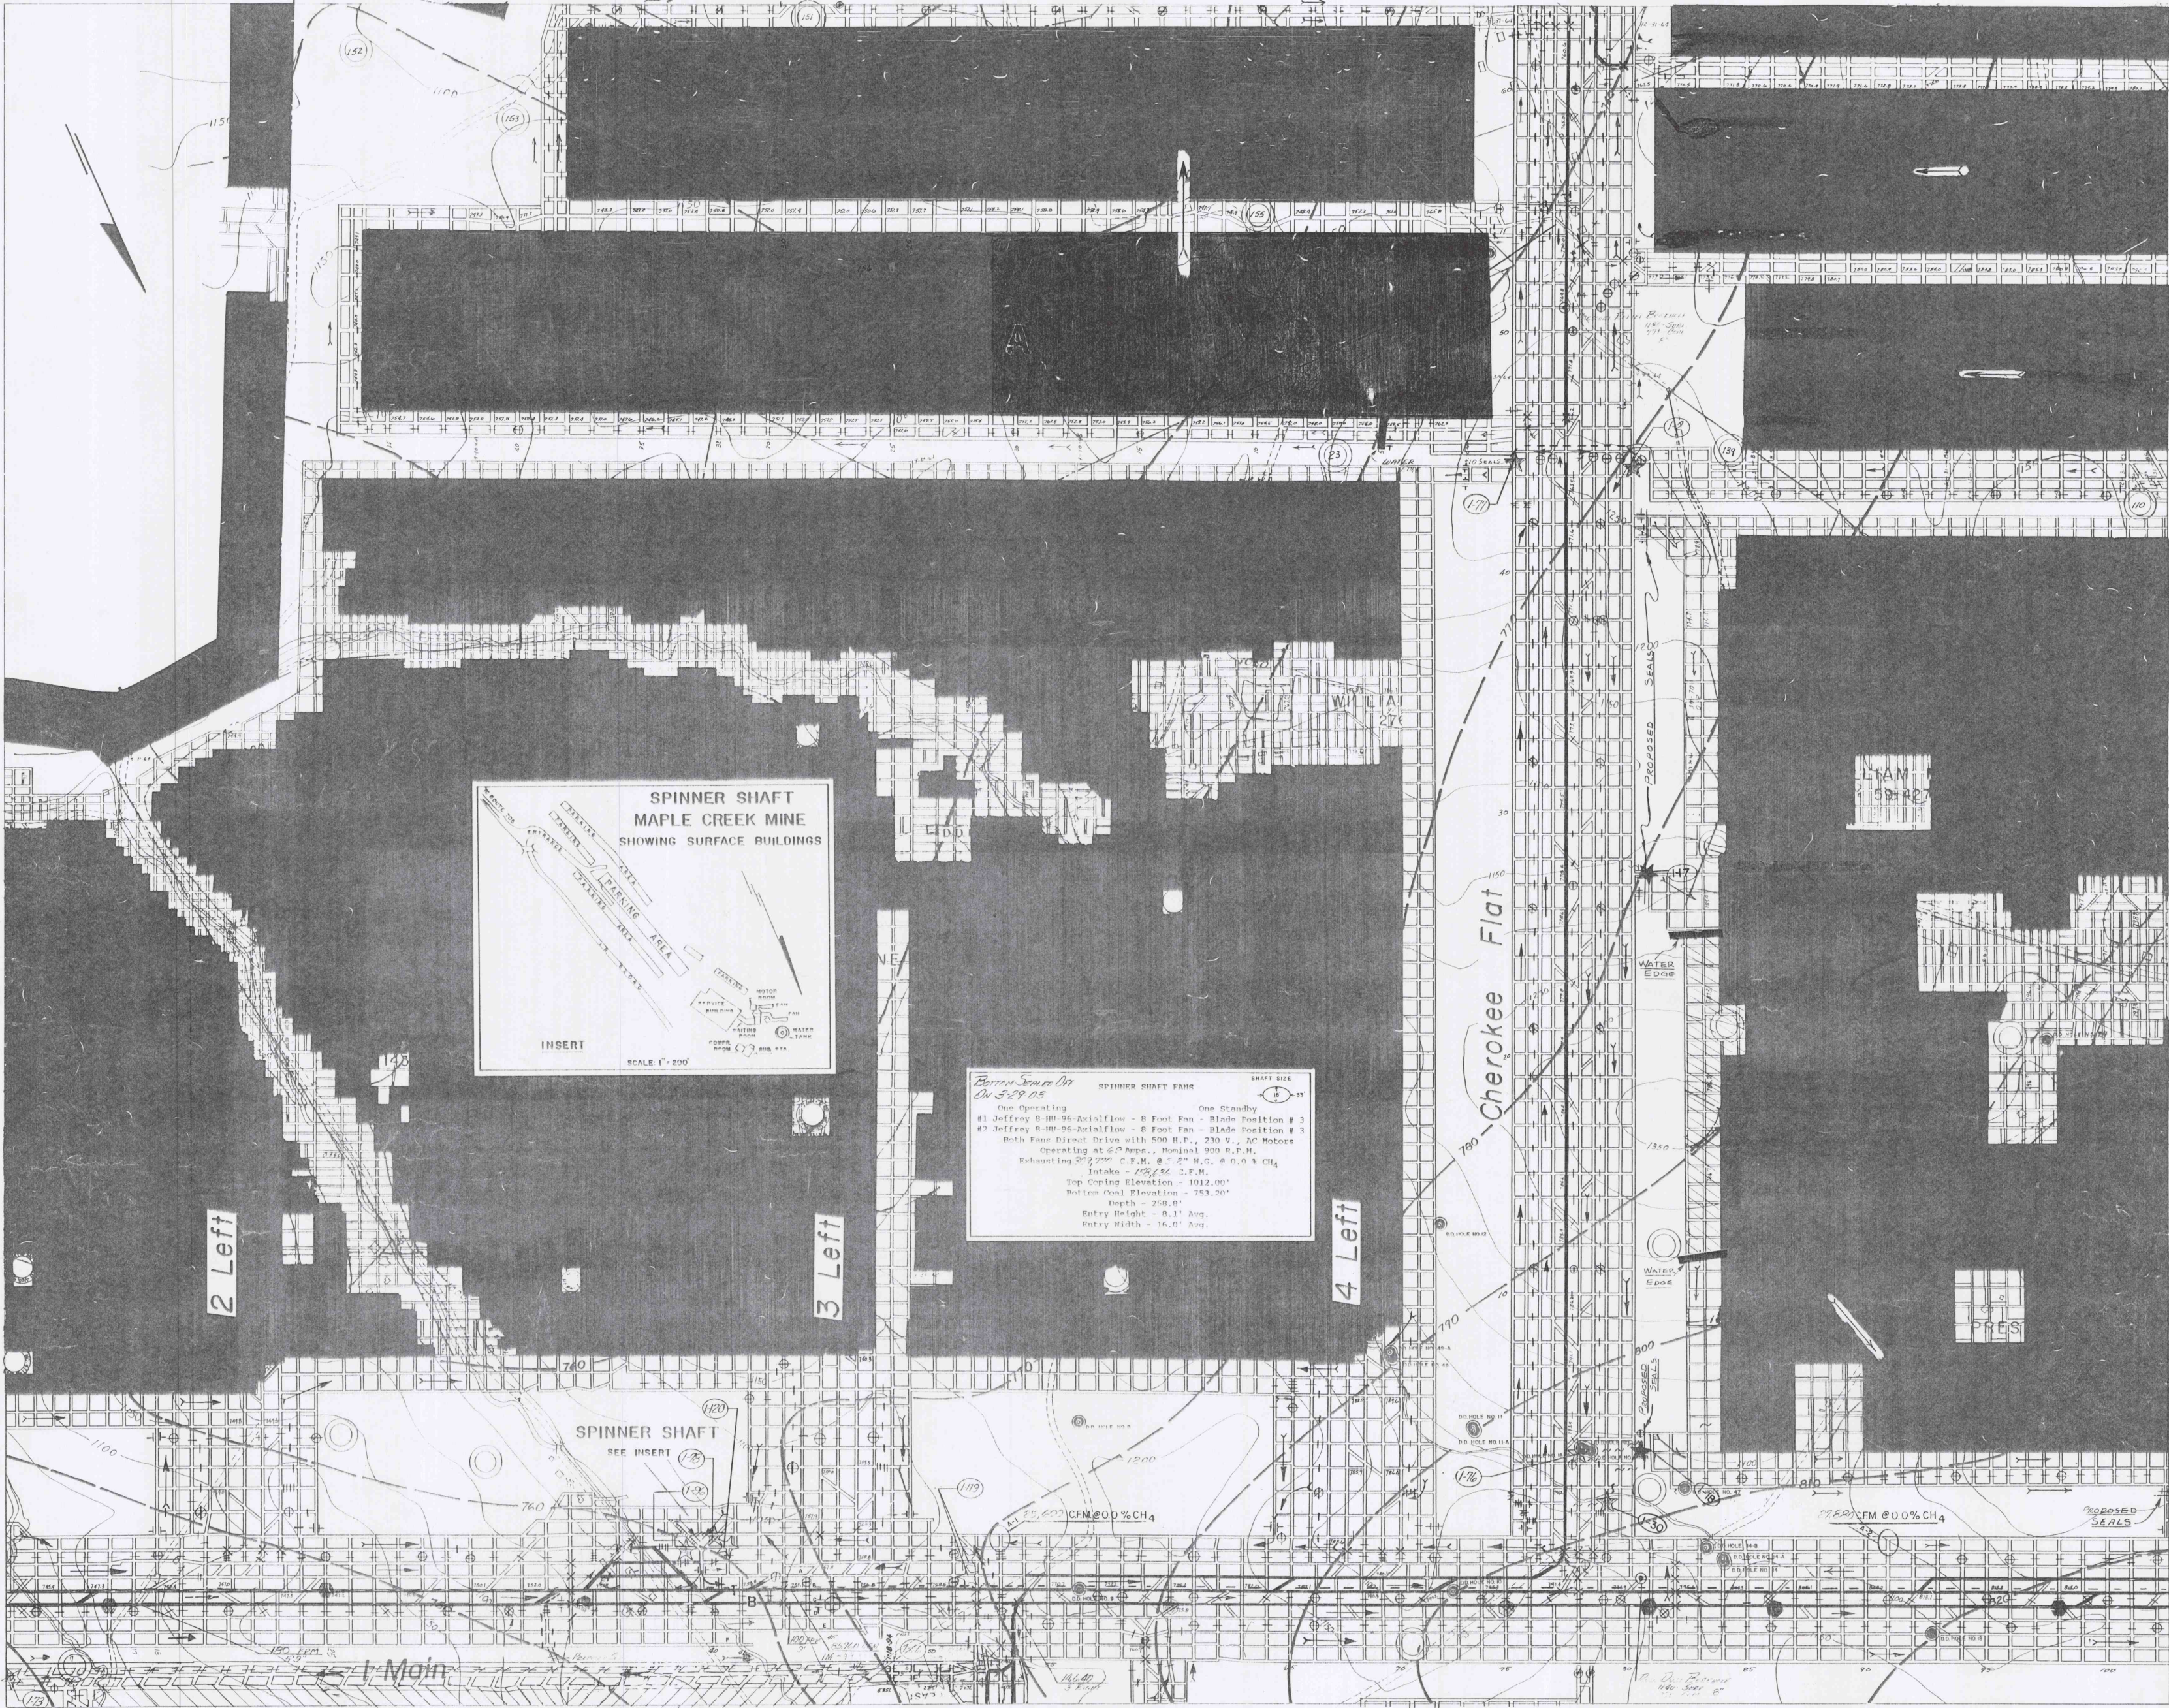

**SPINNER SHAFT FANS**

One Operating  
#1 Jeffrey 8-HU-96-Axisflow - 8 Foot Fan - Blade Position # 3  
#2 Jeffrey 8-HU-96-Axisflow - 8 Foot Fan - Blade Position # 3  
Both Fans Direct Drive with 500 H.P., 230 V., AC Motors  
Exhausting 573,770 C.F.M. @ 2" H.G., 0.0.0 % CH<sub>4</sub>  
Intake - 123,640 C.F.M.  
Top Coping Elevation - 1012.00'  
Bottom Coal Elevation - 753.20'  
Depth - 258.80'  
Entry Height - 9.1' Avg.  
Entry Width - 16.0' Avg.

One Standby  

**SPINNER SHAFT**  
SEE INSERT

**1 Main**