


FIT TO B

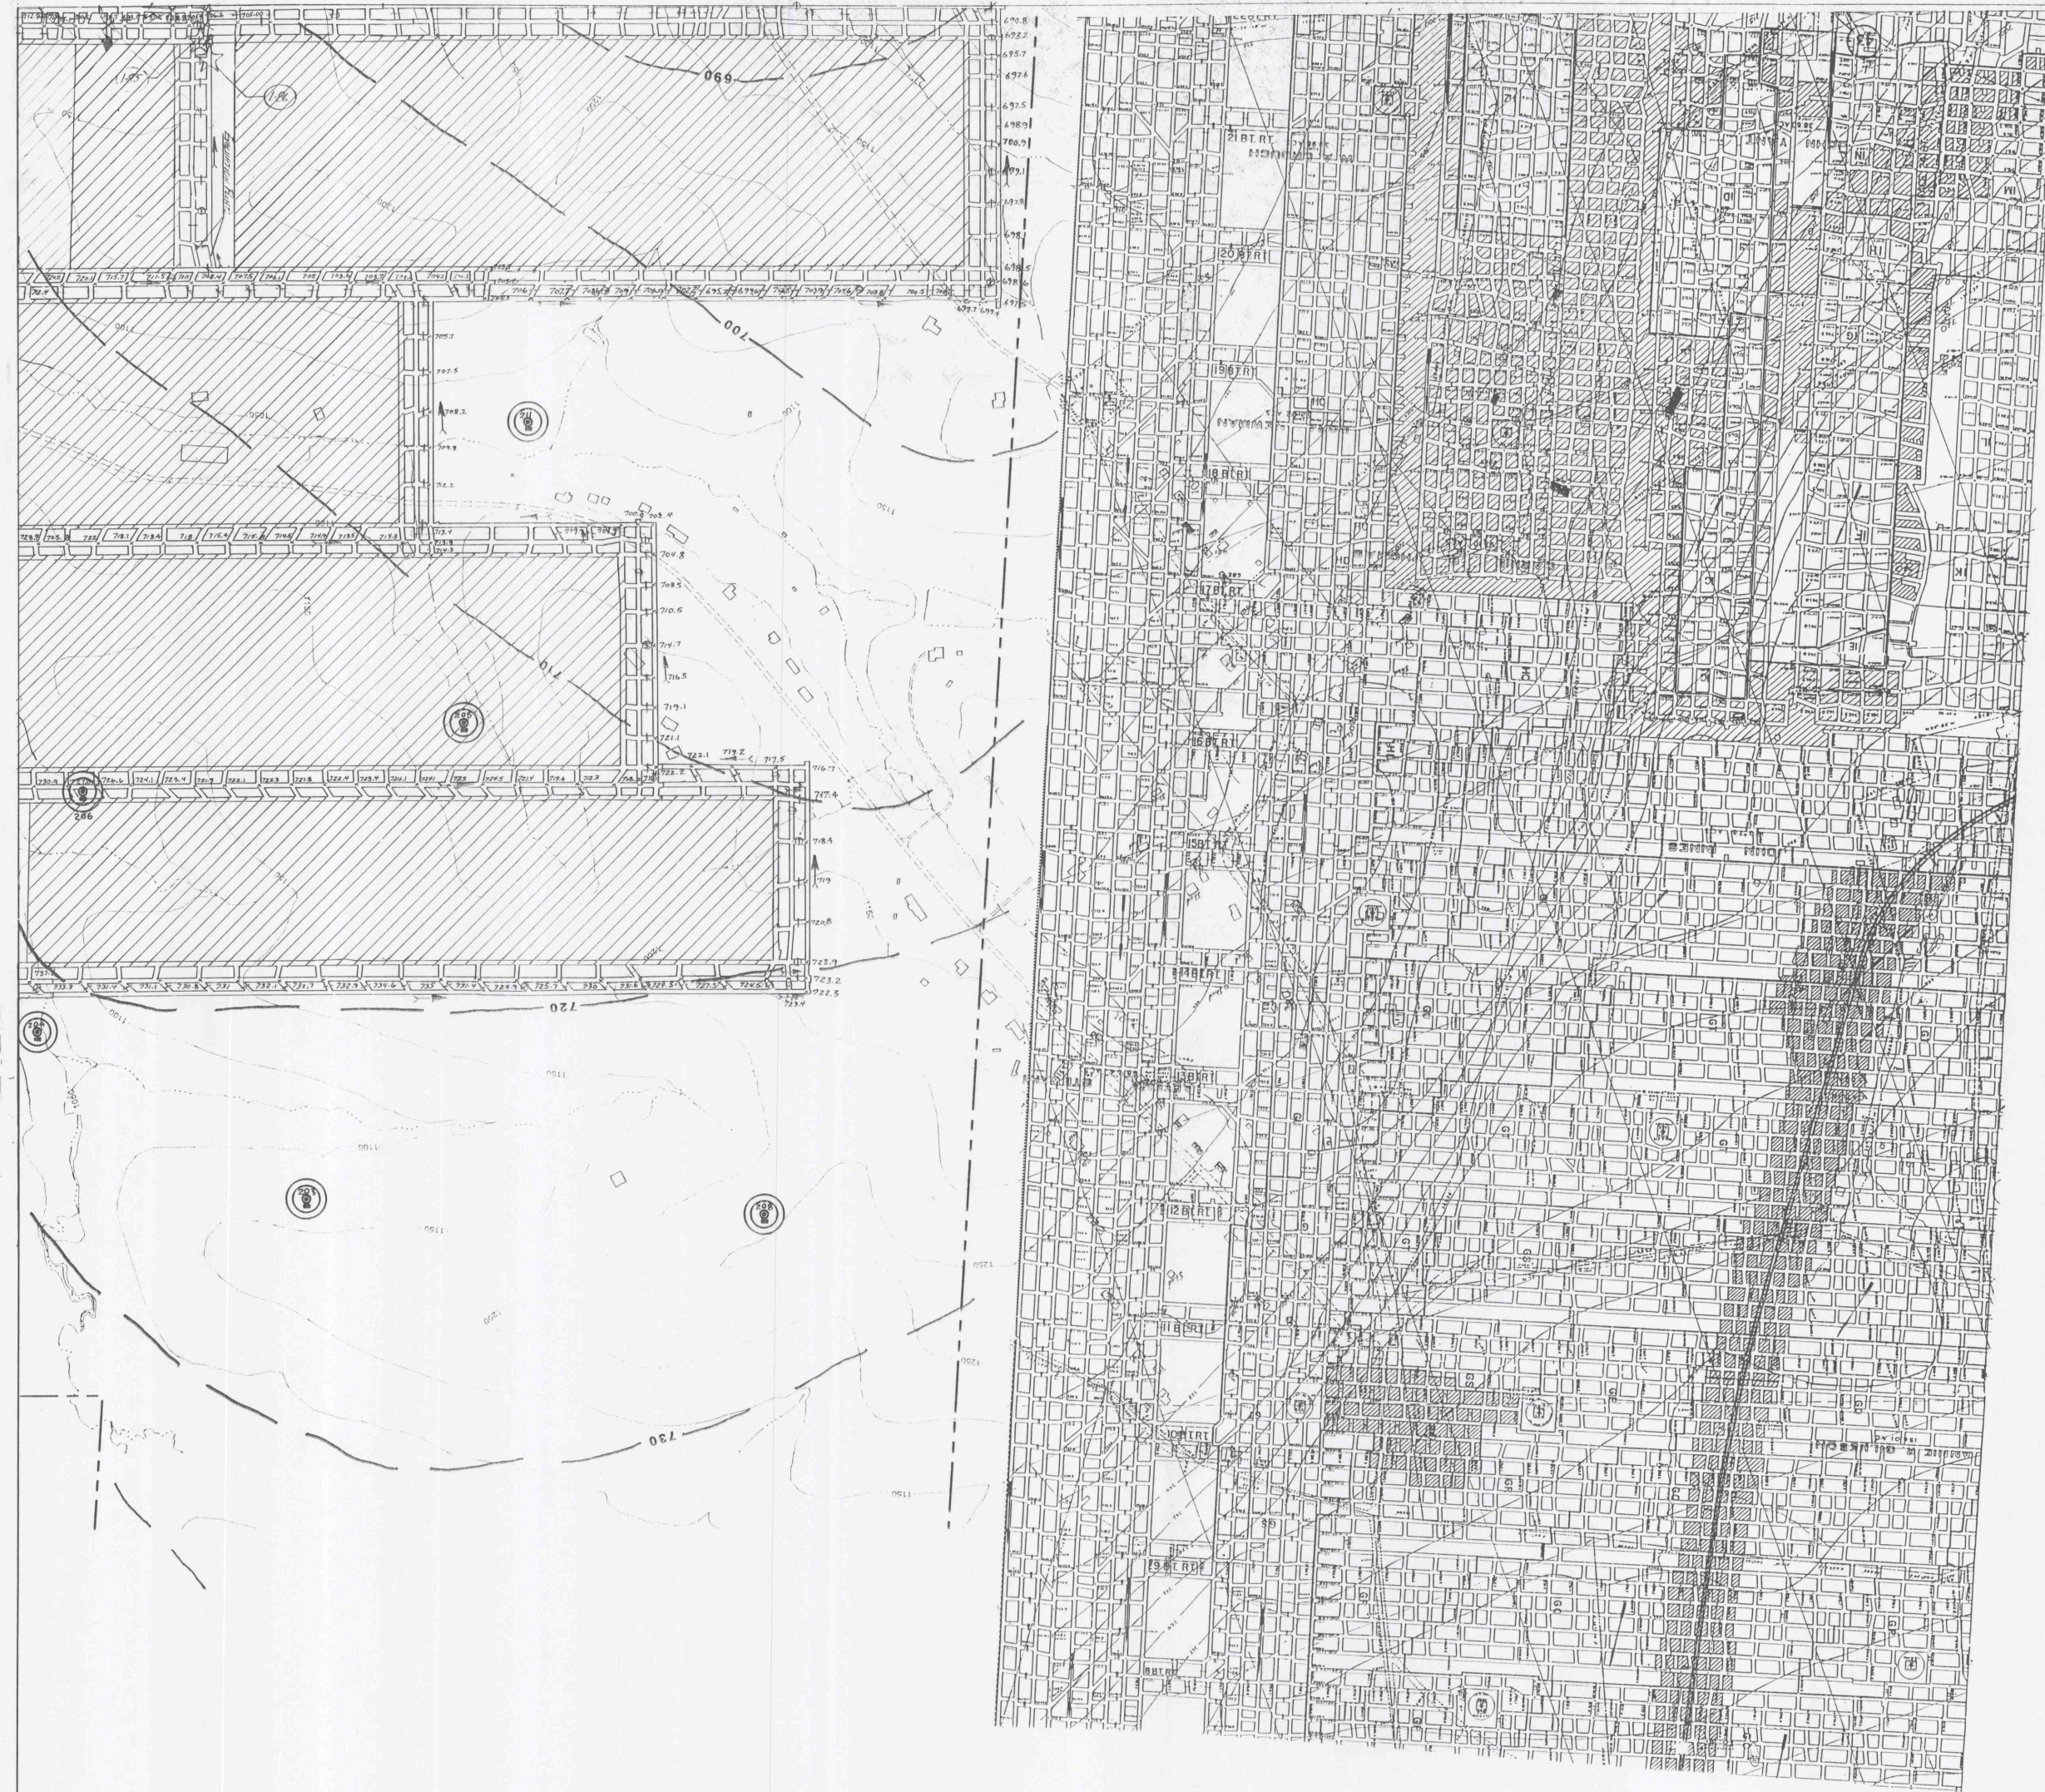

FIT TO

A