


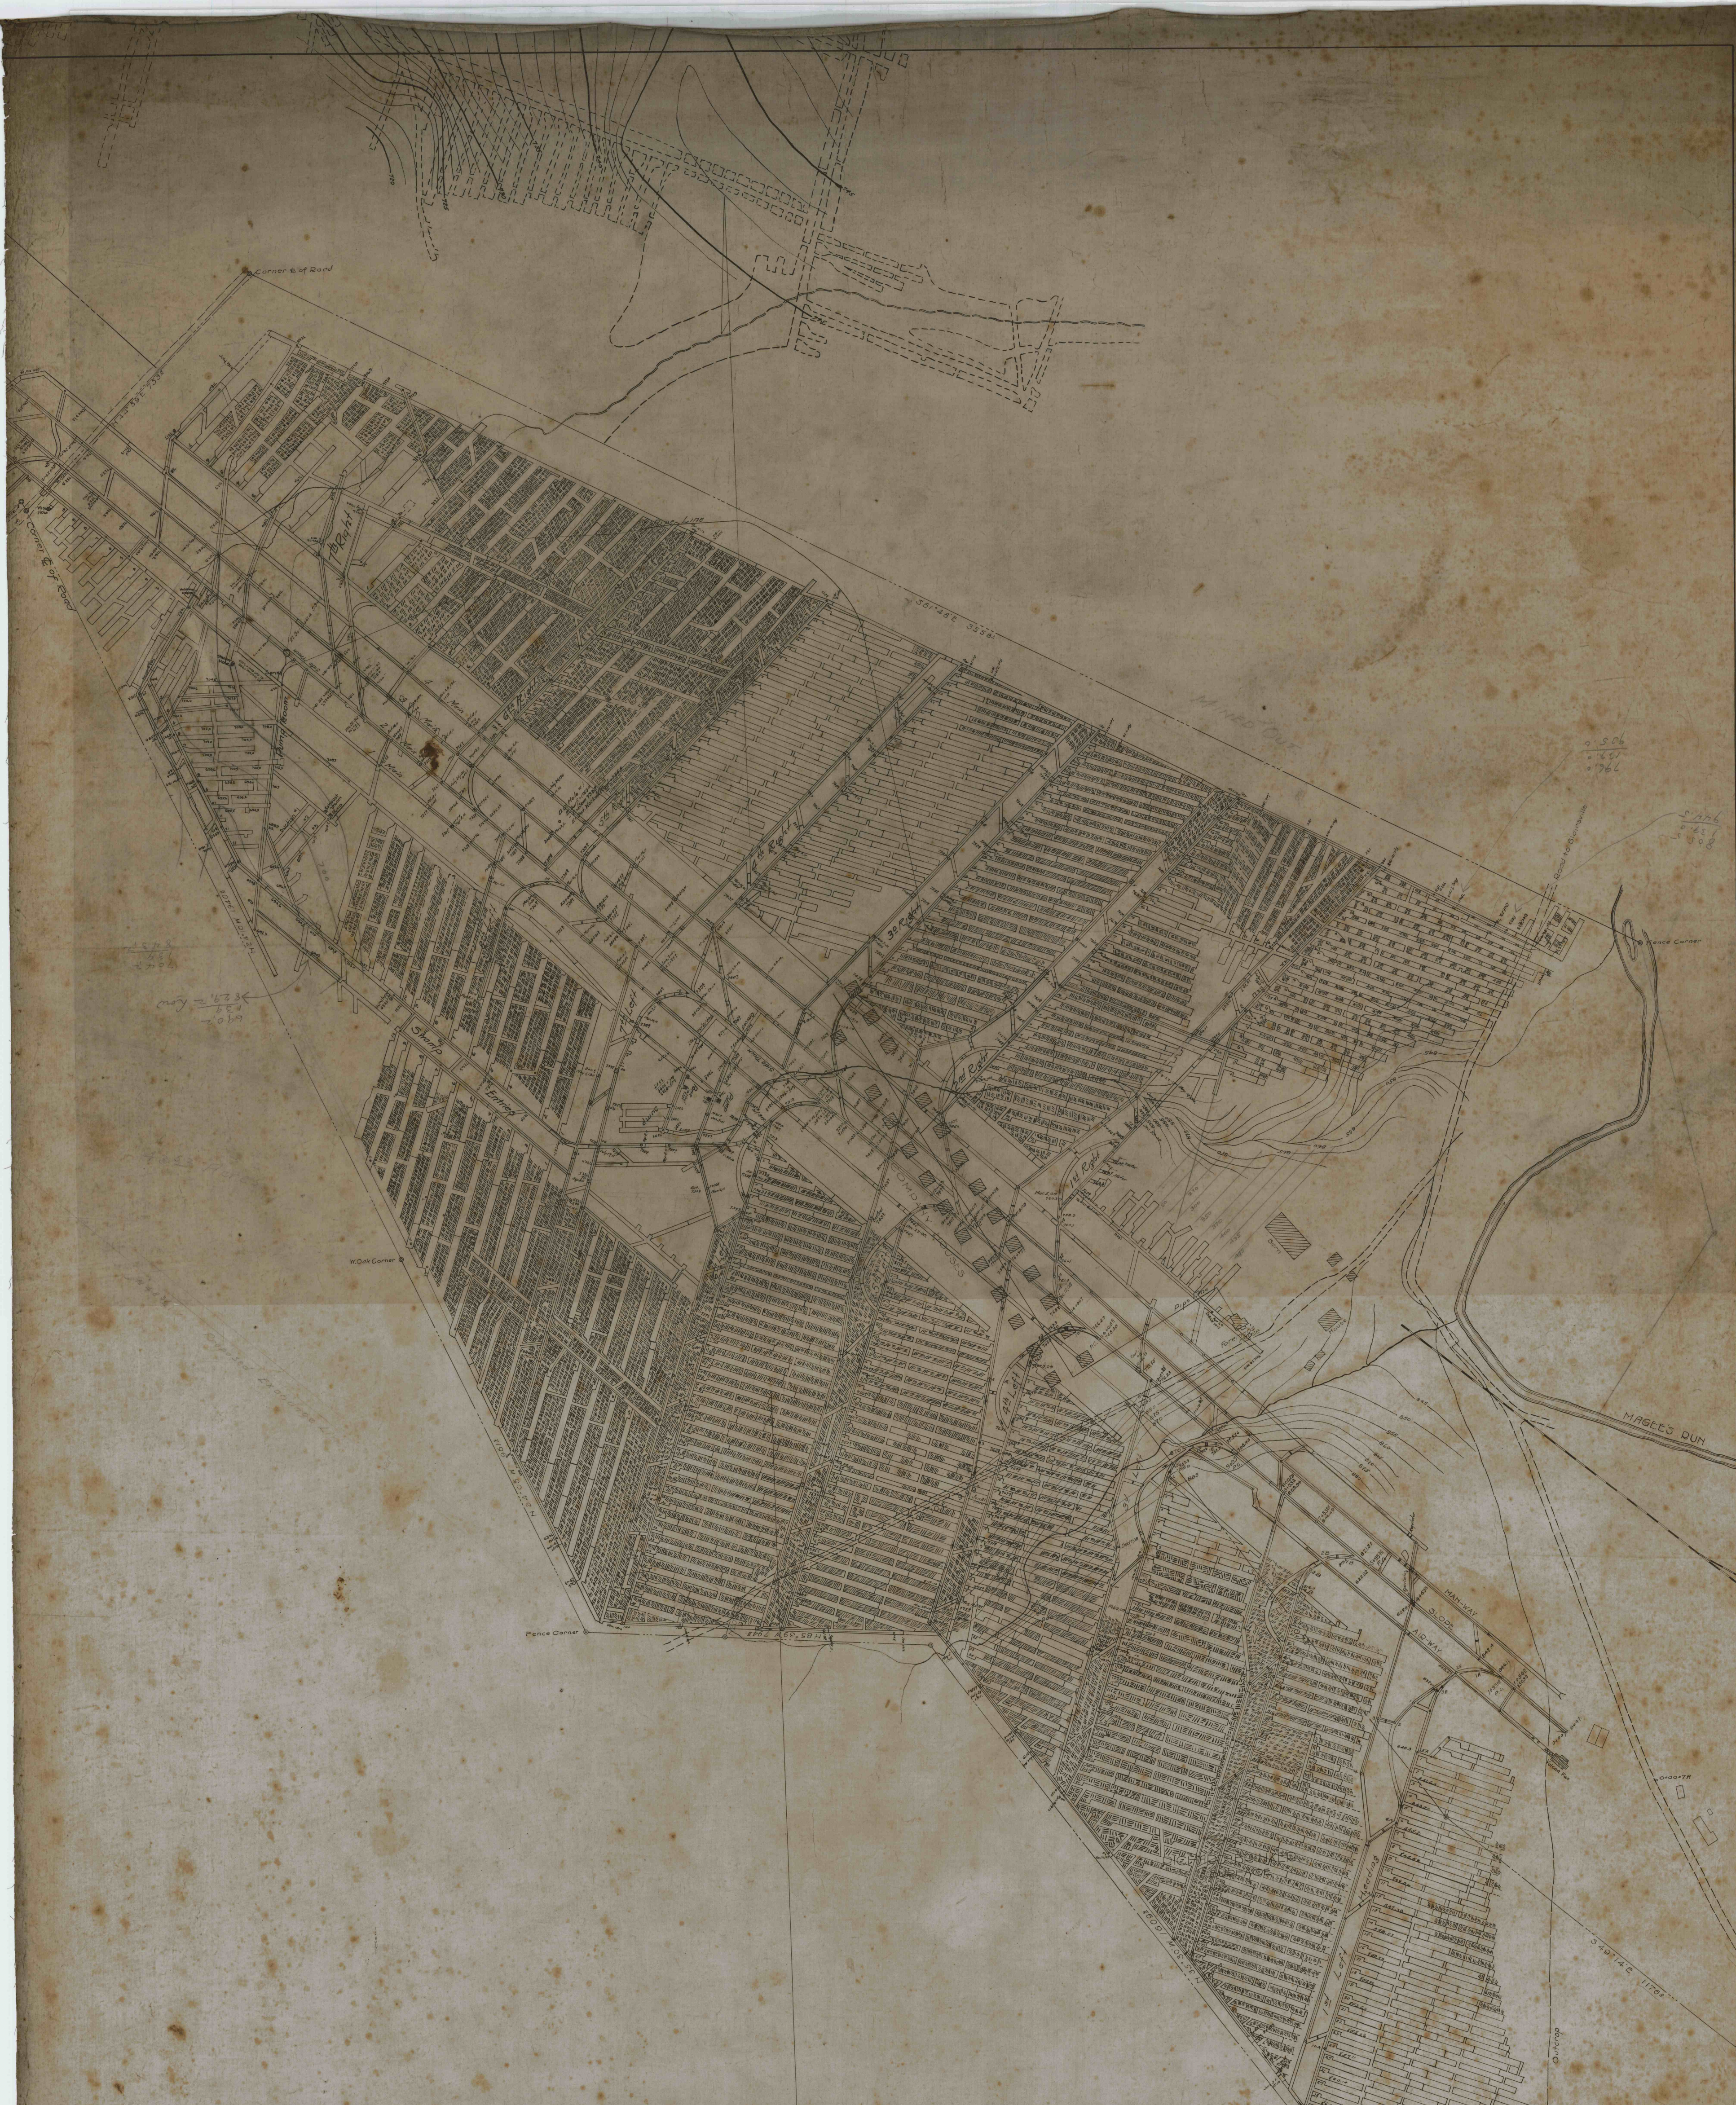

MAP OF
LATROBE COAL CO.
COLLIERY NO. 2

NEAR HILLSIDE, WESTMORELAND CO., PA.

SCALE : 1" = 100'

Sanfellyman & Co.
CIVIL & MINING ENGRS.