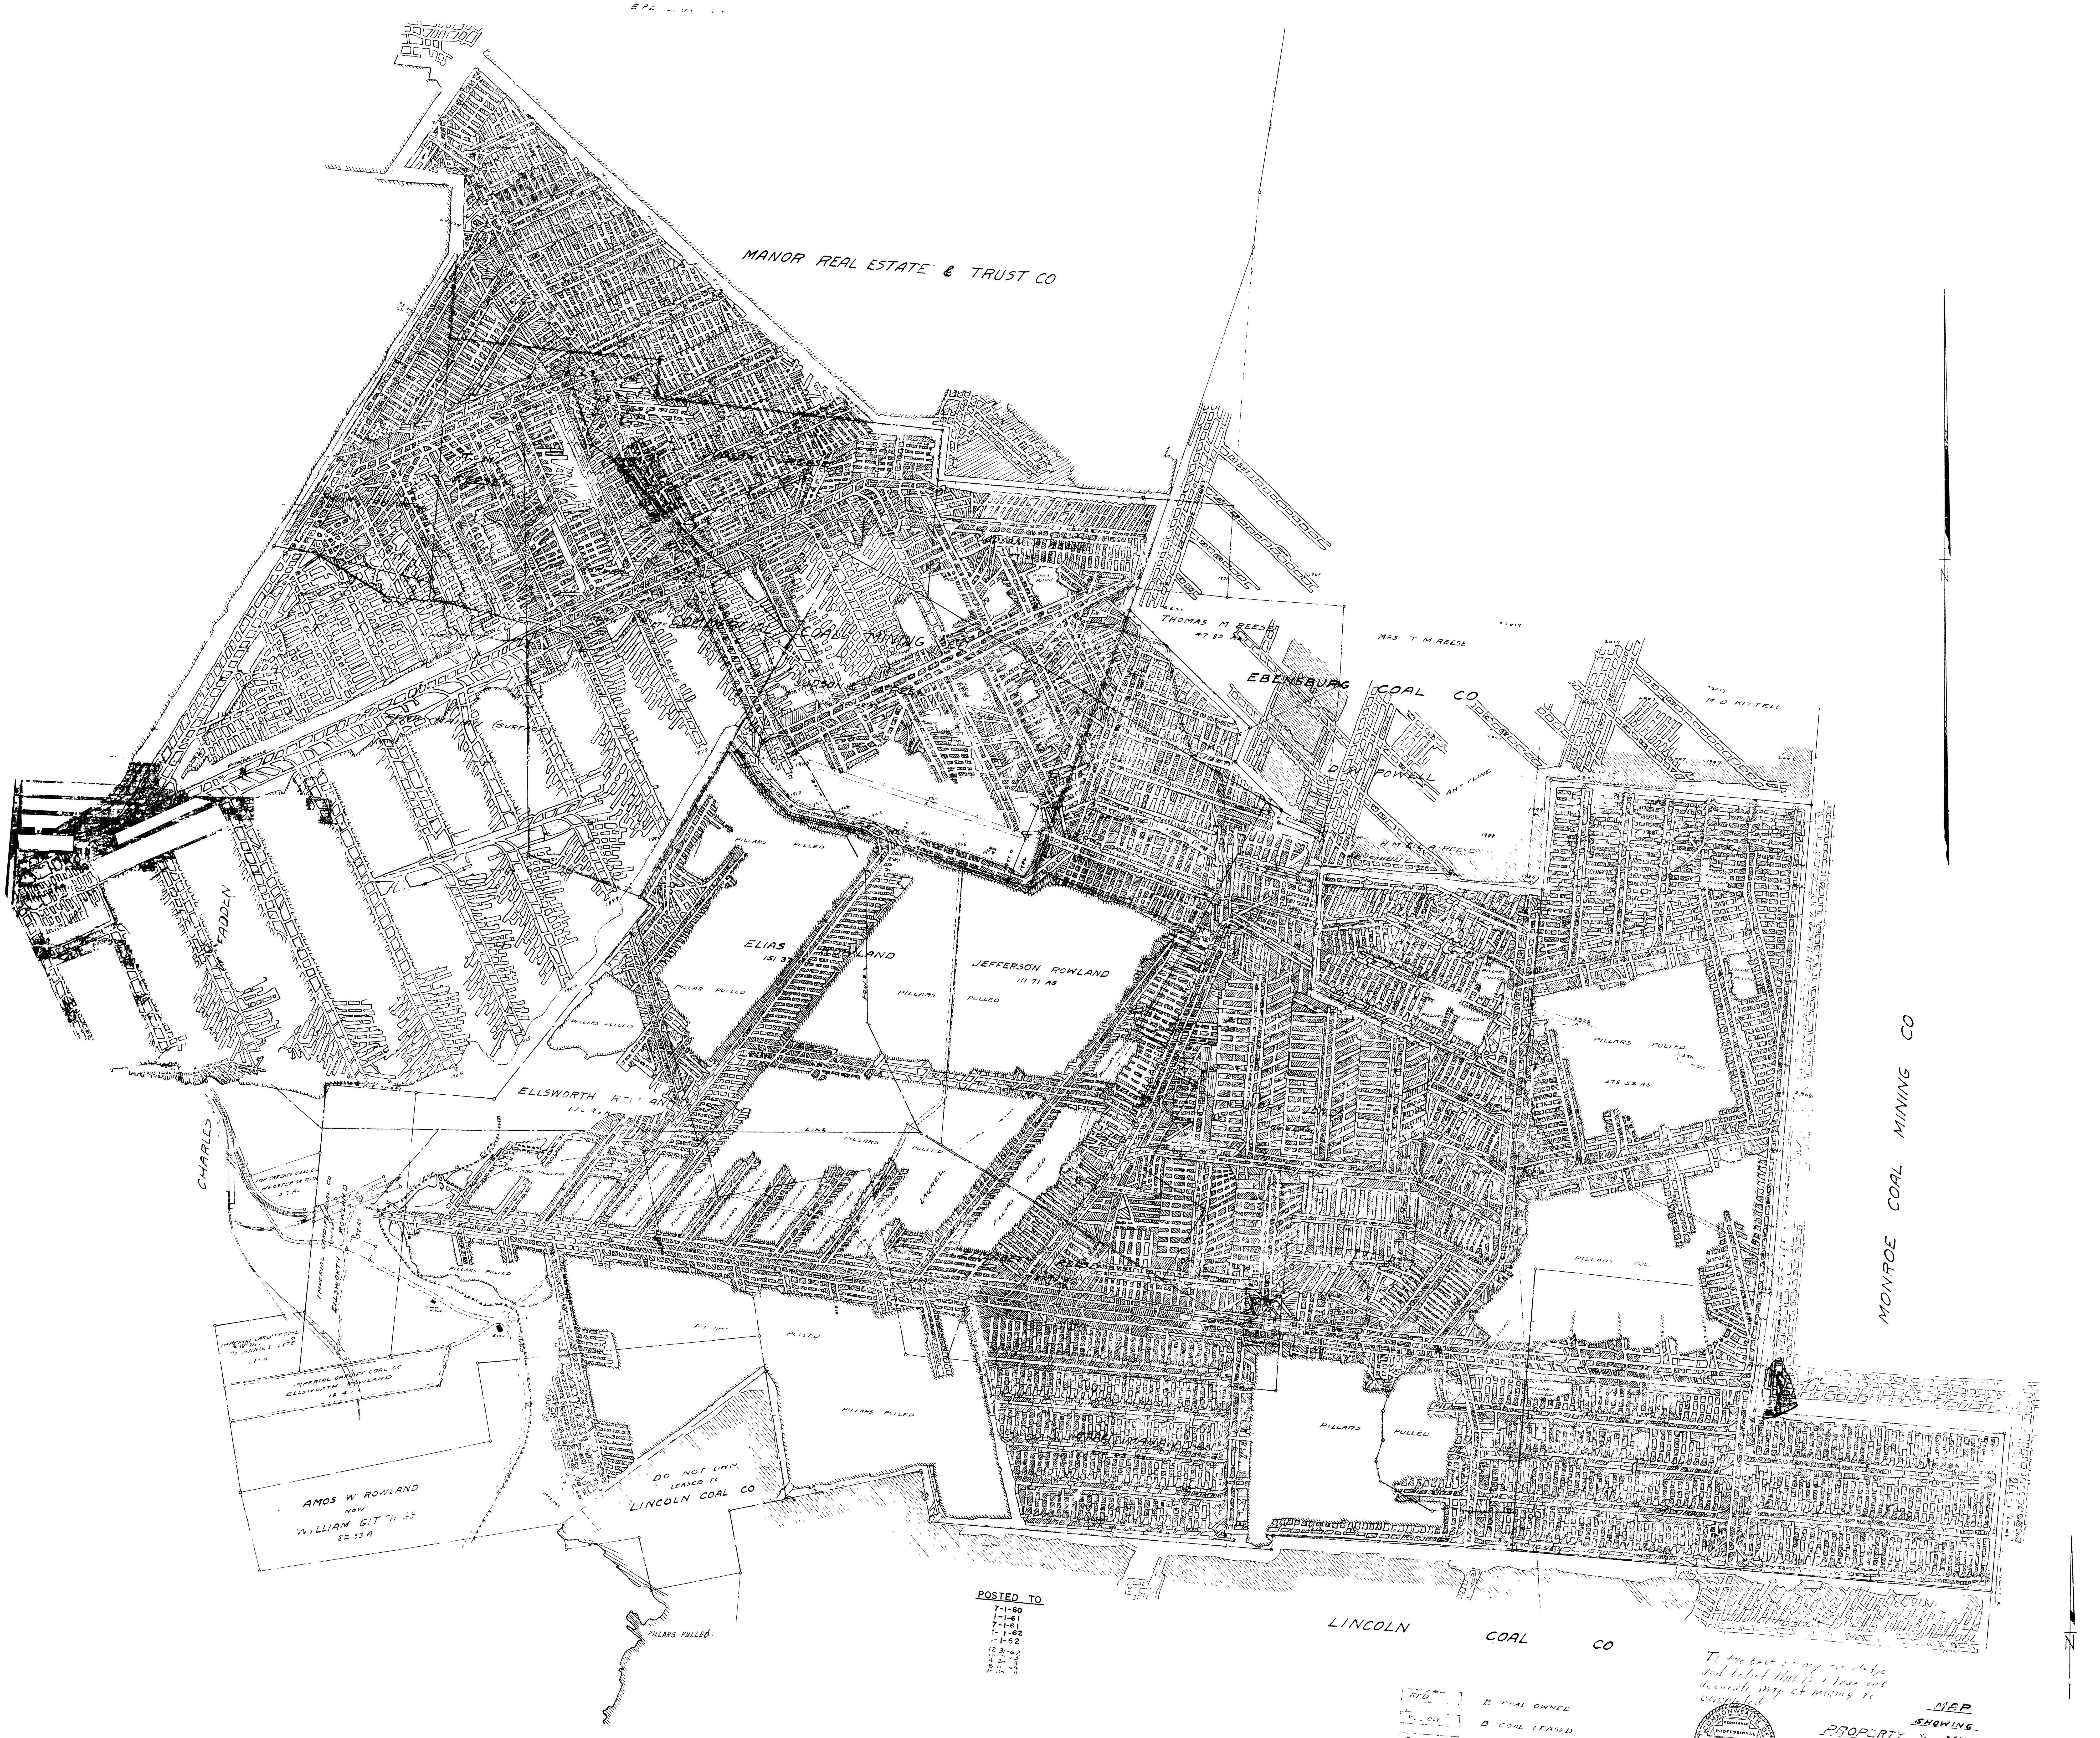

POSTED TO

7-1-60
1-1-61
7-1-61
1-1-62
7-1-62
12 31-62
10 63
4 20 64
8 11 64
10 30 64

RED	B COAL OWNED
YELLOW	B COAL LEASED
GREEN	SURFACE OWNED

To the best of my knowledge and belief this is a true and accurate map of mining as completed

JOHN G EMERICK
No 7679 E

MAP
SHOWING
PROPERTY AND MINING OPERATIONS
OF THE
IMPERIAL CARDIFF COAL CO

SITUATE IN
BLACKLICK & CAMBRIA TWPS
CAMBRIA CO PA
AUG 7 1930
SCALE-1"=400'