


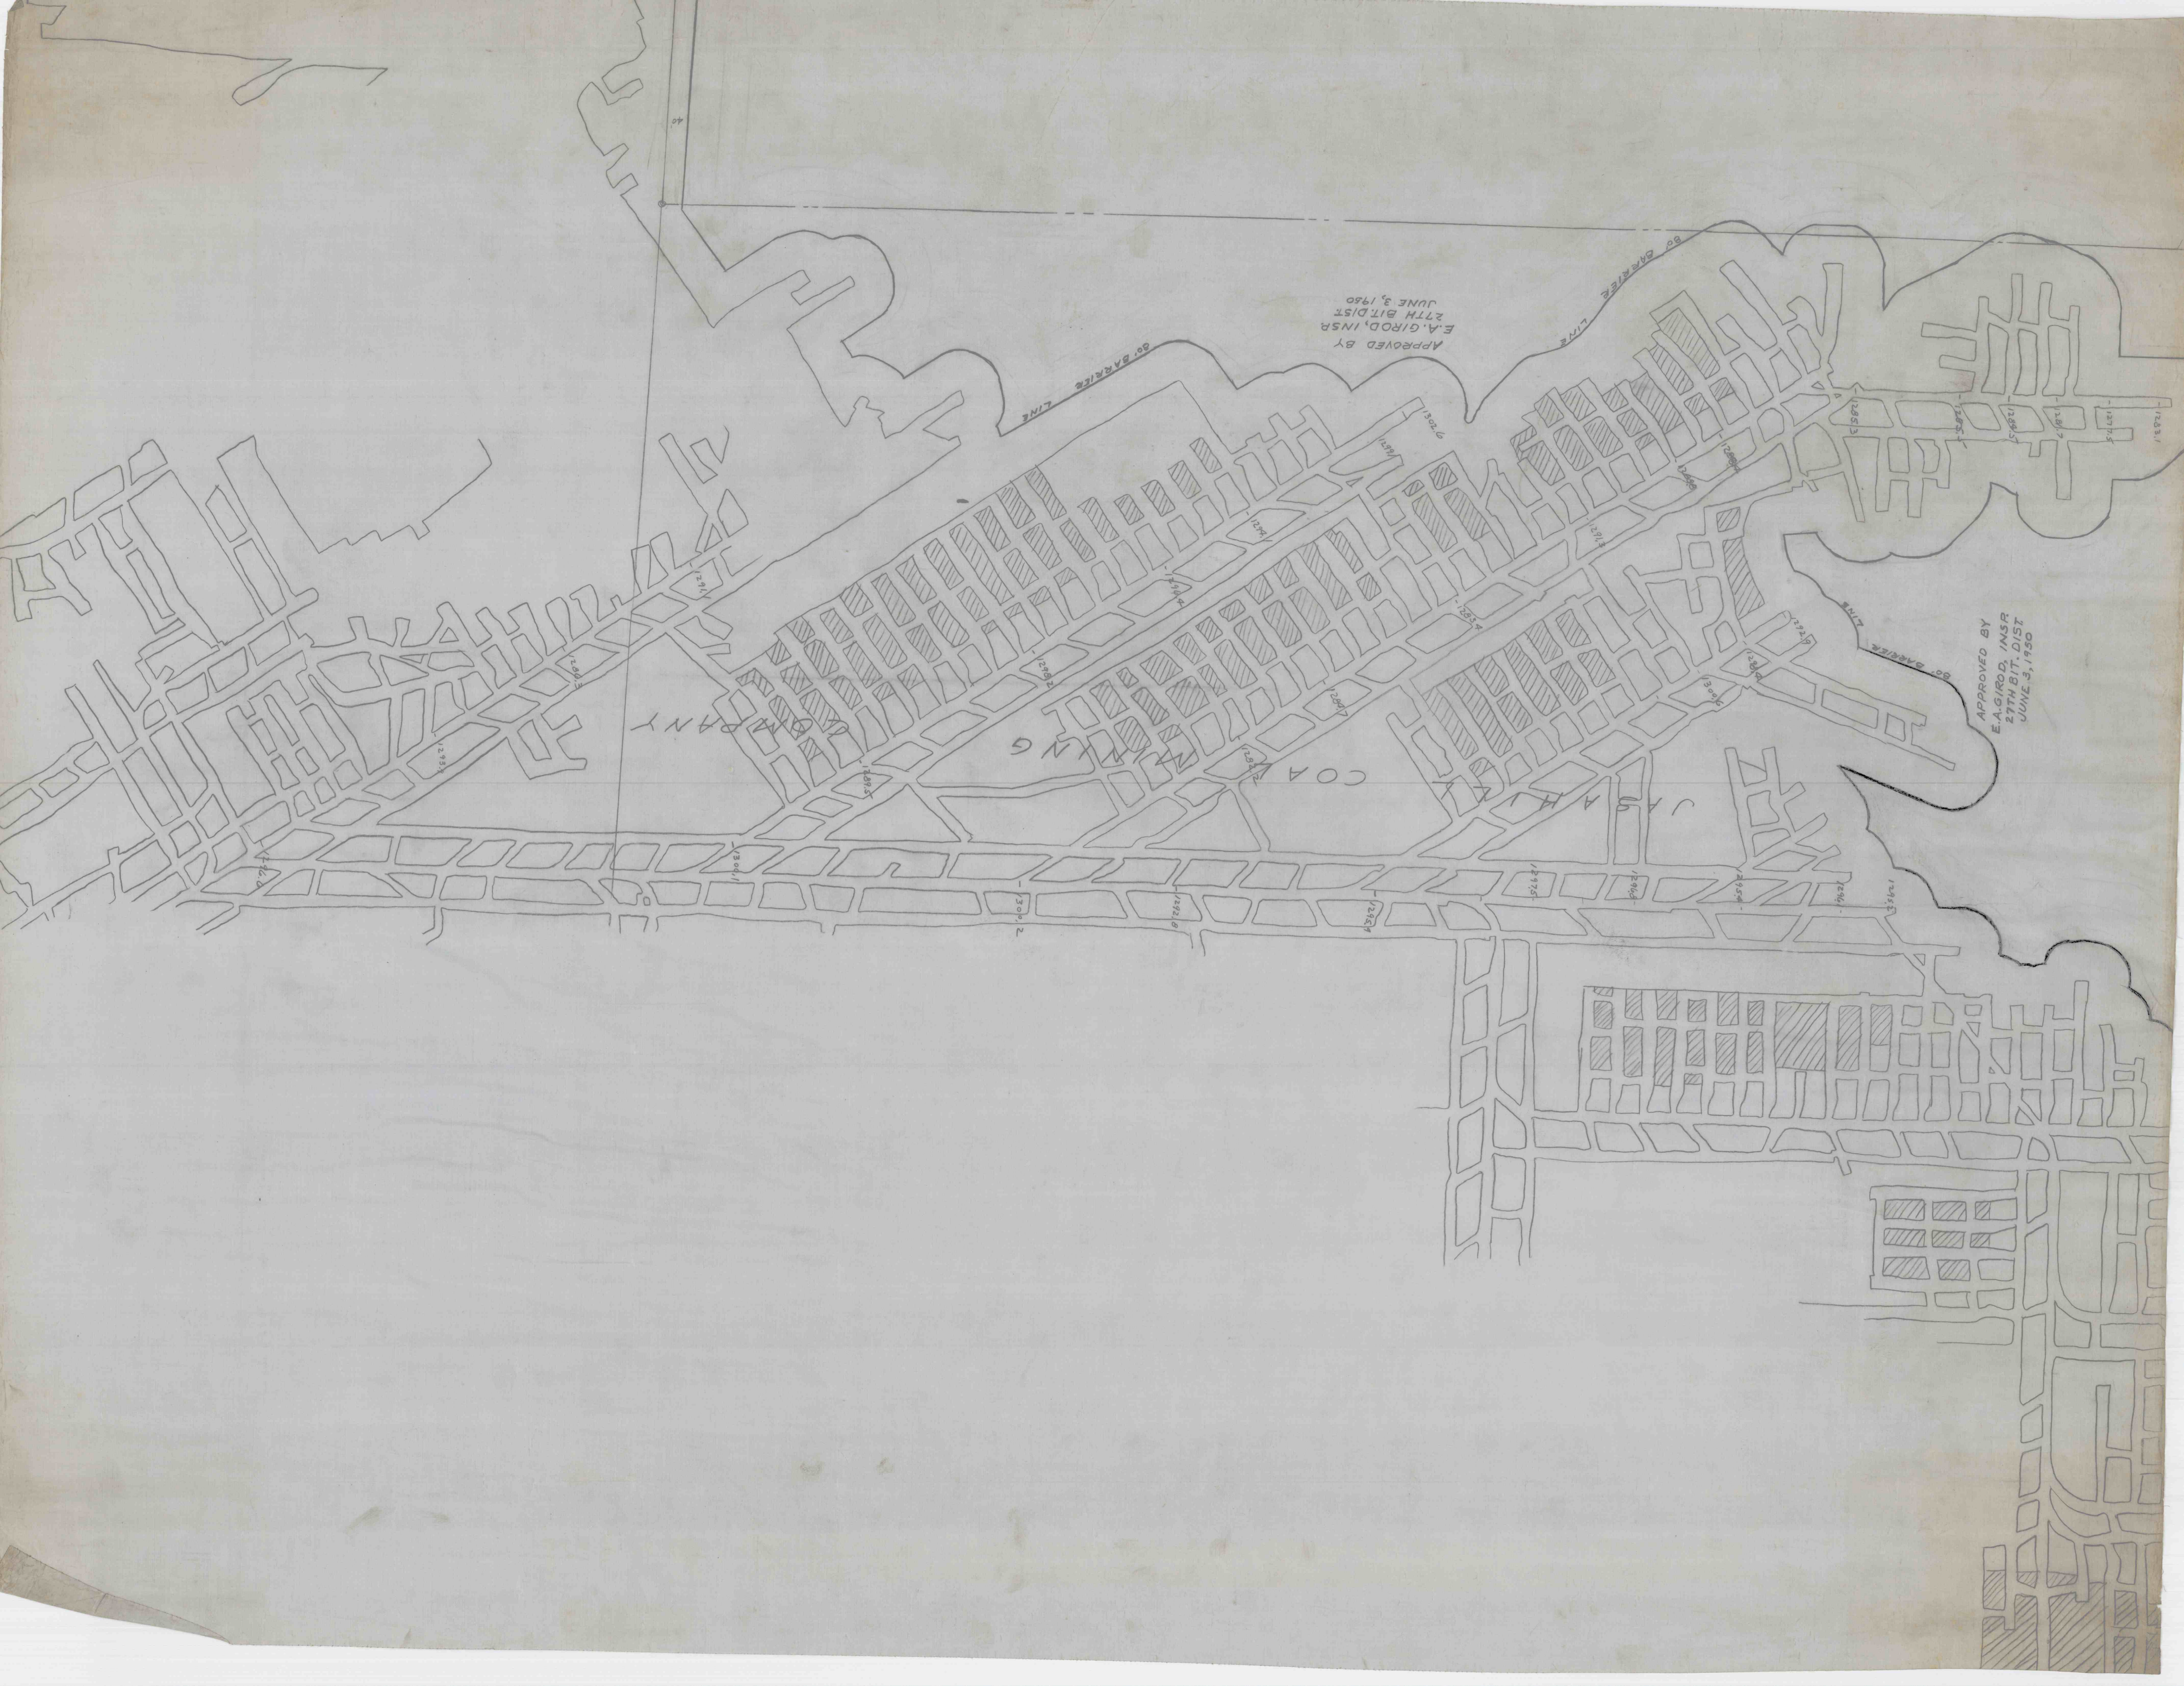

APPROVED BY
27TH DIST.
JUNE 3, 1950

APPROVED BY
27TH DIST.
JUNE 3, 1950