


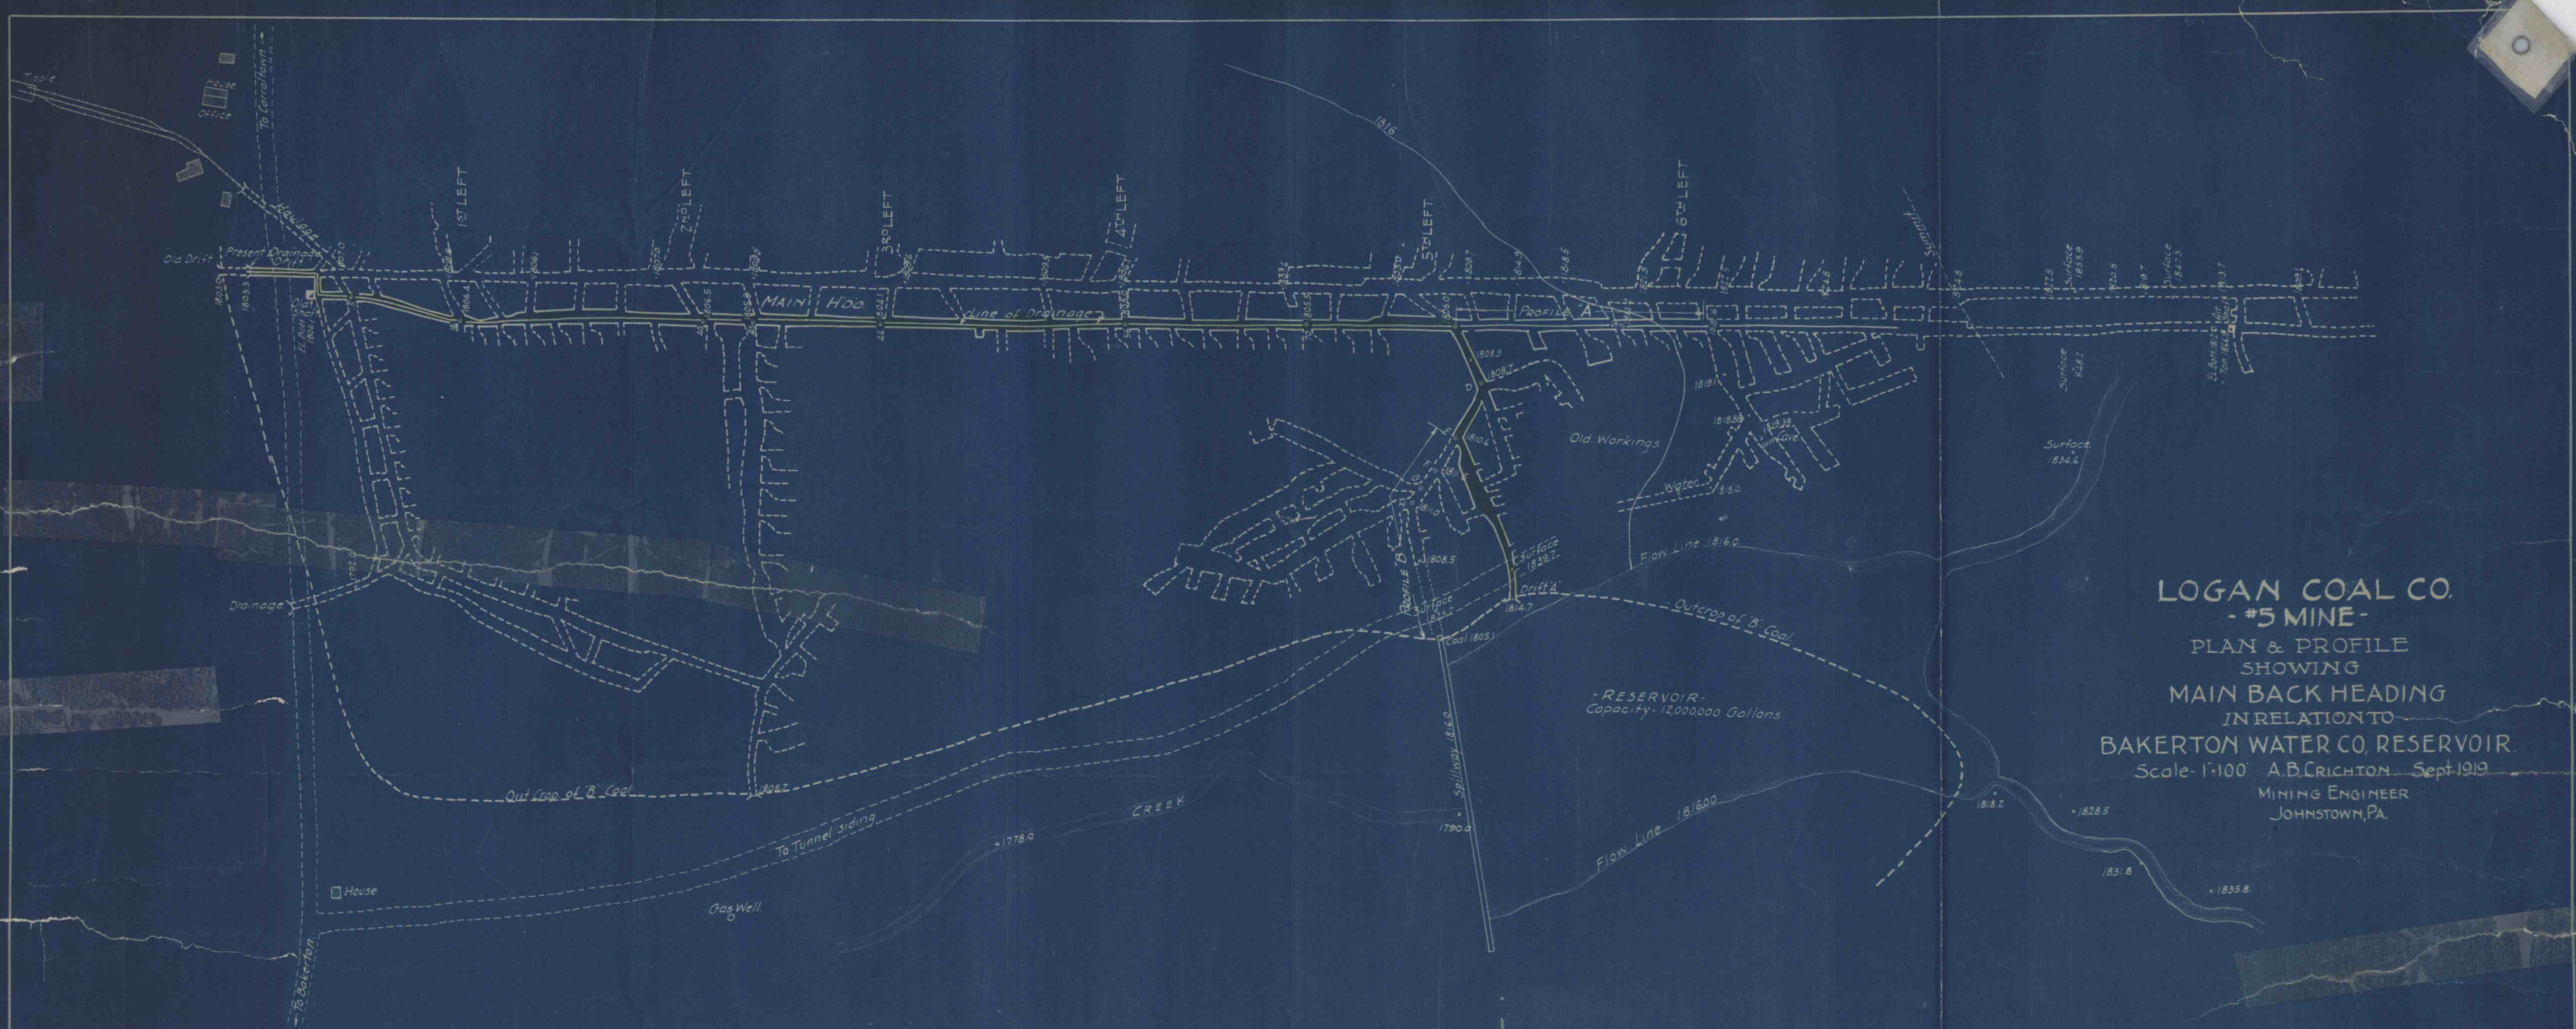

LOGAN COAL CO.
- #5 MINE -
 PLAN & PROFILE
 SHOWING
MAIN BACK HEADING
 IN RELATION TO
BAKERTON WATER CO. RESERVOIR.
 Scale 1"=100' A.B. CRICHTON Sept. 1919
 MINING ENGINEER
 JOHNSTOWN, PA.

