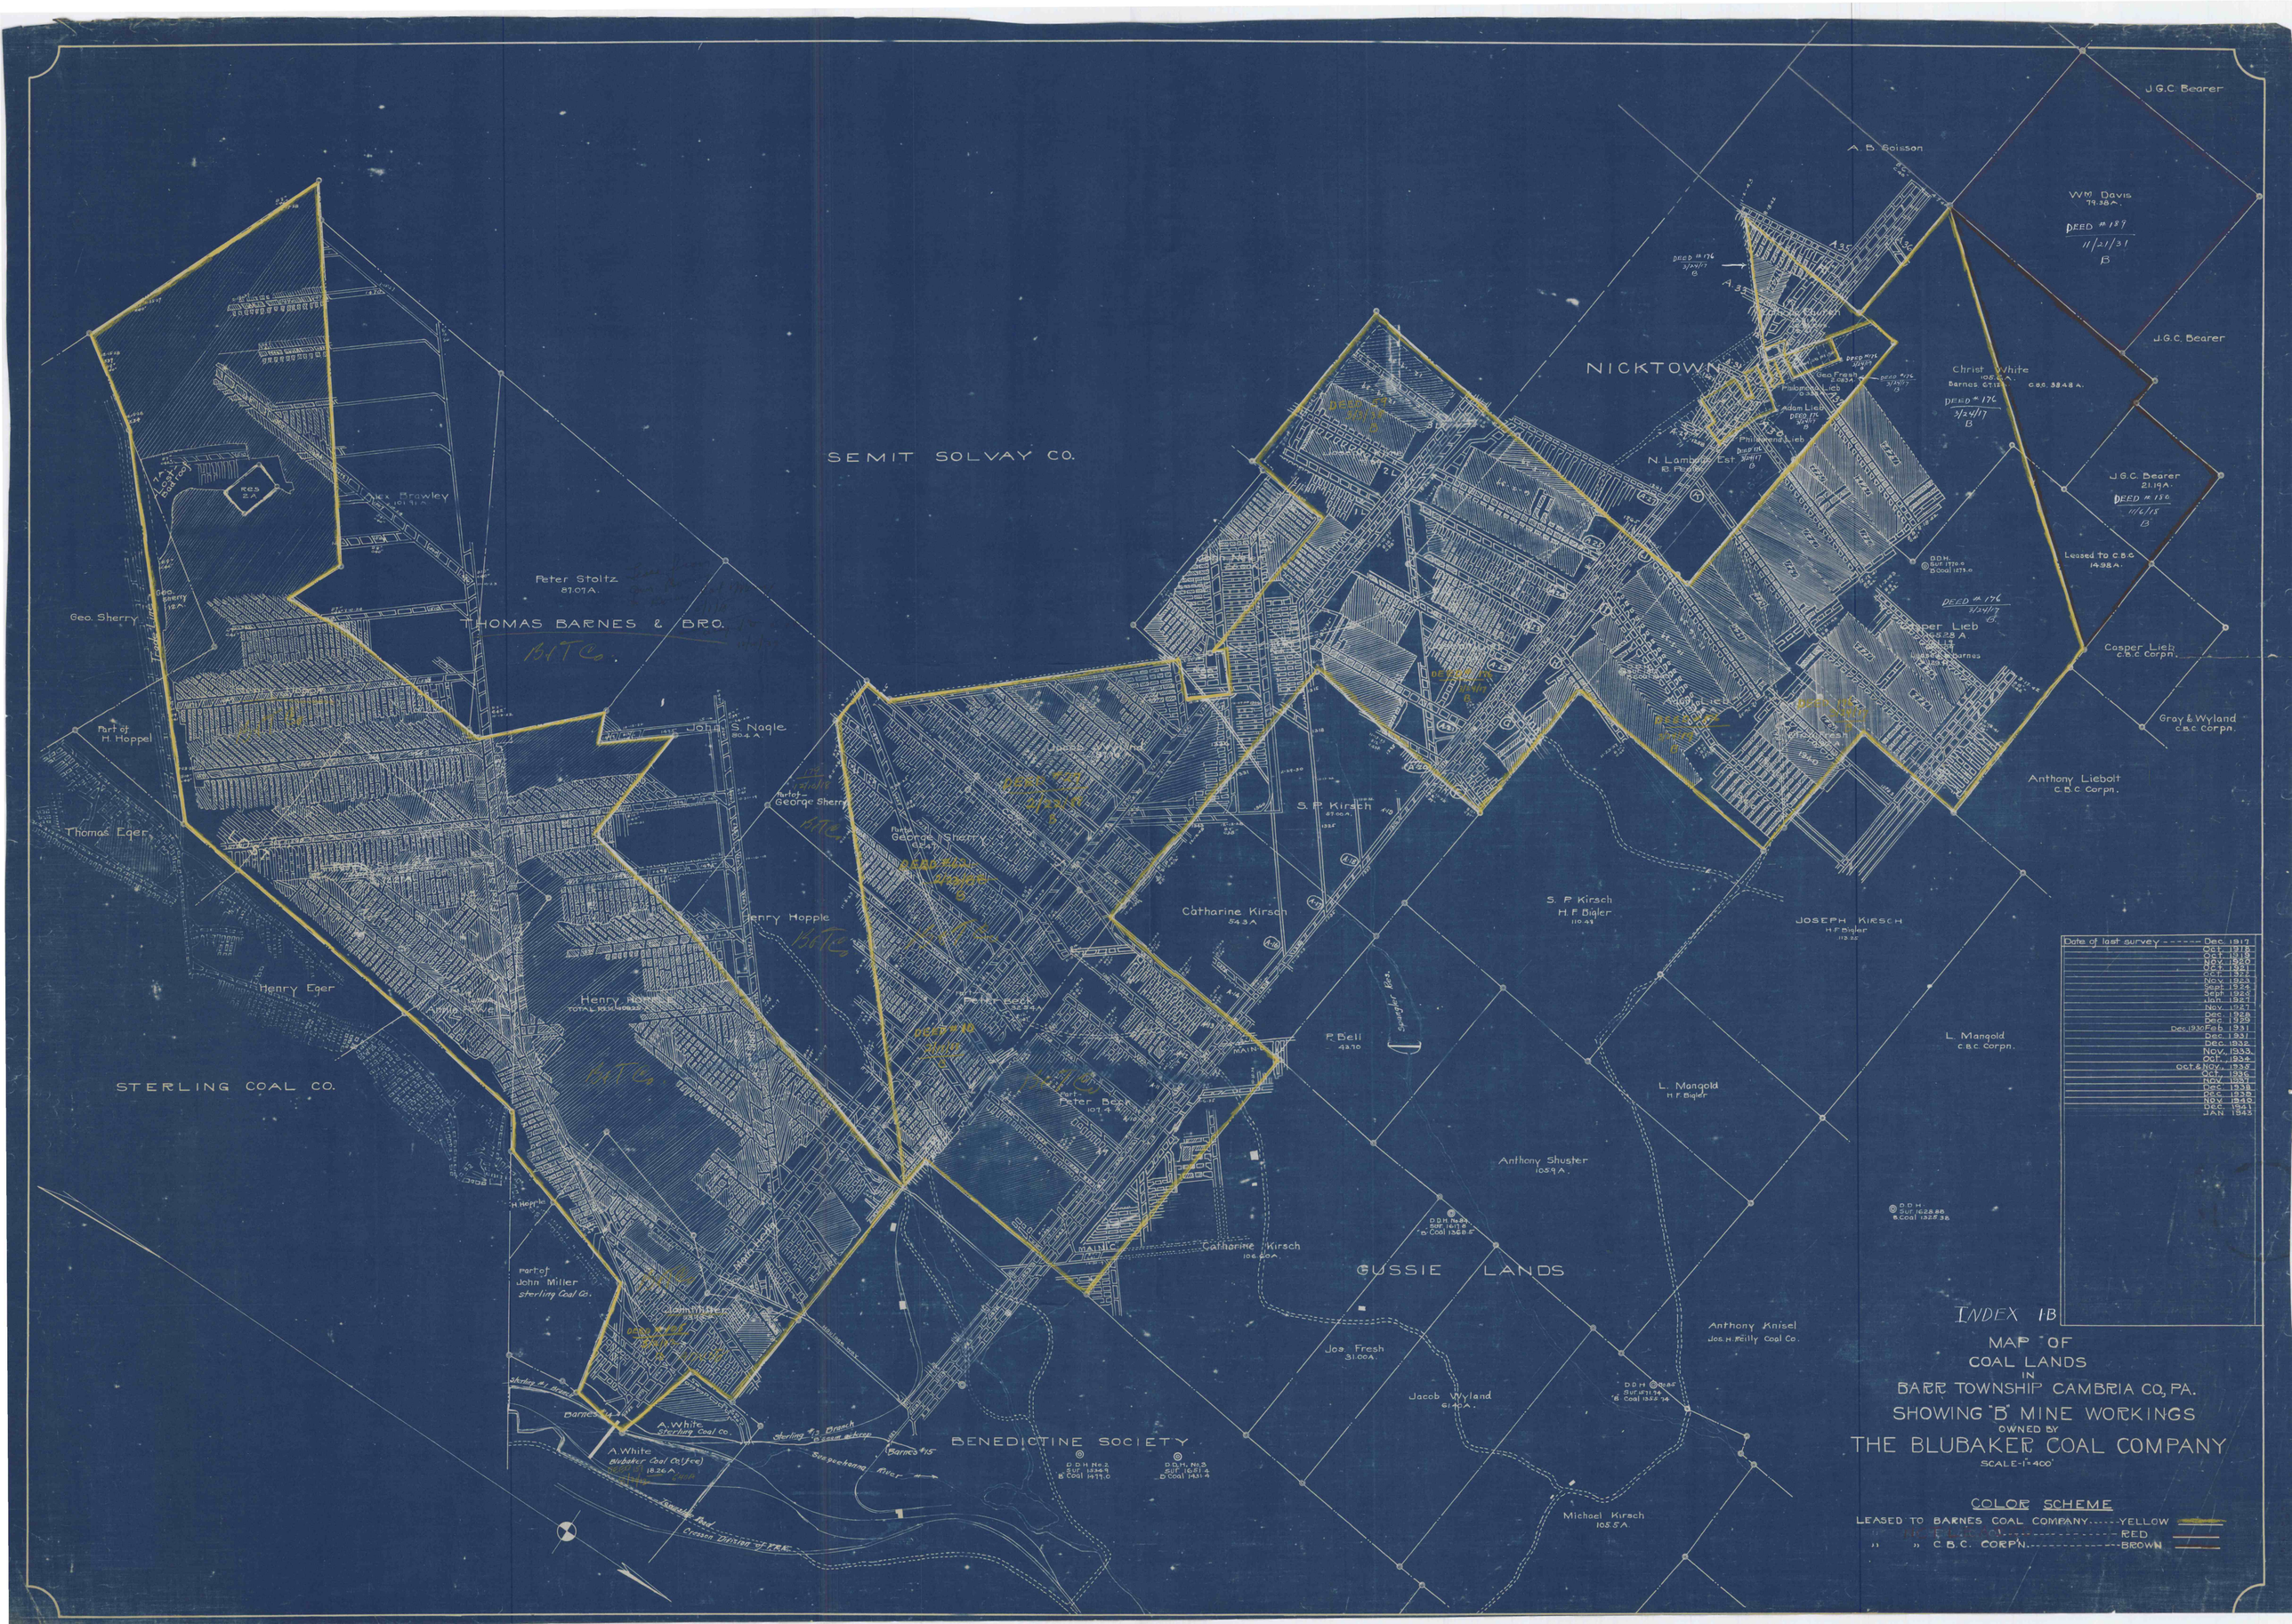
SEMIT SOLVAY CO.
STERLING COAL CO.
THOMAS BARNES & BRO.
NICKTOWN
GUSSIE LANDS
BENEDICTINE SOCIETY
Susquehanna River
Peter Stoltz 87.07A.
Geo. Sherry
Part of H. Hoppel
Thomas Eger
Henry Eger
Henry Hopple
John S. Nagle 80.4 A.
Part of George Sherry
Part of George J. Sherry
Catharine Kirsch 54.3 A
S. P. Kirsch 87.00 A.
Part of Peter Beck 107.4 A.
F. Bell 42.70
Catharine Kirsch 106.60A.
Part of John Miller Sterling Coal Co.
A. White Sterling Coal Co.
A. White Blubaker Coal Co. (Lease) 18.26 A.
Barnes #15
Sterling #1 Branch
Crossen Division of P.R.R.
D.D.H. No. 2 Sur. 1324.9 & Coal 1411.0
D.D.H. No. 3 Sur. 1601.4 & Coal 1431.4
D.D.H. No. 4 Sur. 1418.8 & Coal 1368.8
D.D.H. Sur. 1622.86 & Coal 1322.38
D.D.H. Sur. 1731.54 & Coal 1322.74
S. P. Kirsch H. F. Bigler 110.49
JOSEPH KIRSCH H. F. Bigler 113.22
L. Mangold H. F. Bigler
L. Mangold C.B.C. Corpn.
Anthony Shuster 105.9 A.
Anthony Knisel Jos. H. Reilly Coal Co.
Jos. Fresh 31.00A.
Jacob Wyland 61.40A.
Michael Kirsch 105.5A.
A. B. Goisson
Christ White 106.0 A. Barnes & Tull
C.B.C. 38.48 A.
DEED # 176 3/24/17 B
N. Lambert Est. 83 Perches
Adam Lieb
Philomena Lieb
Geo. Fresh 2.00 A.
Philomena Lieb
Casper Lieb 165.28 A
Casper Lieb C.B.C. Corpn.
Gray & Wyland C.B.C. Corpn.
Anthony Liebolt C.B.C. Corpn.
J.G.C. Bearer
Wm. Davis 79.38 A.
DEED # 189 11/21/31 B
J.G.C. Bearer 21.19A.
DEED # 180 11/6/18 B
Leased to C.B.C. 14.98 A.
Date of last survey ------ Dec. 1917
Oct. 1918
Oct. 1918
Nov. 1920
Oct. 1921
Oct. 1922
Nov. 1923
Sept. 1924
Sept. 1926
Jan. 1927
Nov. 1927
Dec. 1928
Dec. 1929
Dec. 1930 Feb. 1931
Dec. 1931
Dec. 1932
Nov. 1933
Oct. 1934
Oct. & Nov. 1935
Oct. 1936
Nov. 1937
Dec. 1938
Dec. 1939
Nov. 1940
Dec. 1941
JAN. 1942
INDEX 1B
MAP OF
COAL LANDS
IN
BARR TOWNSHIP CAMBRIA CO., PA.
SHOWING "B" MINE WORKINGS
OWNED BY
THE BLUBAKER COAL COMPANY
SCALE-1"=400'
COLOR SCHEME
LEASED TO BARNES COAL COMPANY ------ YELLOW
" " ------ RED
" " C.B.C. CORPN. ------ BROWN