


CARDIFF COAL CO

CARDIFF COAL CO
SURFACE DIV.

COLOR KEY:-

- TRANSIT LINES —————
- OLD WORKINGS CAVED (dashed line)
- PILLARS DRAWN ———— (hatched area)
- COAL MINED ———— (solid black area)

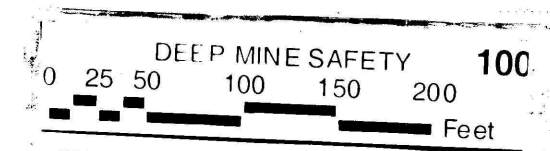

WARREN COLLIERIES

2 CARDIFF NO. 6 MINE

NANTY-GLO PA.

SCALE 1" = 100'

DEC 31 1919