


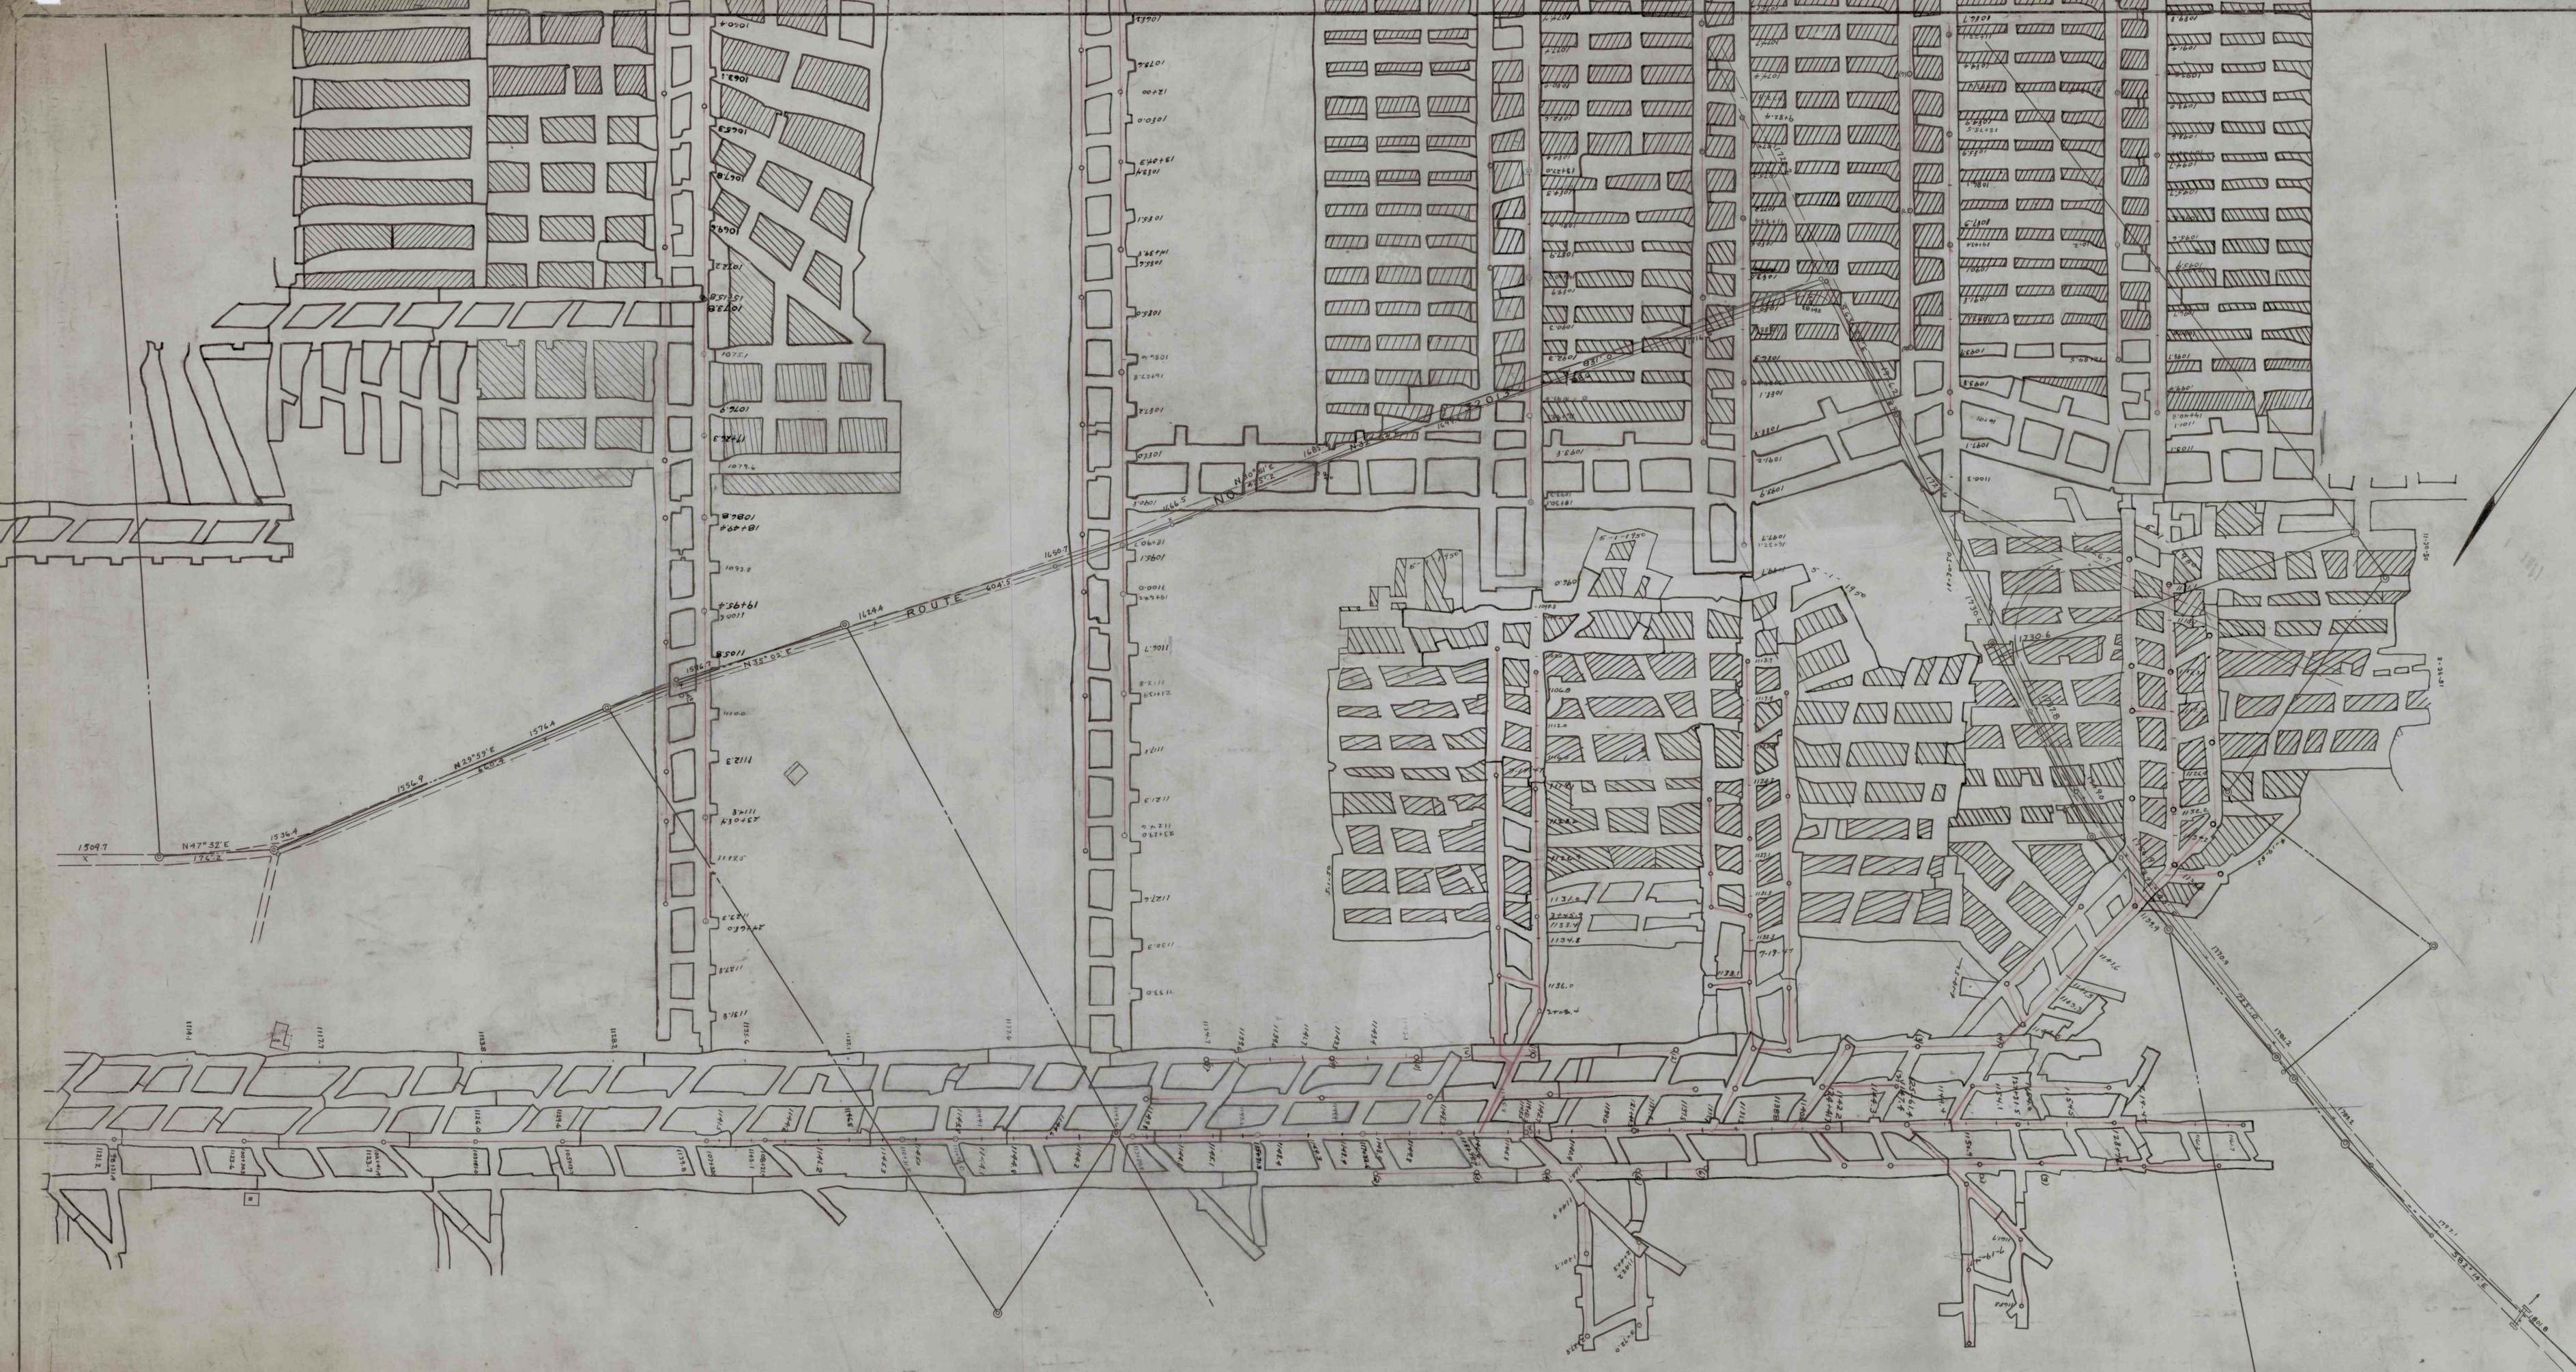

ROUTE N°

OWNER OF MINERAL

DIAMOND SMOKELESS COAL CO.

JOHNSTOWN BANK & TRUST BLDG.

JOHNSTOWN, PA.

OPERATING COMPANY

IMPERIAL COAL CORPORATION

JOHNSTOWN BANK & TRUST BLDG.

JOHNSTOWN, PA.

MINE OFFICE: BOLTZ, PA.

MINING ENGINEERS:

FETTERMAN ENG. CO.

JOHNSTOWN BANK & TRUST BLDG.

JOHNSTOWN, PA.

SCALE = 1" = 100'

MARKERS:

○ ON TELEGRAPH POLE

UNIMPROVED ROADS- YELLOW

IMPROVED ROADS- RED